


GR 2088 - Groundwater Registration Modification - FROM

Township 8S, Range 3W, W.M.

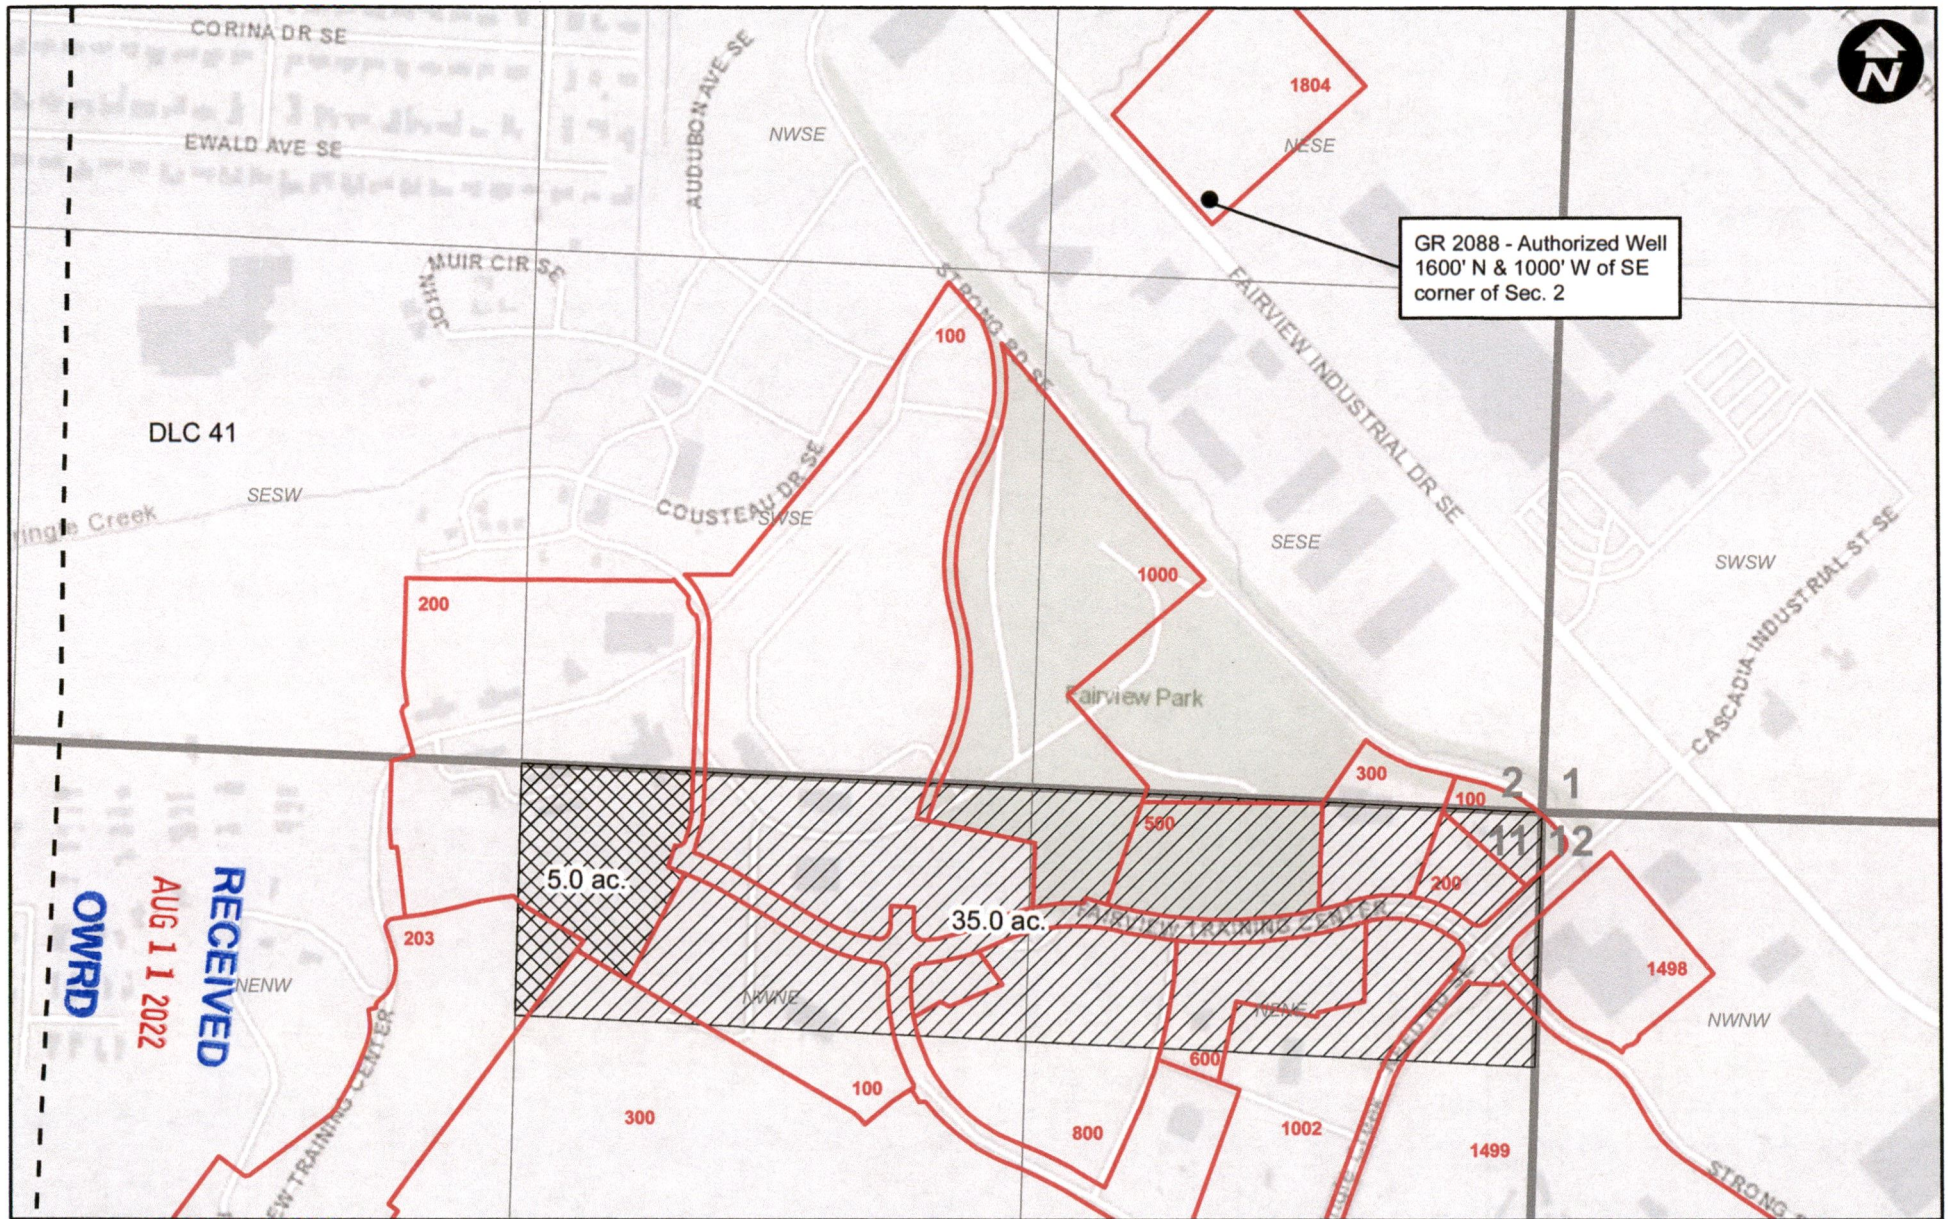


GR 2088 - Authorized Well
1600' N & 1000' W of SE
corner of Sec. 2

RECEIVED
AUG 11 2022
OWRD


Legend

- GR 2088 FROM
- GR 2088 No Change
- Tax Lots
- DLC

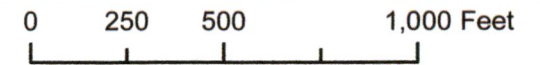

GR 2088 - Groundwater Registration Modification - TO

Township 8S, Range 3W, W.M.

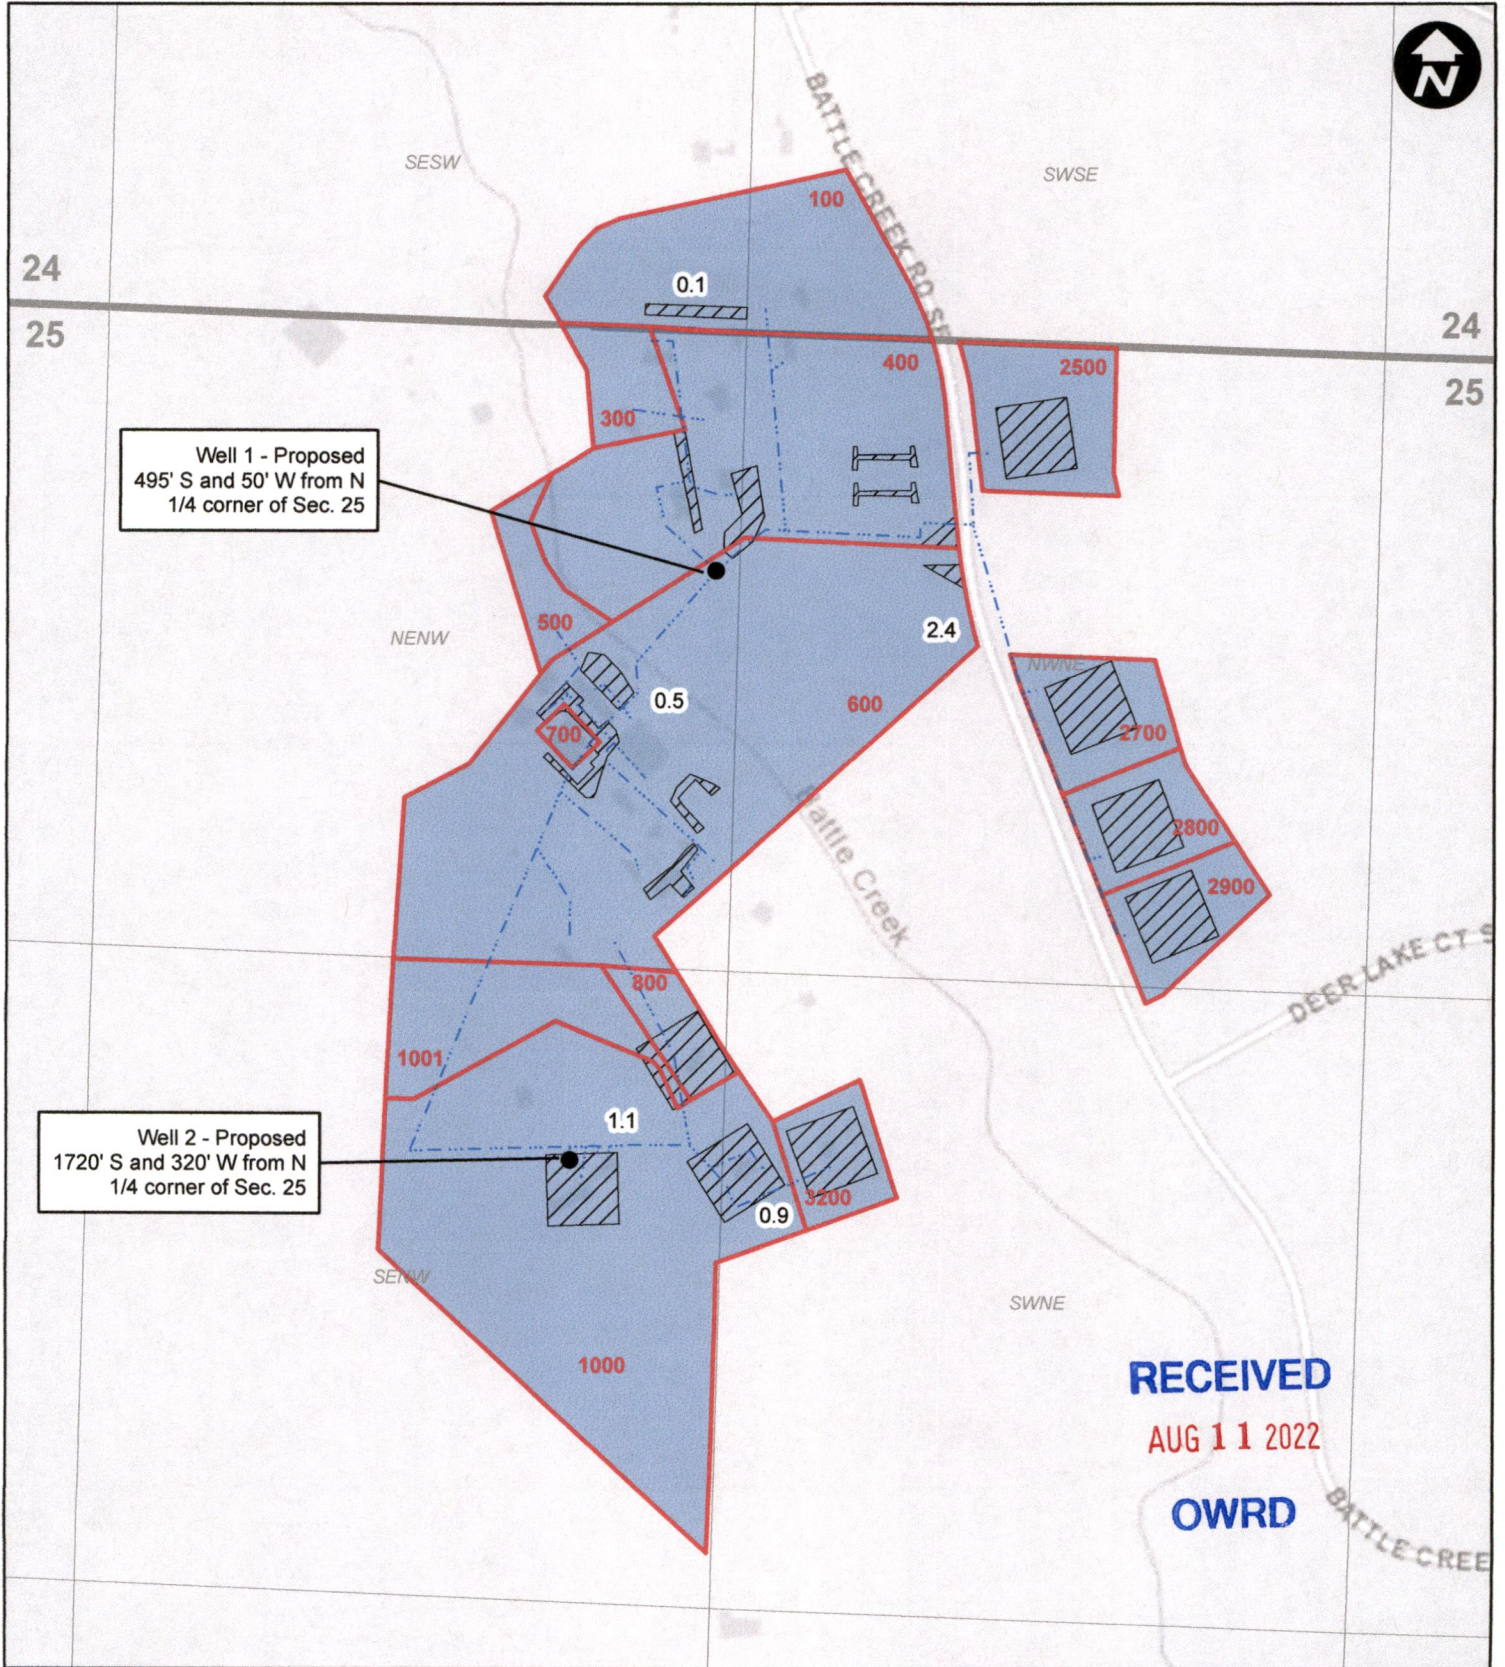


Legend

- Irrigation POU
- Group Domestic POU
- Water Lines
- Tax Lots





0 200 400 800 Feet

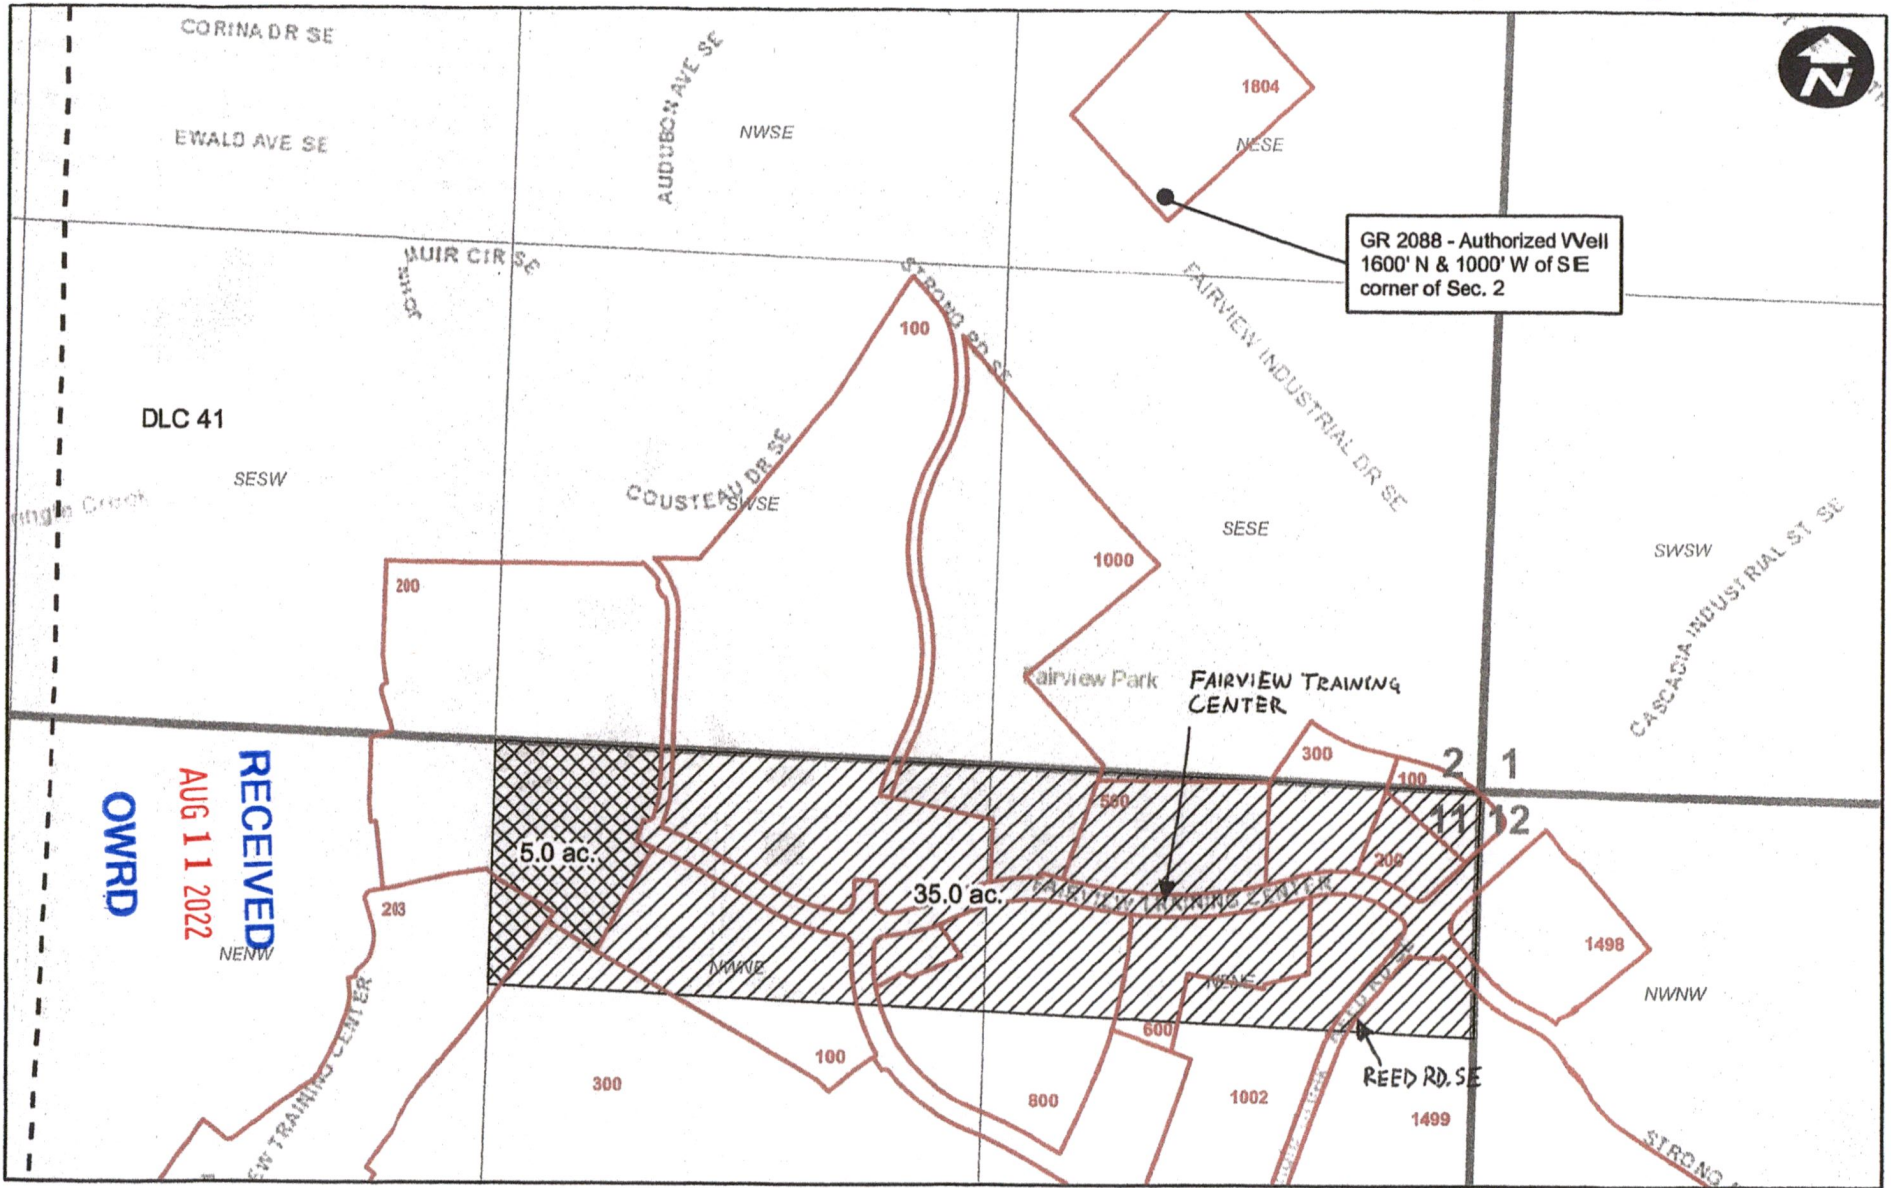GR 2088 - Groundwater Registration Modification - FROM

Township 8S, Range 3W, W.M.



Legend

-  GR 2088 FROM
-  GR 2088 No Change
-  Tax Lots
-  DLC

