

**Groundwater Registration Modification  
for GR-1598 for Andrews Holdings**

T6N, R35E, W.M.  
Section 34, SW 1/4  
Umatilla County, Oregon

**Legend**



- Authorized Well
- ⊕ New Well
- Property Boundary Line
- ▨ Irrigated Area

**Well Location**

**New Well**  
Located 487 feet West and 1,093 feet South from the center of Section 34 T6N R35E, W.M.

**Authorized Well**  
Located 487 feet West and 992 feet South from the center of Section 34 T6N R35E, W.M.

**Certified Water Examiner Stamp**

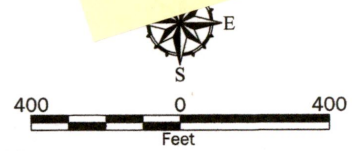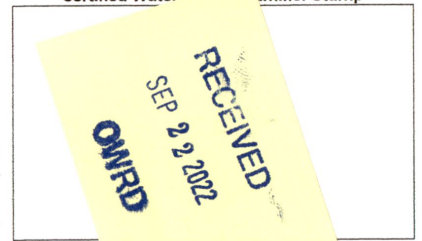

**Disclaimer**

This map was prepared for the purpose of identifying the location of a water right only and it is not intended to provide legal dimensions or location of property ownership lines.

**Map Notes**

Date: 9/9/22  
Data Sources: ESRI  
Prepared By: GeoEngineers

