


Bielenberg WR App

1" = 1320'

Tax Lot:

Township 5 South, Range 1 East, Section 25 & 36, Tax Lot 1600 & 300 + 100

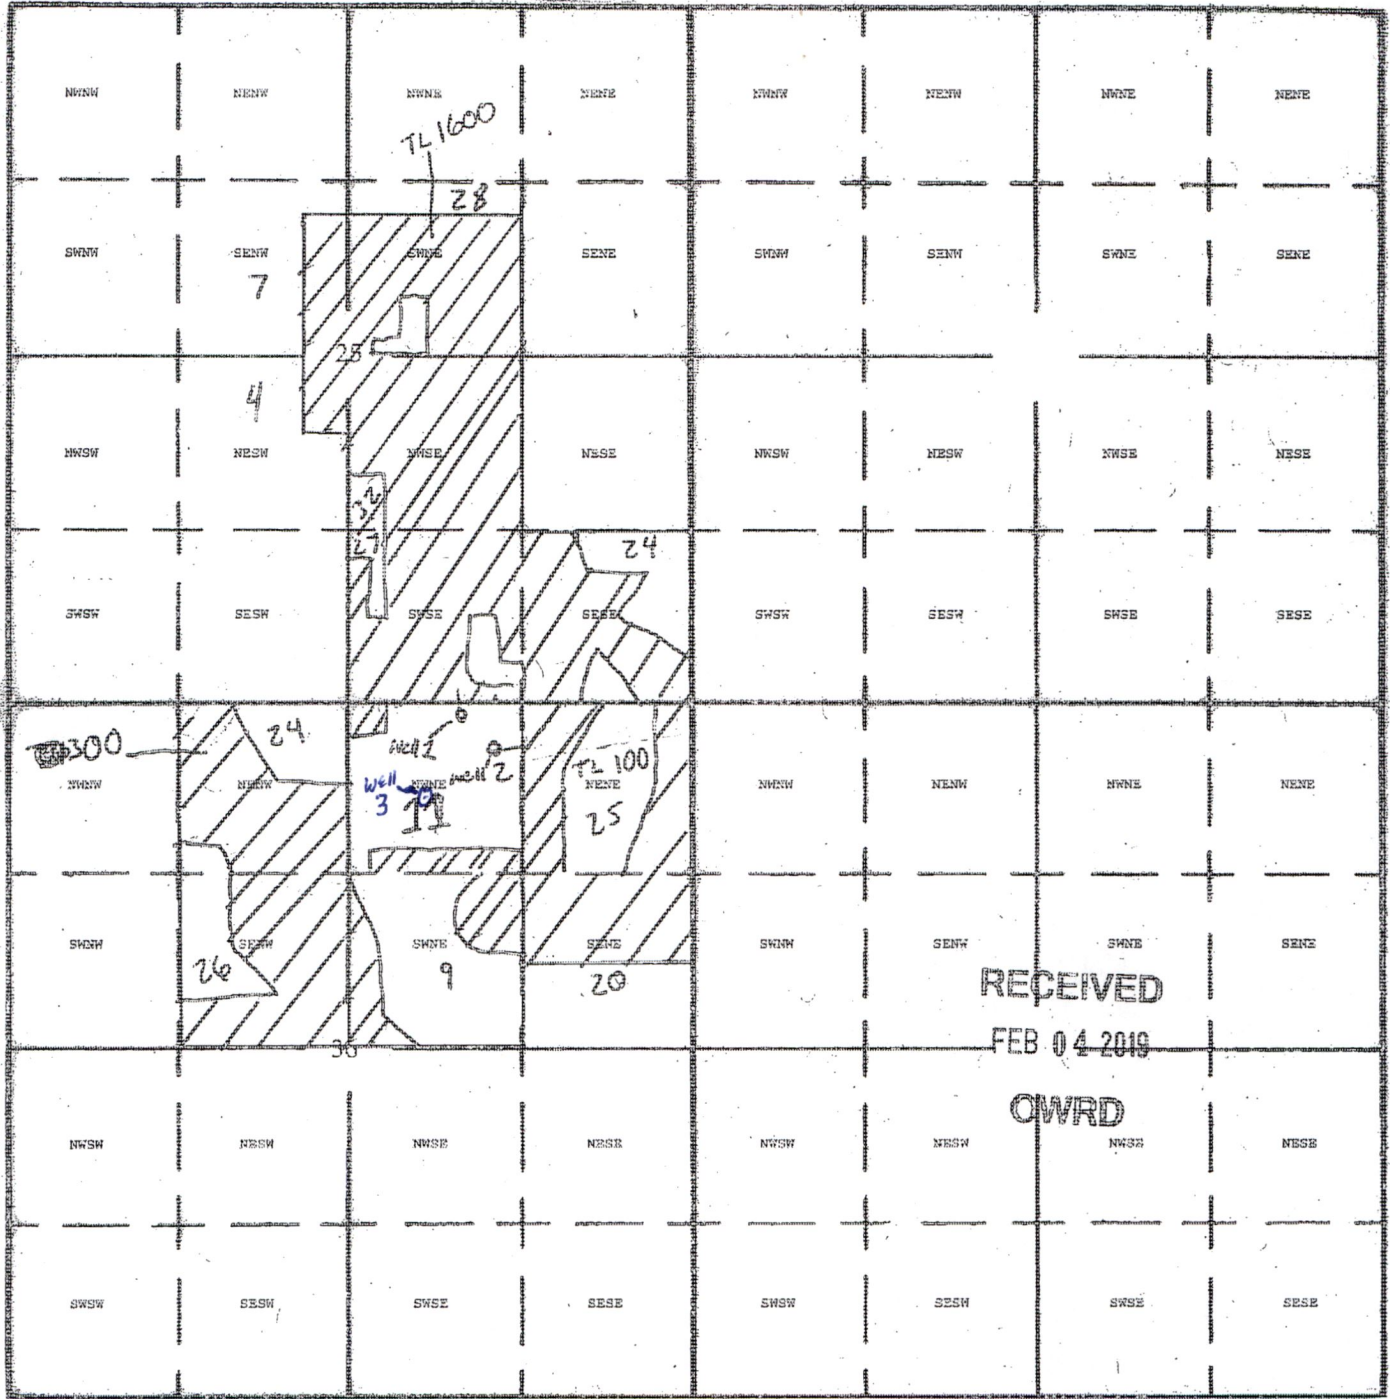

RECEIVED
FEB 04 2019

OWRD

South

Well 1: 70 South + 1800 West NE Corner Sec 30
Well 2: 340 South + 1500 West NE Corner Sec 30

||||| - 237 acres

Don/Bert 1/31/2019

G-18787


14130

Bielenberg WR App

1" = 1320'

Tax Lot:

Township 5 South, Range 1 East, Section 25 & 36, Tax Lot 1600 & 300 + 100

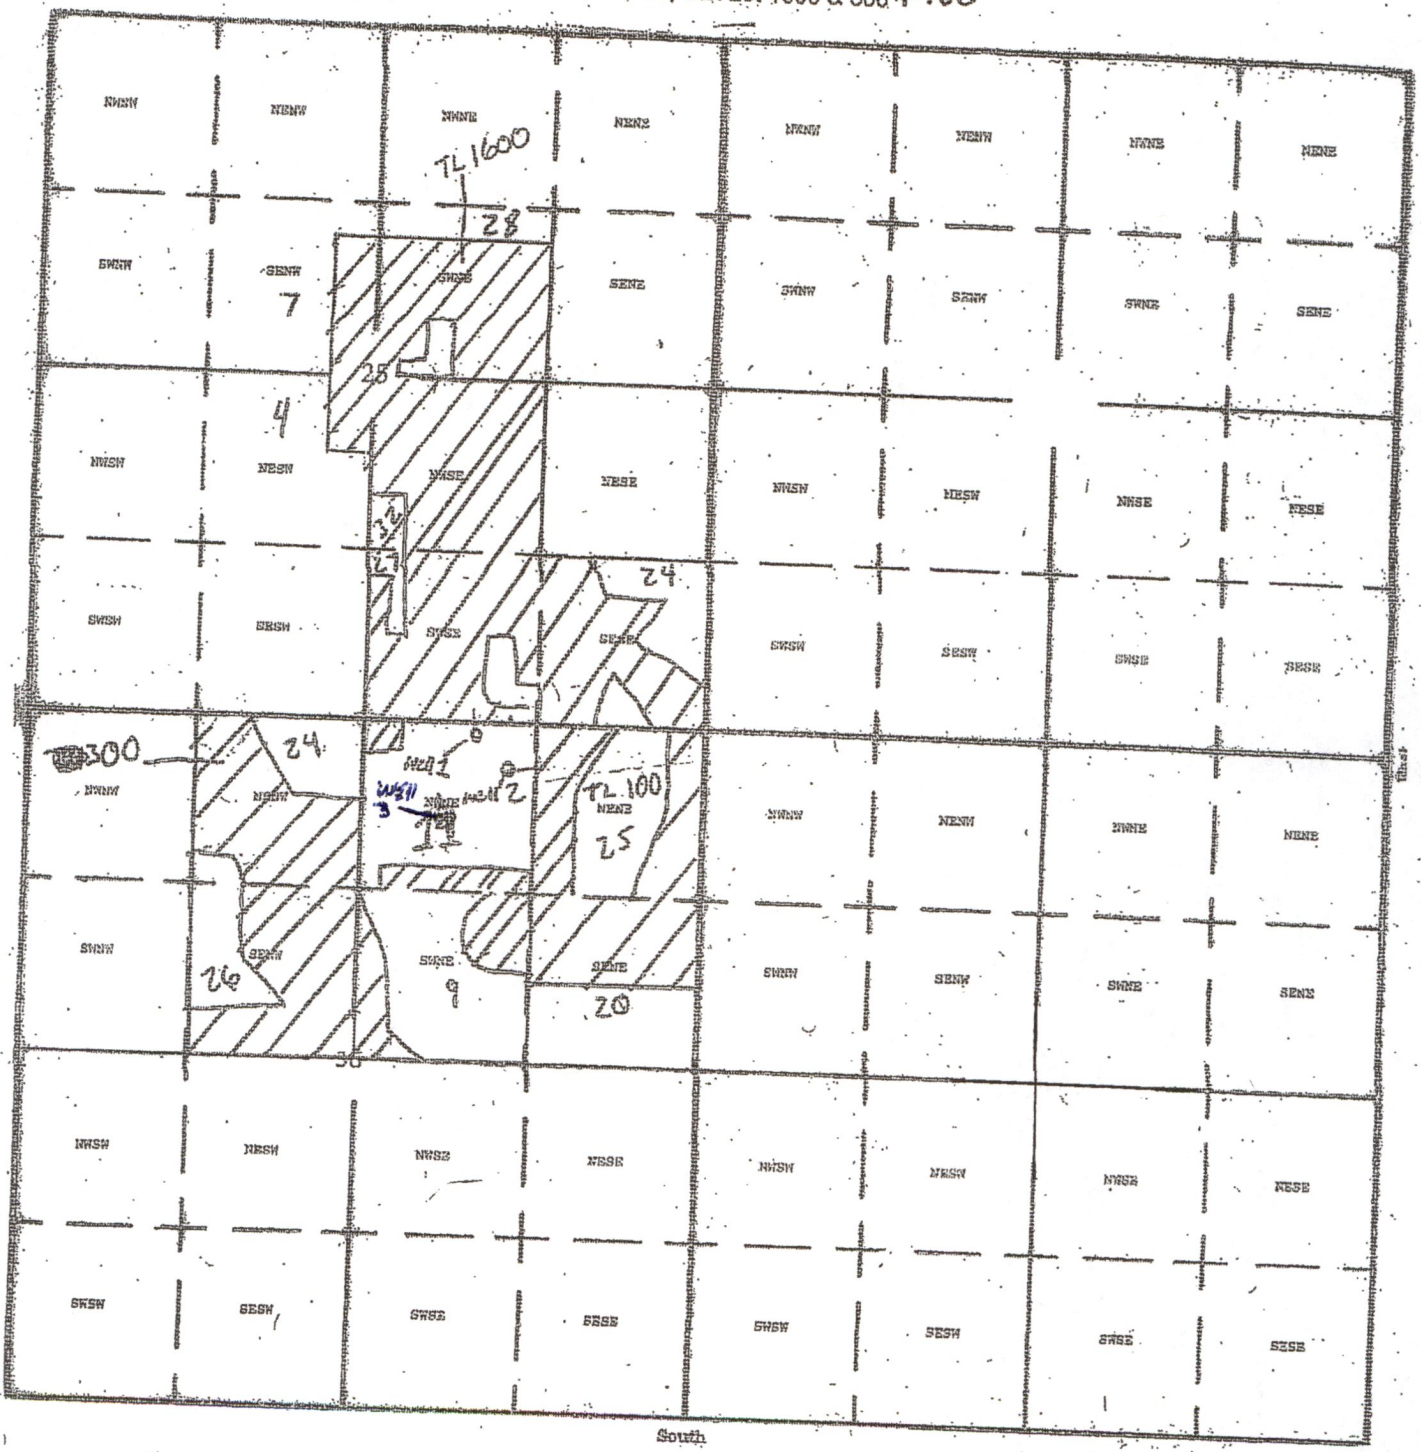

PER Well log

- Well 2 - Well 1: 70' south + 1800' west NE corner sec 30
- Well 1 - Well 2: 340' south + 1500' west NE corner sec 30
- Well 3: 560' south + 2020' west NE corner sec 36

- 237 acres

6-18787

DL/BWT 12/9/2022

14130