


RIDGEVIEW IRRIGATION DISTRICT

Permanent On Transfer Map for Donald S Beebe Certificate 81012

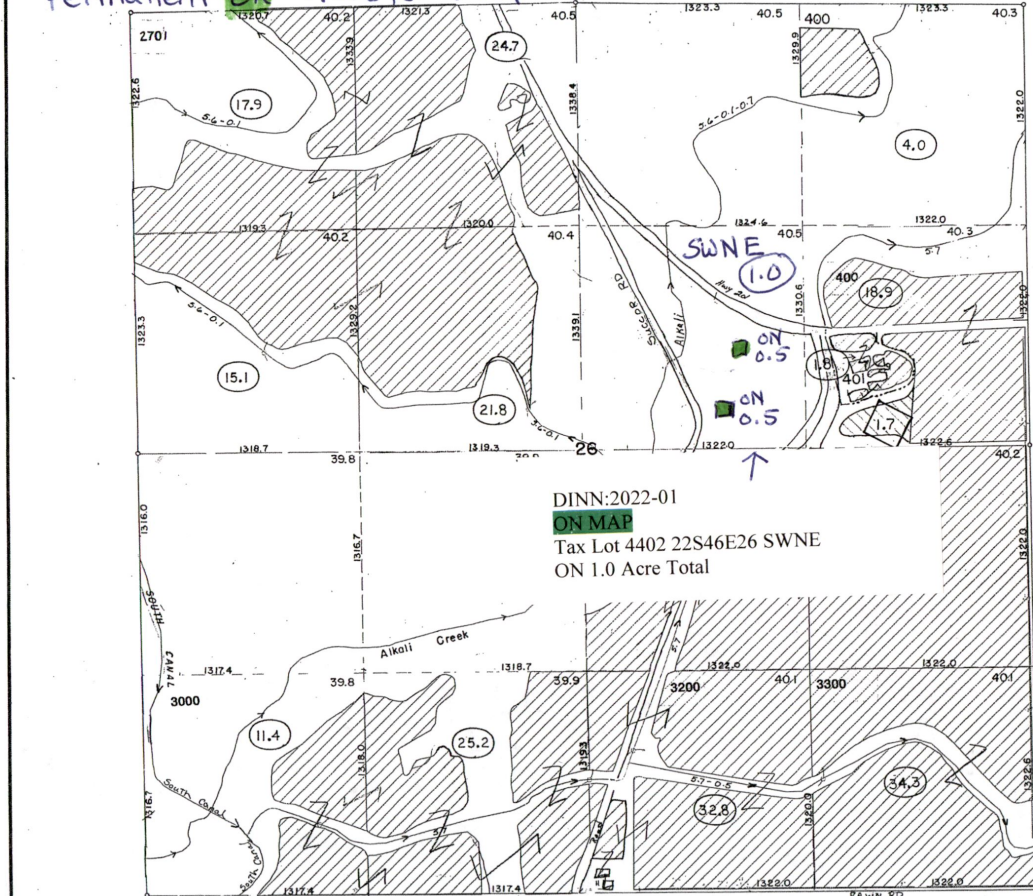

ON Area

RECEIVED
AUG 29 2003
WATER RESOURCES DEPT.
SALEM, OREGON

- ON ACRES IN 1/4, 1/4
- ON ACRES
- PENDING
- Now Approved Irrigated Acres
- PRIVATE ACRES
- PRIVATE ACRES
- PROPERTY LINE OF OTHER TOWN 1/4, 1/4

Donald Beebe
12-29-22

Now Approved
Irrigated
Acres

RECEIVED
JAN 03 2023
OWRD

SEC. 26, T.22 S., R.46 E., W.M. 48-102-1548


Trobed: RWR 4-24-53
Checked: RF 6-20-52

T9533

14140

RIDGEVIEW IRRIGATION DISTRICT

Permanent **OFF** Transfer Map for Donald S. Beebe Certificate 81012

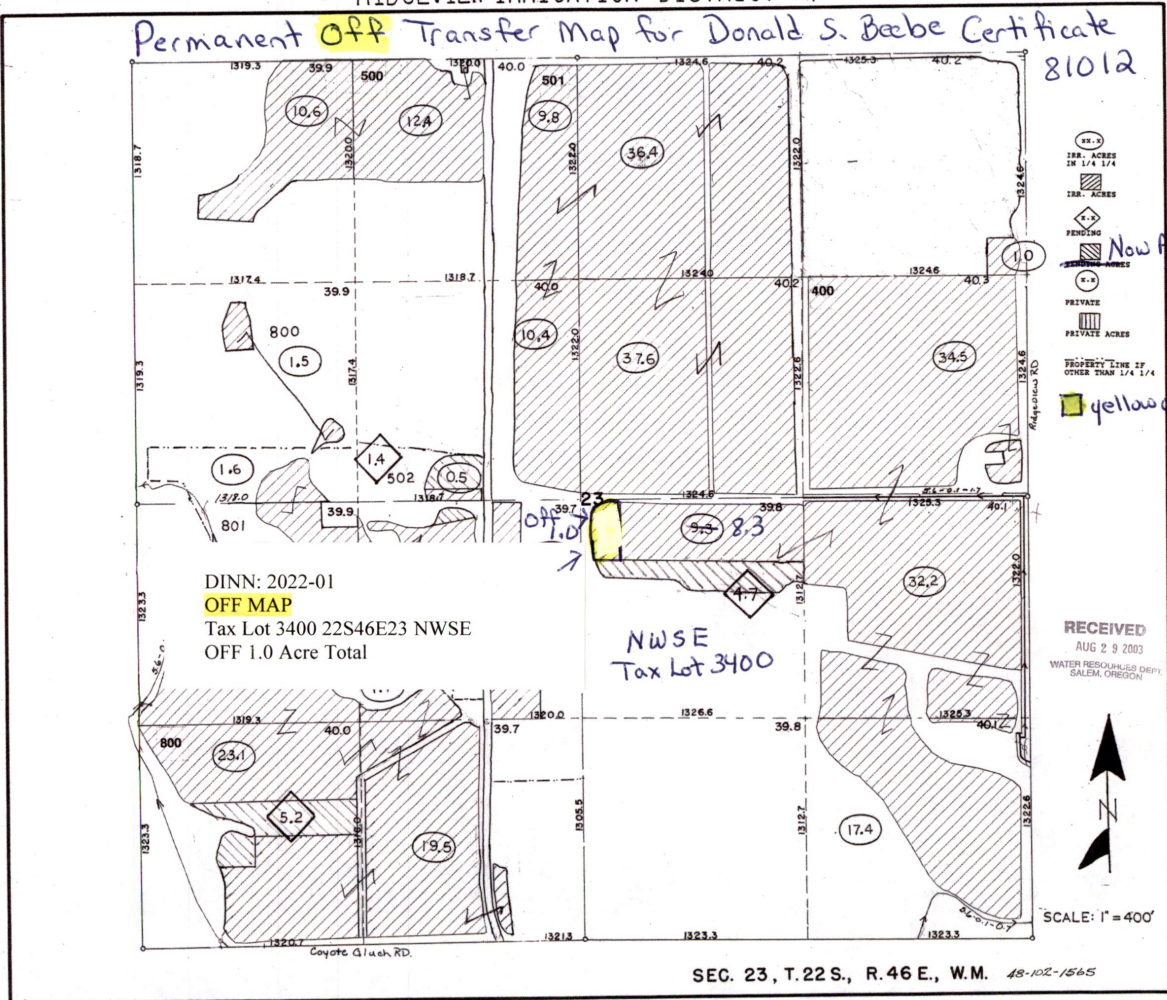

- PENDING
- Now Approved Acres**
- PRIVATE
- PRIVATE ACRES
- PROPERTY LINE OF OTHER THAN 1/4 1/4
- yellow off area**

RECEIVED
AUG 29 2003
WATER RESOURCES DEPT.
SALEM, OREGON



SCALE: 1" = 400'

Donald
Beebe
12-29-22

RECEIVED
JAN 03 2023

OWRD

Traced: RWR 4-22-53
Checked: R.F. 6-20-55

T9533

14140