


Vale Oregon Irrigation District

T 16 R 44 Sec 31

Erstrom, Pat

E-RECEIVED
01/23/2023
OWRD

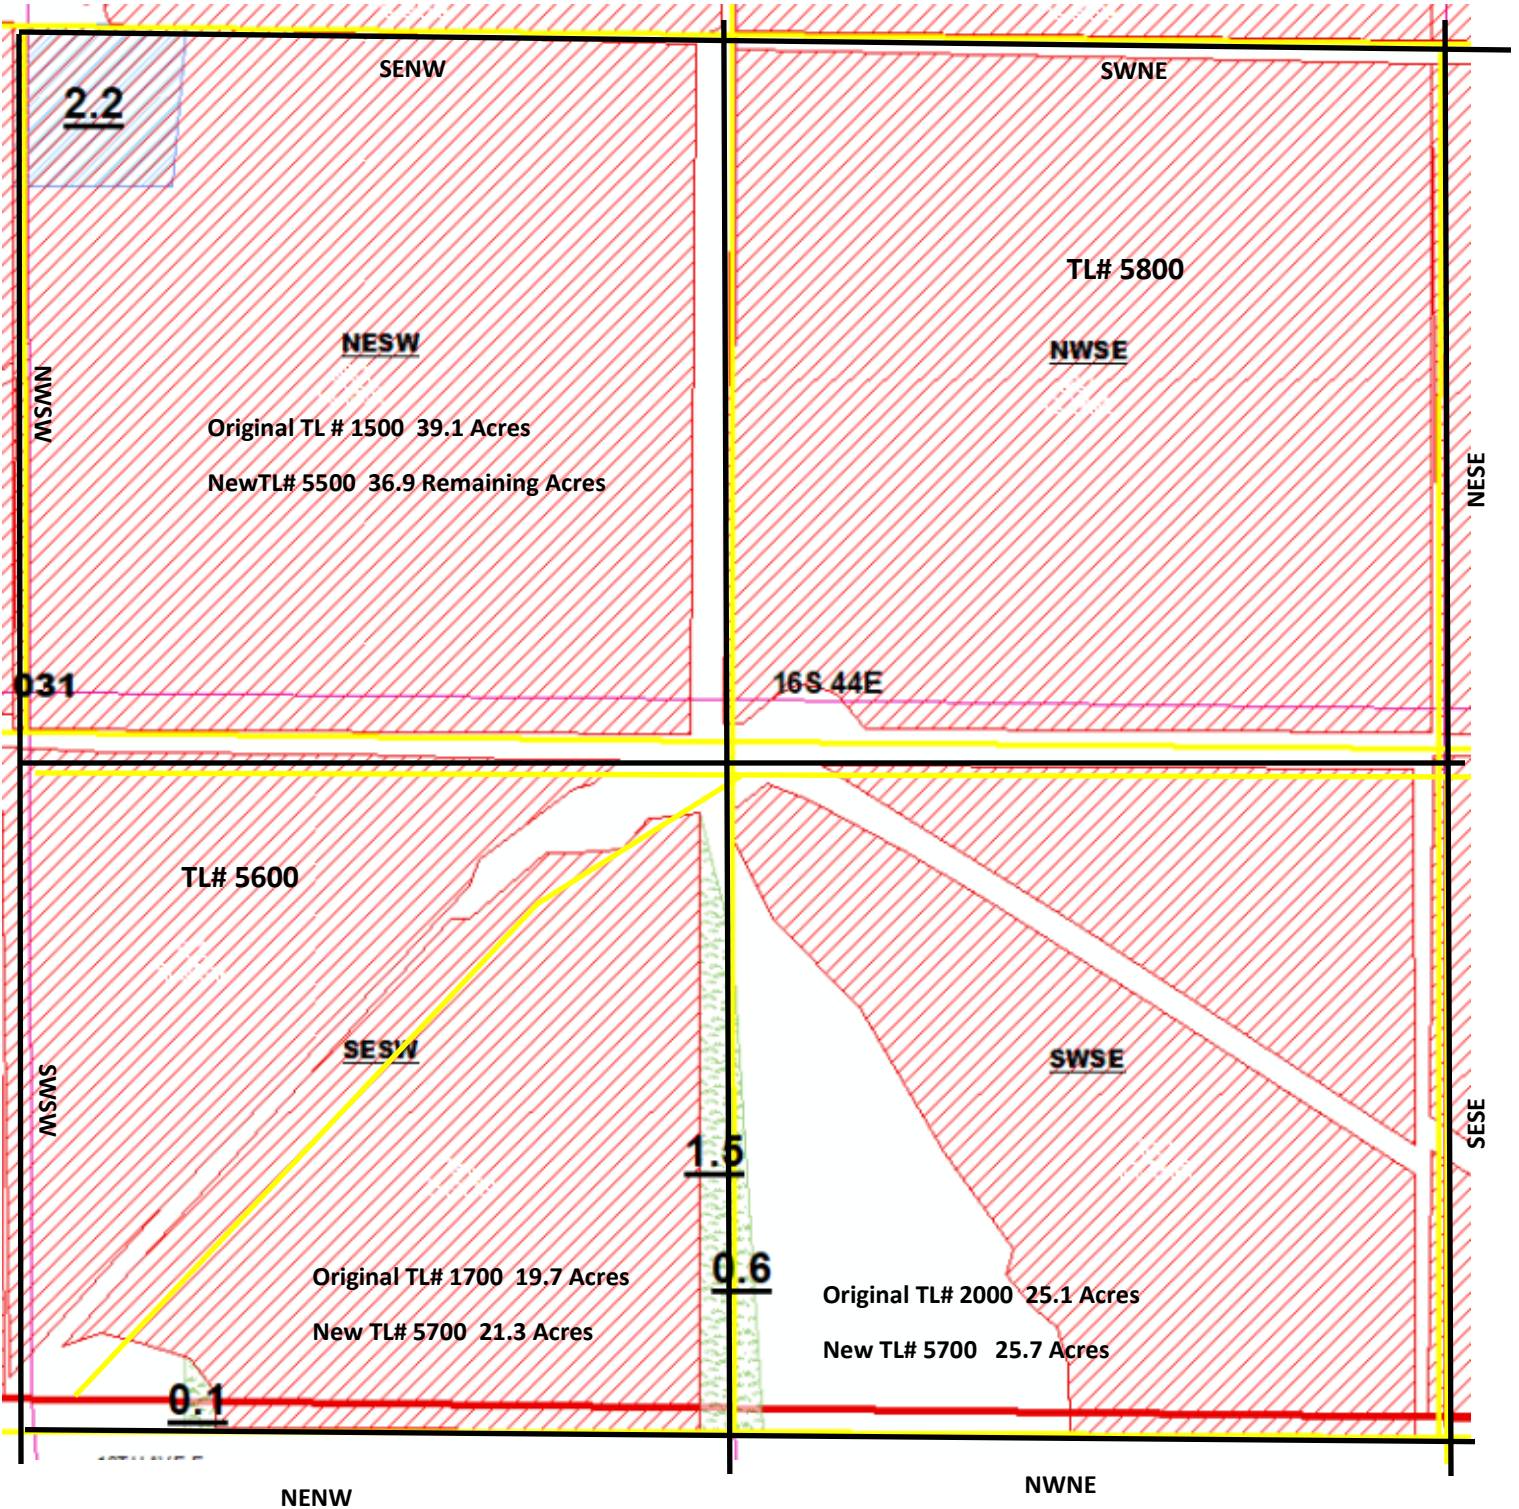

Legend

	PE_Remaining_83.9 Acres
	PE_OFF_ 2.2 Acres TL #5500
	PE_ON_2.2 Acres TL #5700

	On	Off
Certificate: 74080 (IR)	2.2 ac	2.2 ac
74081 (IS)		