



Claim of Beneficial Use - T13554  
 North Unit Irrigation District  
 2020 - Oct

RECEIVED  
 JUL 21 2022  
 OWRD

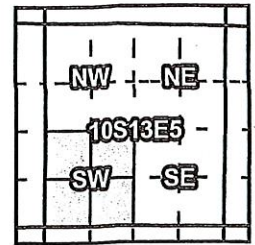

Certificates: 94079 (IR)  
 for Mark J. Hettervig Joint Trust

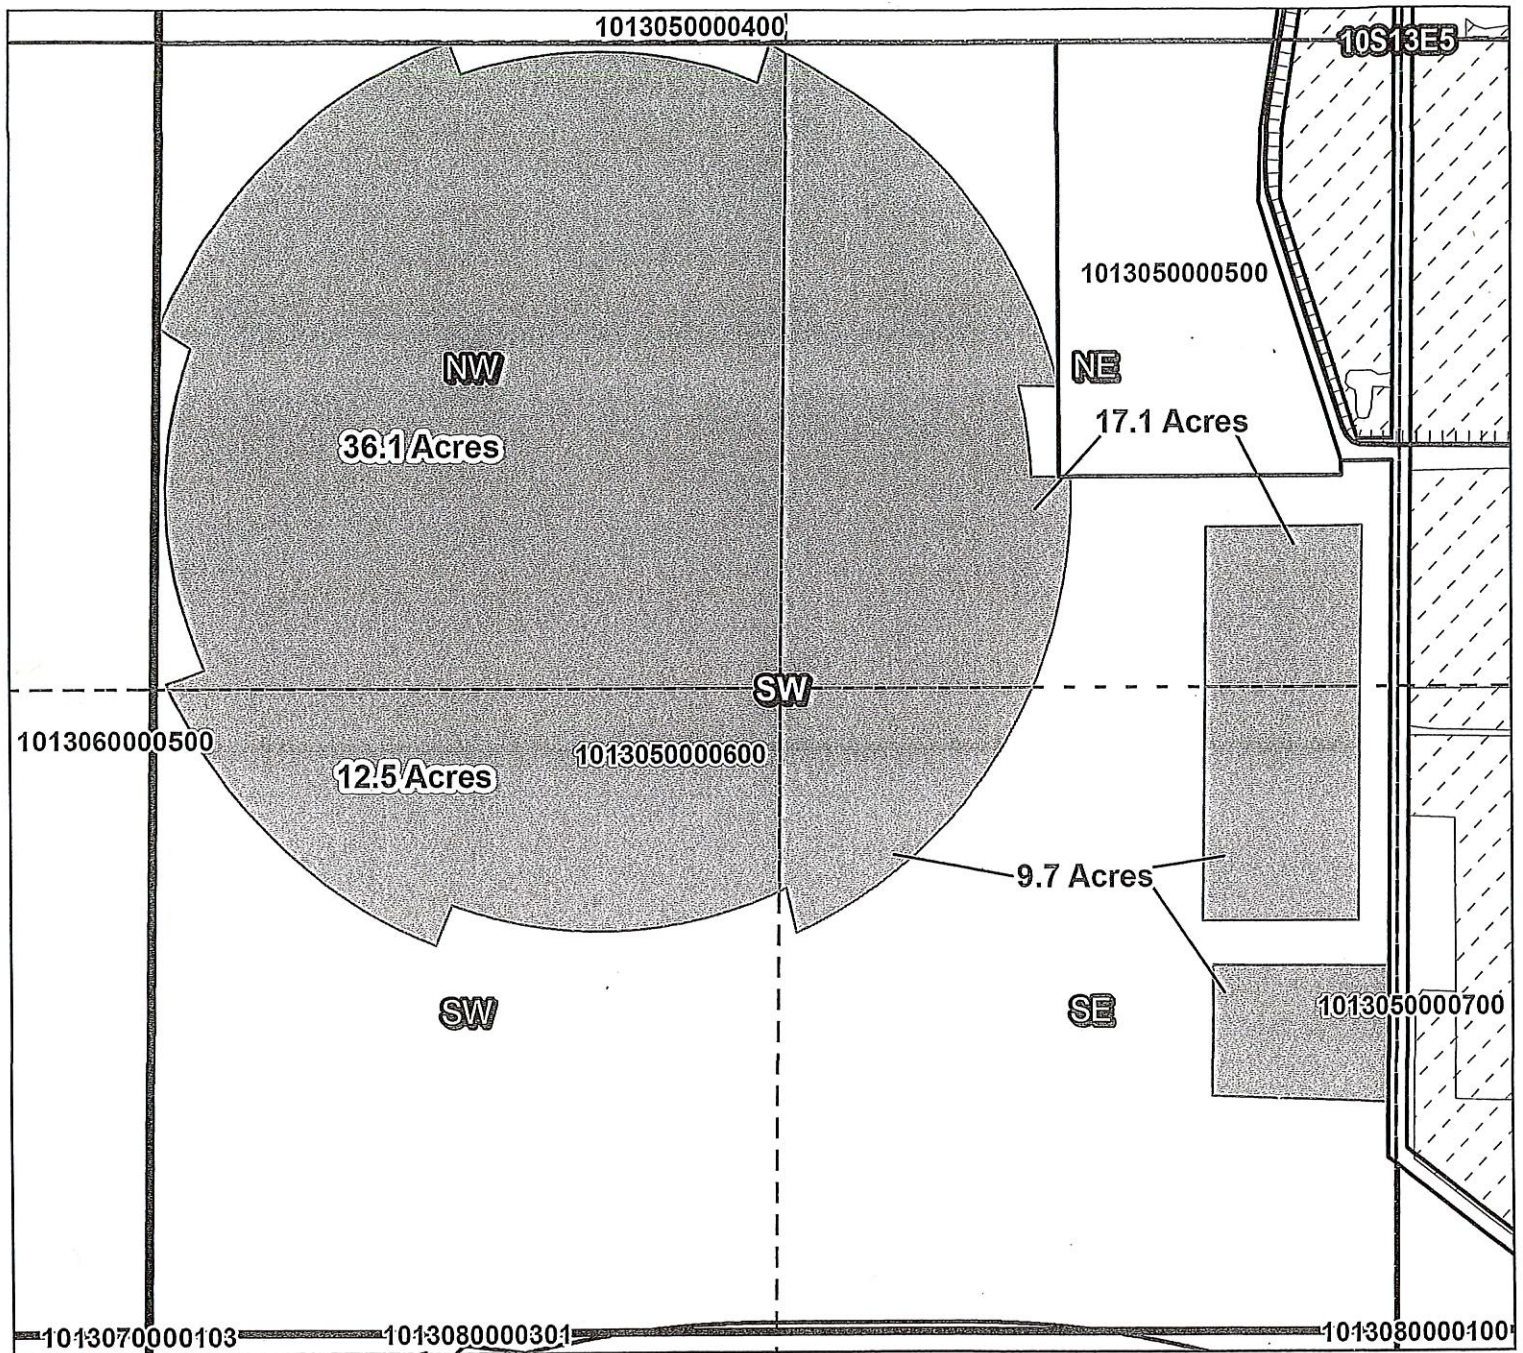

- 1013050000600 NWSW 36.1 Acres 94079 'ON'
- 1013050000600 SWSW 12.5 Acres 94079 'ON'
- 1013050000600 NESW 17.1 Acres 94079 'ON'
- 1013050000600 SESW 9.7 Acres 94079 'ON'

- Canals
- Taxlots
- COBU
- Cert 94079
- All Other Certs

