


Application for a Temporary Water Rights Transfer

In the Name of John Eveland, Gathering Together Farm TO LANDS - Certificate 26244 (Burnworth)

RECEIVED

MAR 03 2023

OWRD

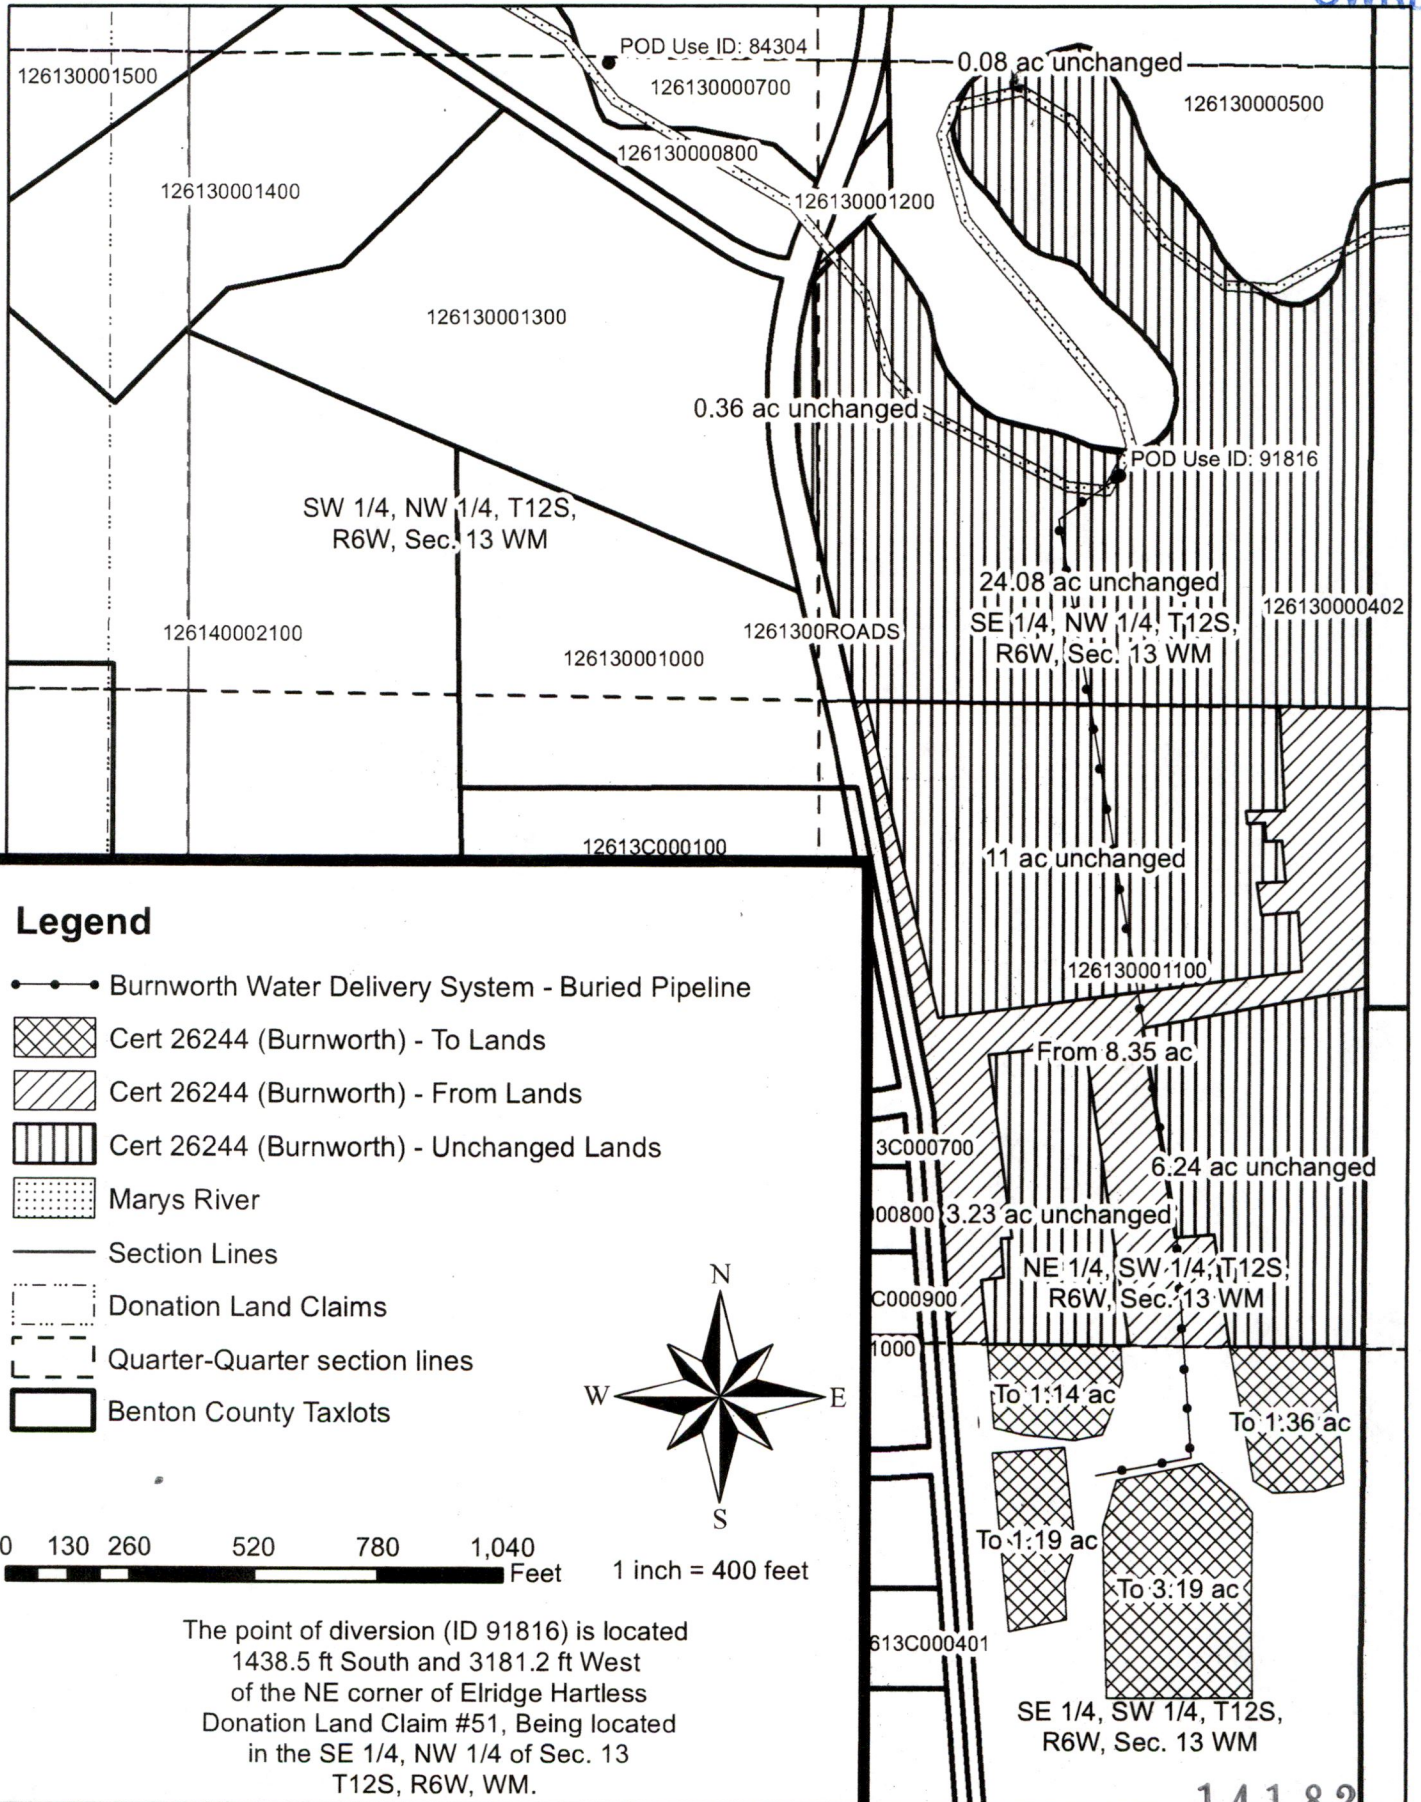

14182

RECEIVED

MAR 03 2023

OWRD

Application for a Temporary Water Rights Transfer

In the Name of John Eveland, Gathering Together Farm - Certificate 24183 (Bevens)

