


Transfer Application - Certificate 57371 - Hurst

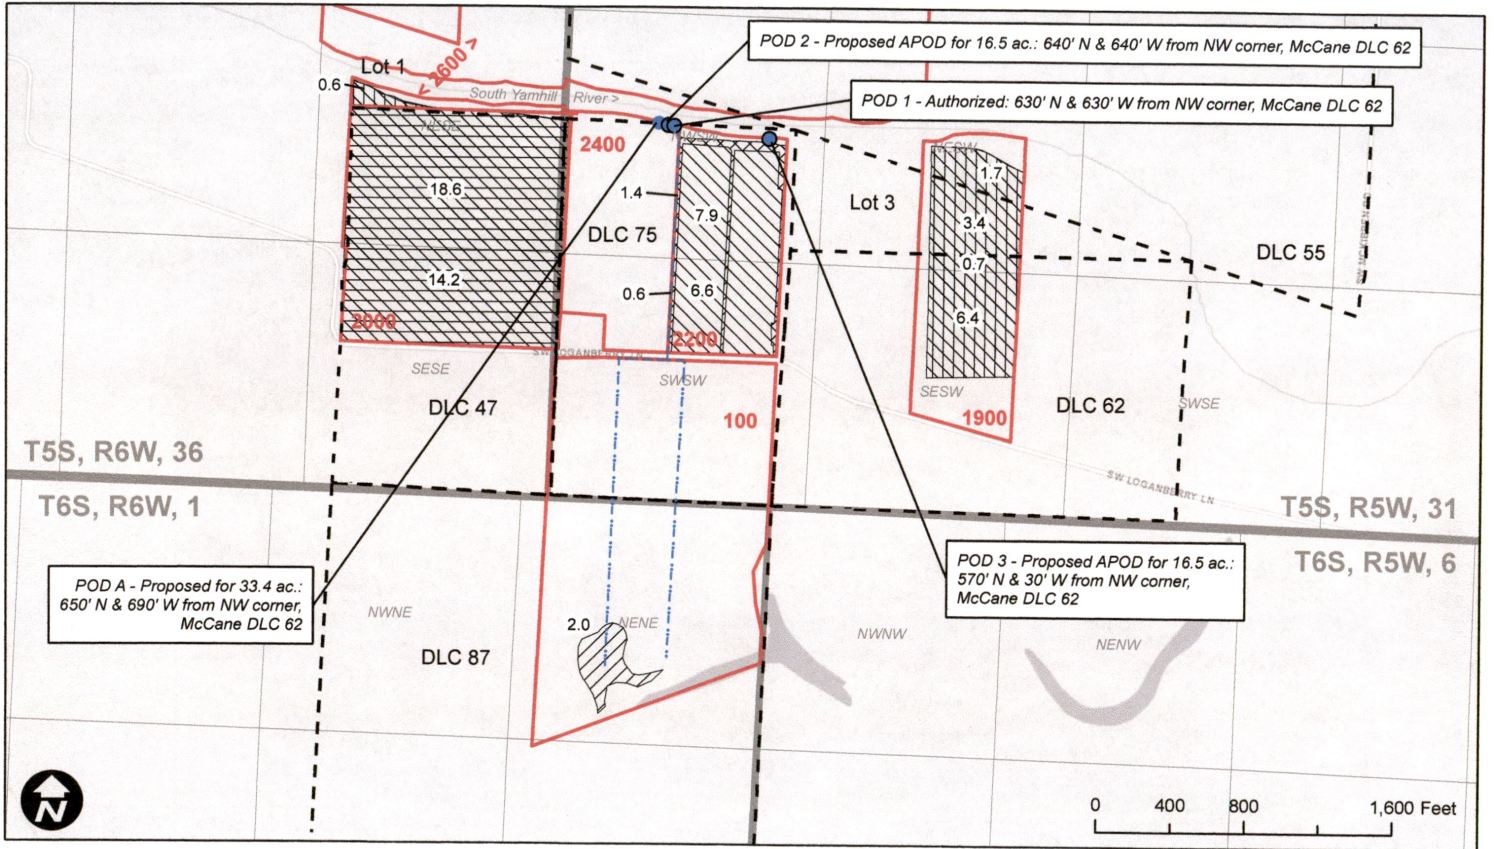

Legend


- Cert. 57371 From POU
- Cert. 57371 POD Change
- Cert. 57371 No Change
- DLC
- Cert. 57371 To POU/APOD Change
- Cert. 57371 APOD Change
- Mainline
- Tax Lot

WILL MCGILL SURVEYING LLC

RECEIVED
MAR 17 2023
OWRD



Transfer Application - Certificate 56862 - Hurst

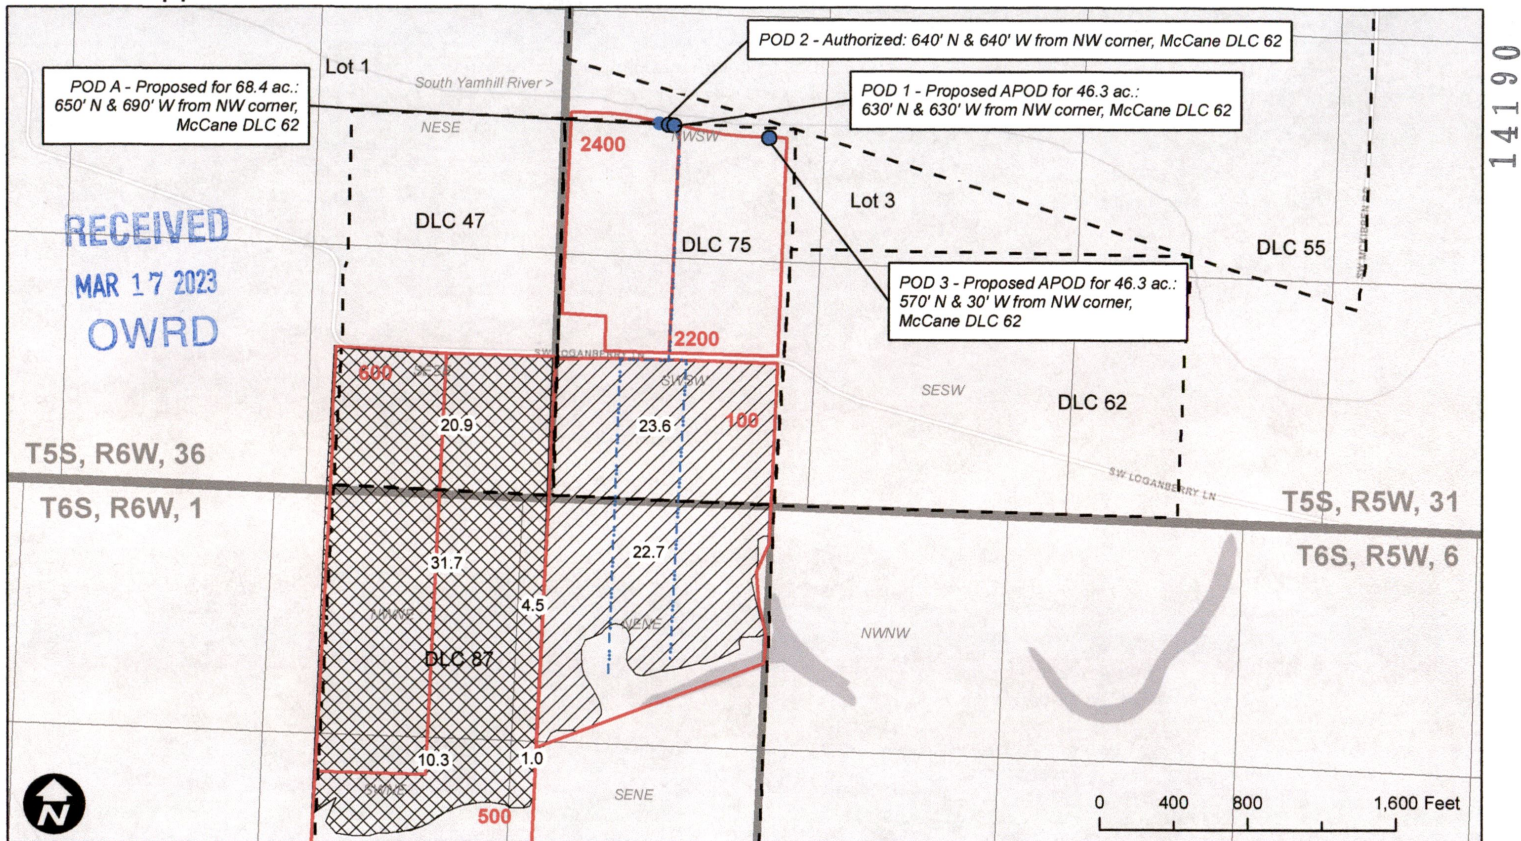


Legend

- Cert. 56862 POD Change
- Mainline
- DLC
- Cert. 56862 APOD Change
- Tax Lot

WILL MCGILL SURVEYING LLC



Transfer Application - Certificate 45979 - Hurst

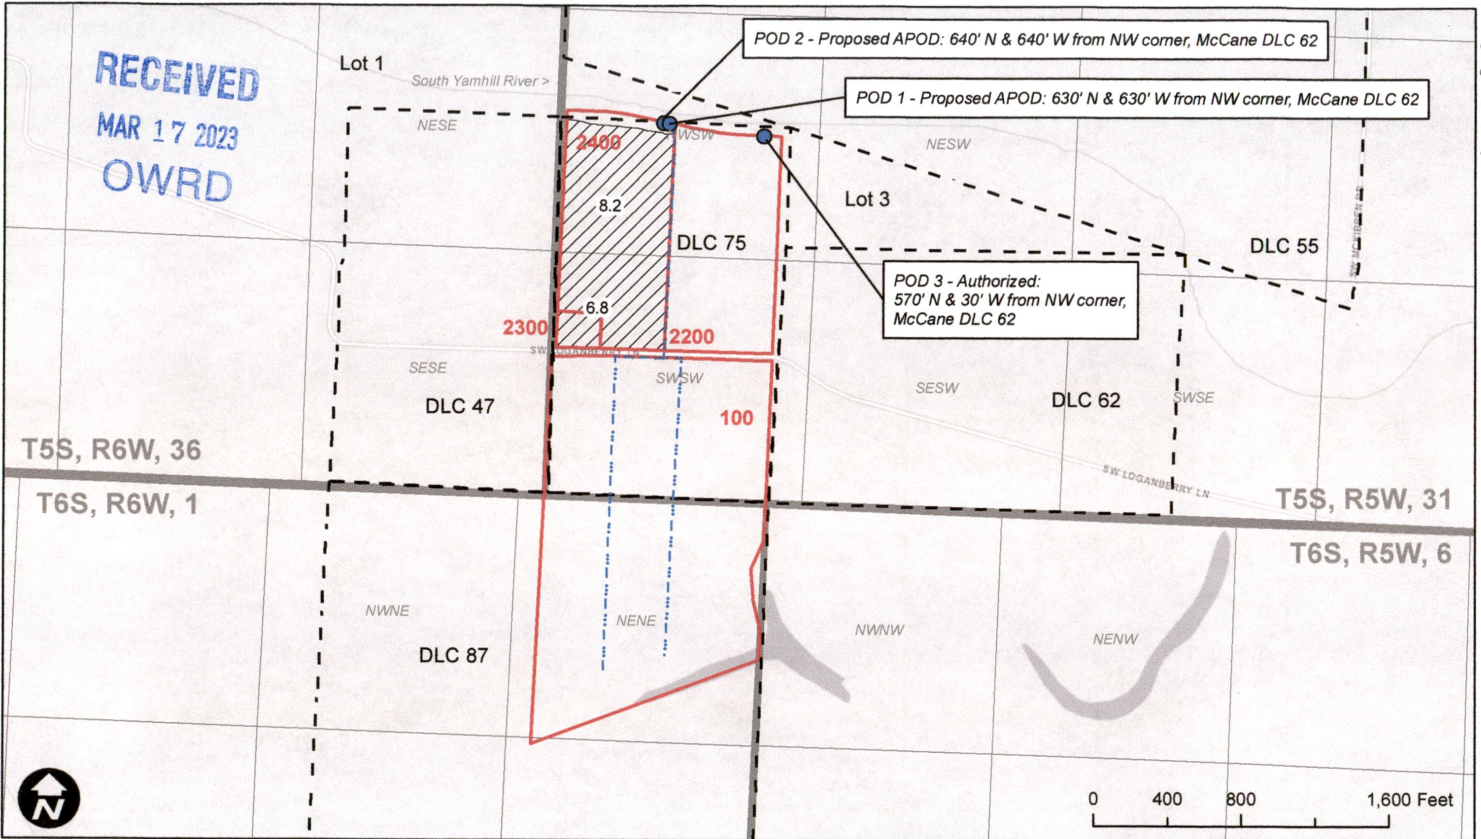

Legend

Cert. 45979 APOD Change
 Mainline
 Tax Lot
 DLC

WILL MCGILL SURVEYING LLC

