


Permanent Transfer for Del Strubhar - 2023 Ground Water C 65236 POU

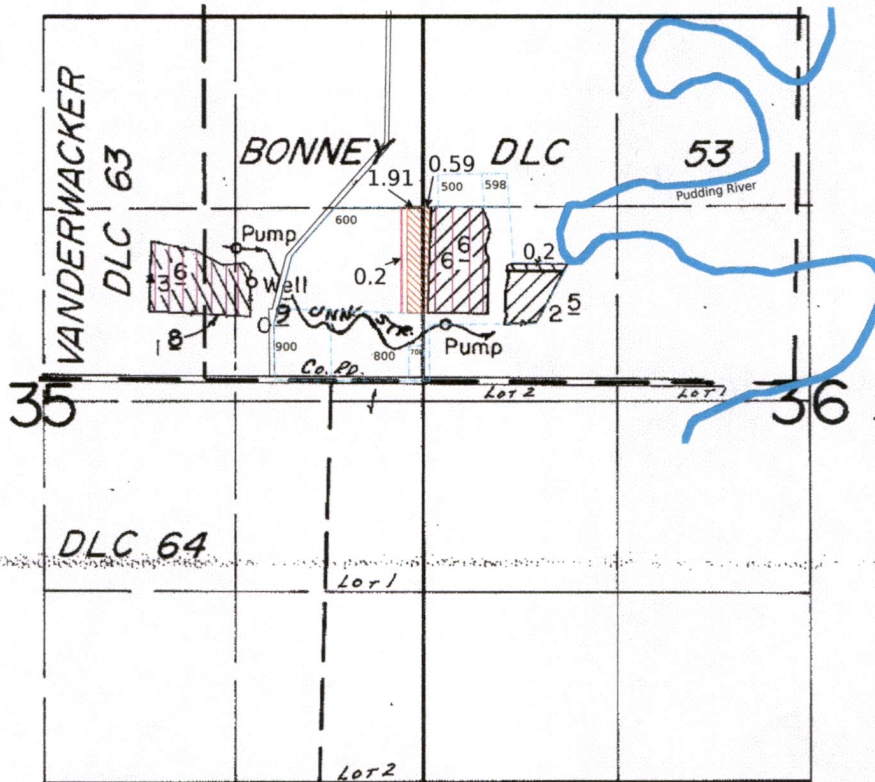



T. 4S., R. 1W., W.M.

EXPIRES: 2023.12.31





Legend

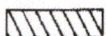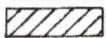FROM

-  PRIMARY
-  SUPPLEMENTAL

TO

-  Primary
-  Supplemental

Not part of this
Transfer

WELL LOC.: 680' N. & 330' E. FROM SW COR. BONNEY DLC 53.
REDIVERSION: 390' N @ 1680' E; 900' N @ 210' E BOTH
FROM SW COR. DLC 53
SCALE: 1" = 1320'

FINAL PROOF SURVEY UNDER

Application No. G-8357 Permit No. G-7862 C 65236
IN NAME OF

WILLIAM N. STRUBHAR

Surveyed May 8 1984, by B.W. BISHOP

RECEIVED


APR 13 2023

OWRD

PREPARATION OF THIS MAP IS FOR THE PURPOSE OF IDENTIFYING THE LOCATION OF THE WATER RIGHT ONLY. THERE IS NO INTENT TO PROVIDE DIMENSIONS OR LOCATION OF PROPERTY OWNERSHIP LINES.

Permanent Transfer for Del Strubhar - 2023
Surface Water C 47316 and C 44771 POU

T. 4 S., R. 1 W. W.M.

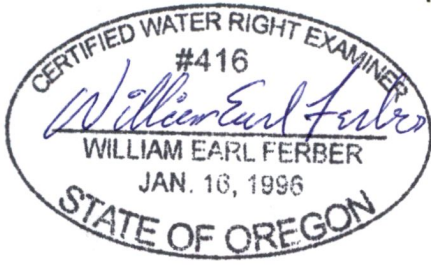

EXPIRES: 2023.12.31
Legend

- FROM Lands
- C 47316
 - C 44771


- TO Lands
- C 47316
 - C 44771

Tax lot boundary

C 42319 POU shown for location reference only. Not part of this transfer.



Scale 1" = 1320'

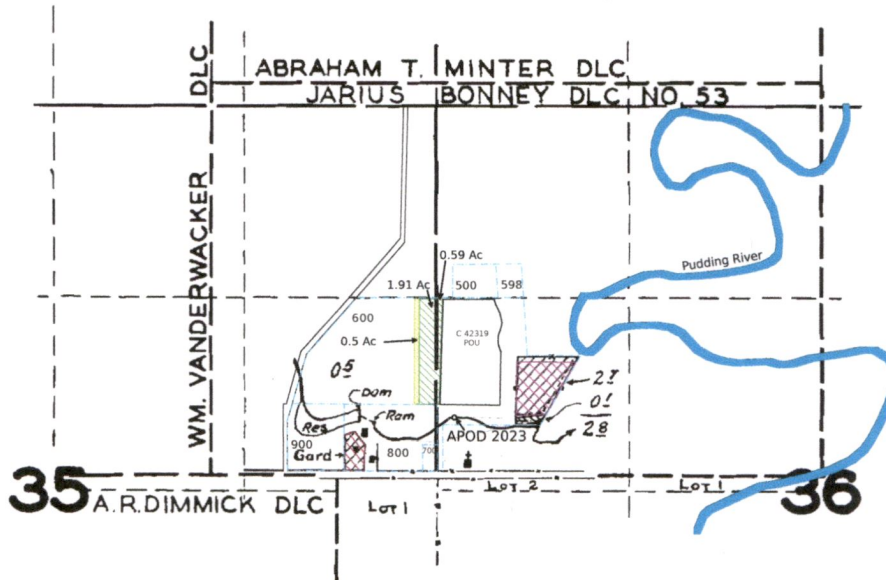

Div: SW1/4 NW1/4, as projected within Bonney DLC 53, Section 36,
T. 4S., R. 1W., W.M., 390 feek North and 1680 feet East from the Sw/W Cortner, Bonney D:LC 53

FINAL PROOF SURVEY
UNDER

Application No. R-19438 / 19439 Permit No. R-769 / 15037

IN NAME OF

C. C. Hepler

Surveyed June 24, 1942, by Geo. D. Adelman

RECEIVED

APR 18 2023

OWRD

PREPARATION OF THIS MAP IS FOR THE PURPOSE OF IDENTIFYING THE LOCATION OF THE WATER RIGHT ONLY. THERE IS NO INTENT TO PROVIDE DIMENSIONS OR LOCATION OF PROPERTY OWNERSHIP LINES.

04 1W 35A

04 1W 35A



MARION COUNTY, OREGON
NE1/4 SEC35 T4S R1W W.M.
SCALE 1" = 200'

LEGEND

- LINE TYPES
- Taxlot Boundary
 - Road Right-of-Way
 - Railroad Right-of-Way
 - Private Road ROW
 - Subdivision/Plat Bndry
 - Waterline - Taxlot Bndry
 - Historical Boundary
 - Easement
 - Railroad Centerline
 - Taxcode Line
 - Map Boundary
 - Waterline - Non Bndry

- CORNER TYPES
- + 1/16TH Section Cor.
 - ⊙ DLC Corner
 - ⊕ 1/4 Section Cor.
 - 16, 15 Section Corner
 - 21 22


NUMBERS
Tax Code Number
00 00 0

Acreeage 0.25 AC All acres listed are Net Acres, excluding any portions of the taxlot within public ROWs

NOTES
Tick Marks: A tick mark in the road indicates that the labeled dimension extends into the public ROW

CANCELLED NUMBERS


DISCLAIMER: THIS MAP WAS PREPARED FOR ASSESSMENT PURPOSES ONLY

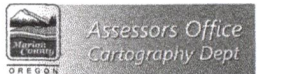

FOR ADDITIONAL MAPS VISIT OUR WEBSITE AT www.co.marion.or.us

PLOT DATE: 10/16/2020

04 1W 35A

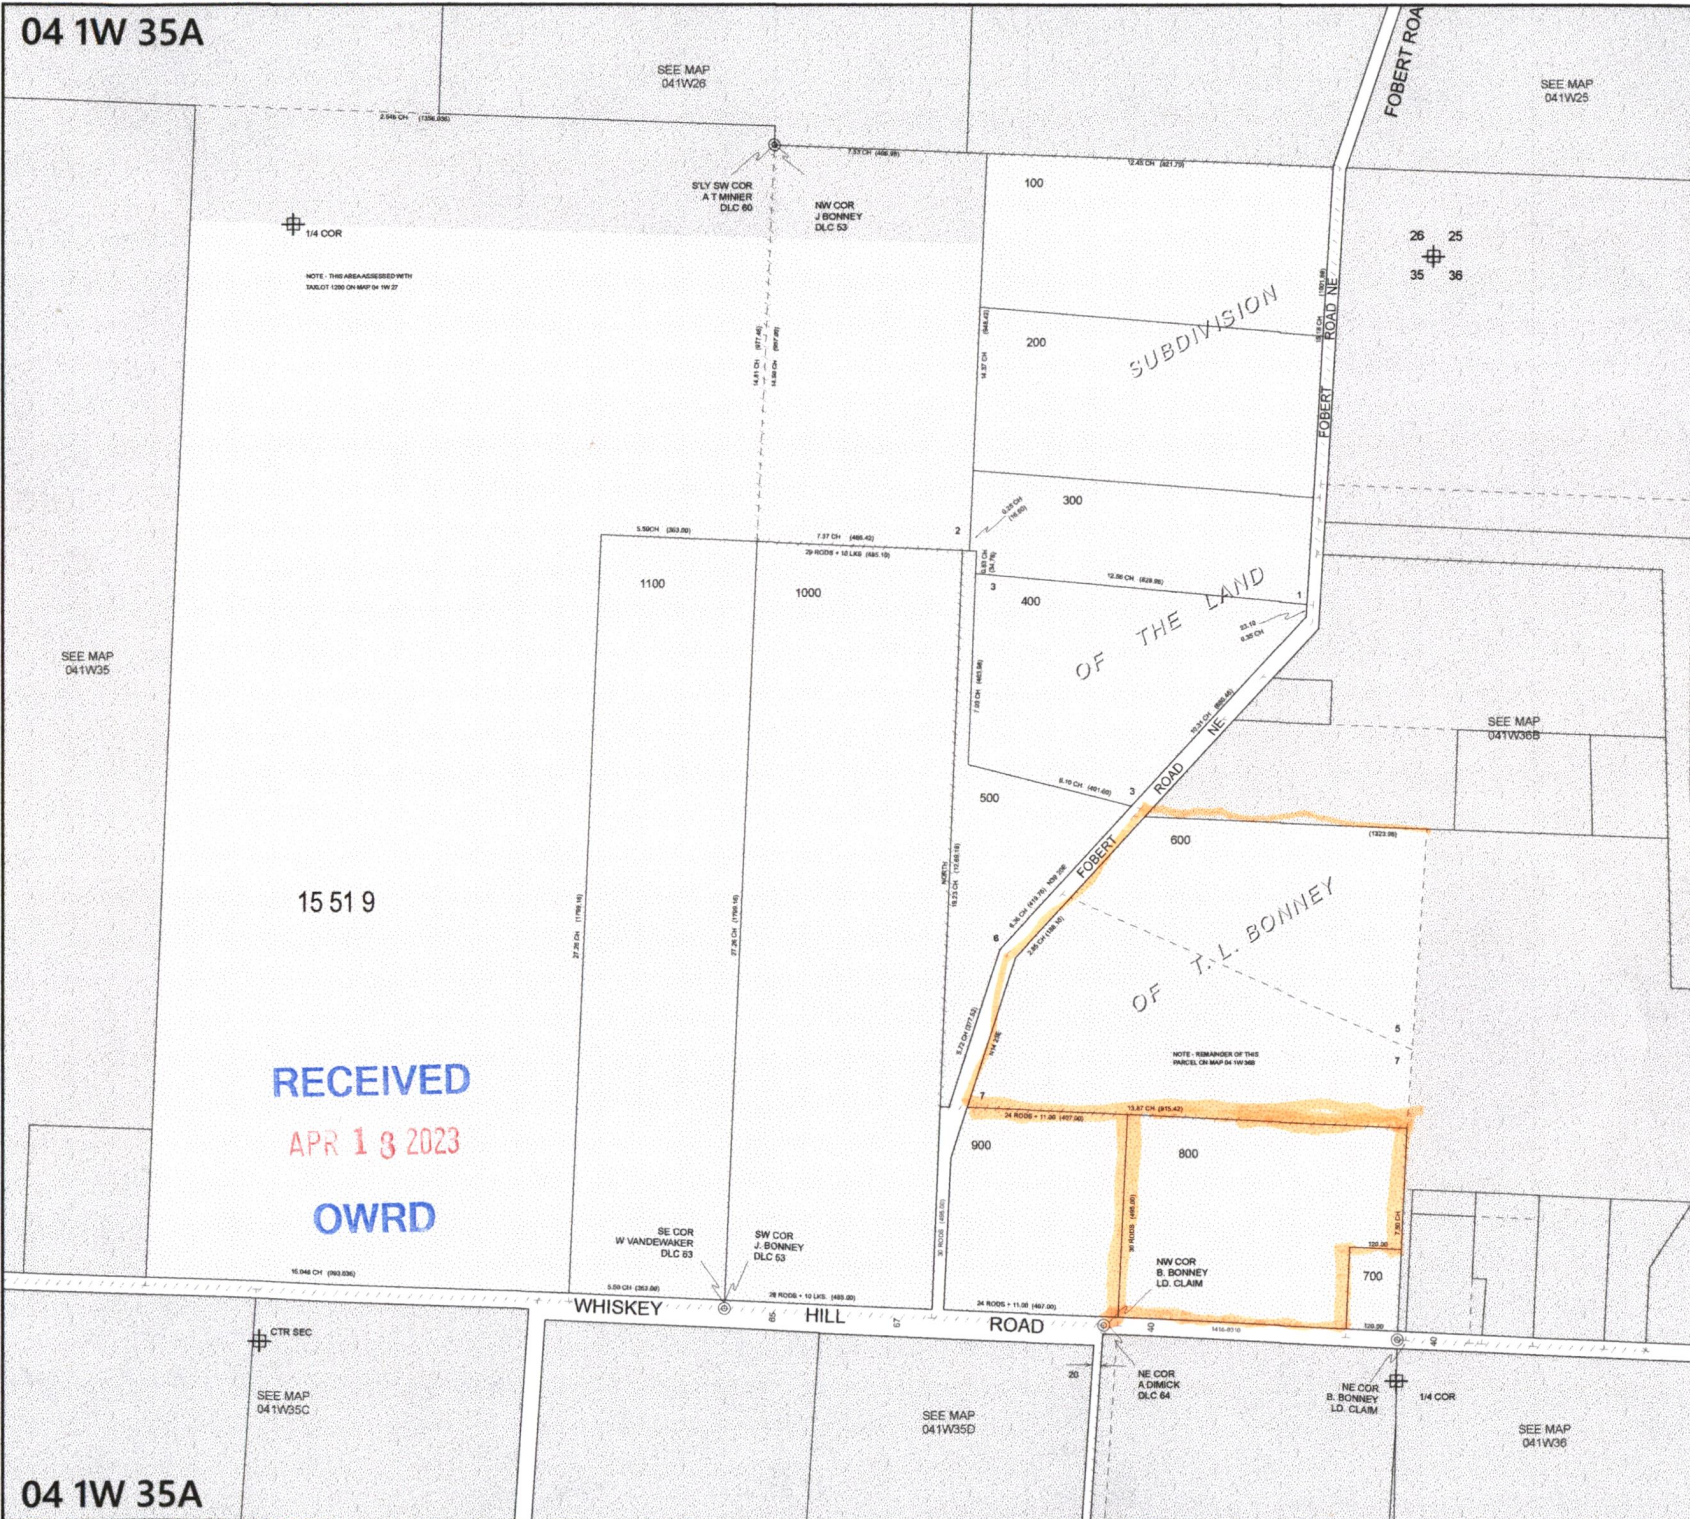

04 1W 35A

04 1W 36B
041W26

SEE MAP
041W25

04 1W 36B



MARION COUNTY, OREGON
NW1/4 SEC36 T4S R1W W.M.
SCALE 1" = 200'

LEGEND

LINE TYPES

- | | |
|--------------------------|-----------------------|
| Taxlot Boundary | Historical Boundary |
| Road Right-of-Way | Easement |
| Railroad Right-of-Way | Railroad Centerline |
| Private Road ROW | Taxcode Line |
| Subdivision/Plat Bndry | Map Boundary |
| Waterline - Taxlot Bndry | Waterline - Non Bndry |

CORNER TYPES

- | | |
|-----------------------|----------------------------|
| + 1/16TH Section Cor. | ⊕ 1/4 Section Cor. |
| ⊙ DLC Corner | 16, 15
⊕ Section Corner |
| | 21 22 |

NUMBERS

Tax Code Number
00 00 0

Acres 0.29 AC All acres listed are Net Acres, excluding any portions of the taxlot within public ROWs

NOTES

Tick Marks: A tick mark in the road indicates that the labeled dimension extends into the public ROW




CANCELLED NUMBERS		

DISCLAIMER: THIS MAP WAS PREPARED FOR ASSESSMENT PURPOSES ONLY



FOR ADDITIONAL MAPS VISIT OUR WEBSITE AT www.co.marion.or.us

PLOT DATE: 10/16/2020

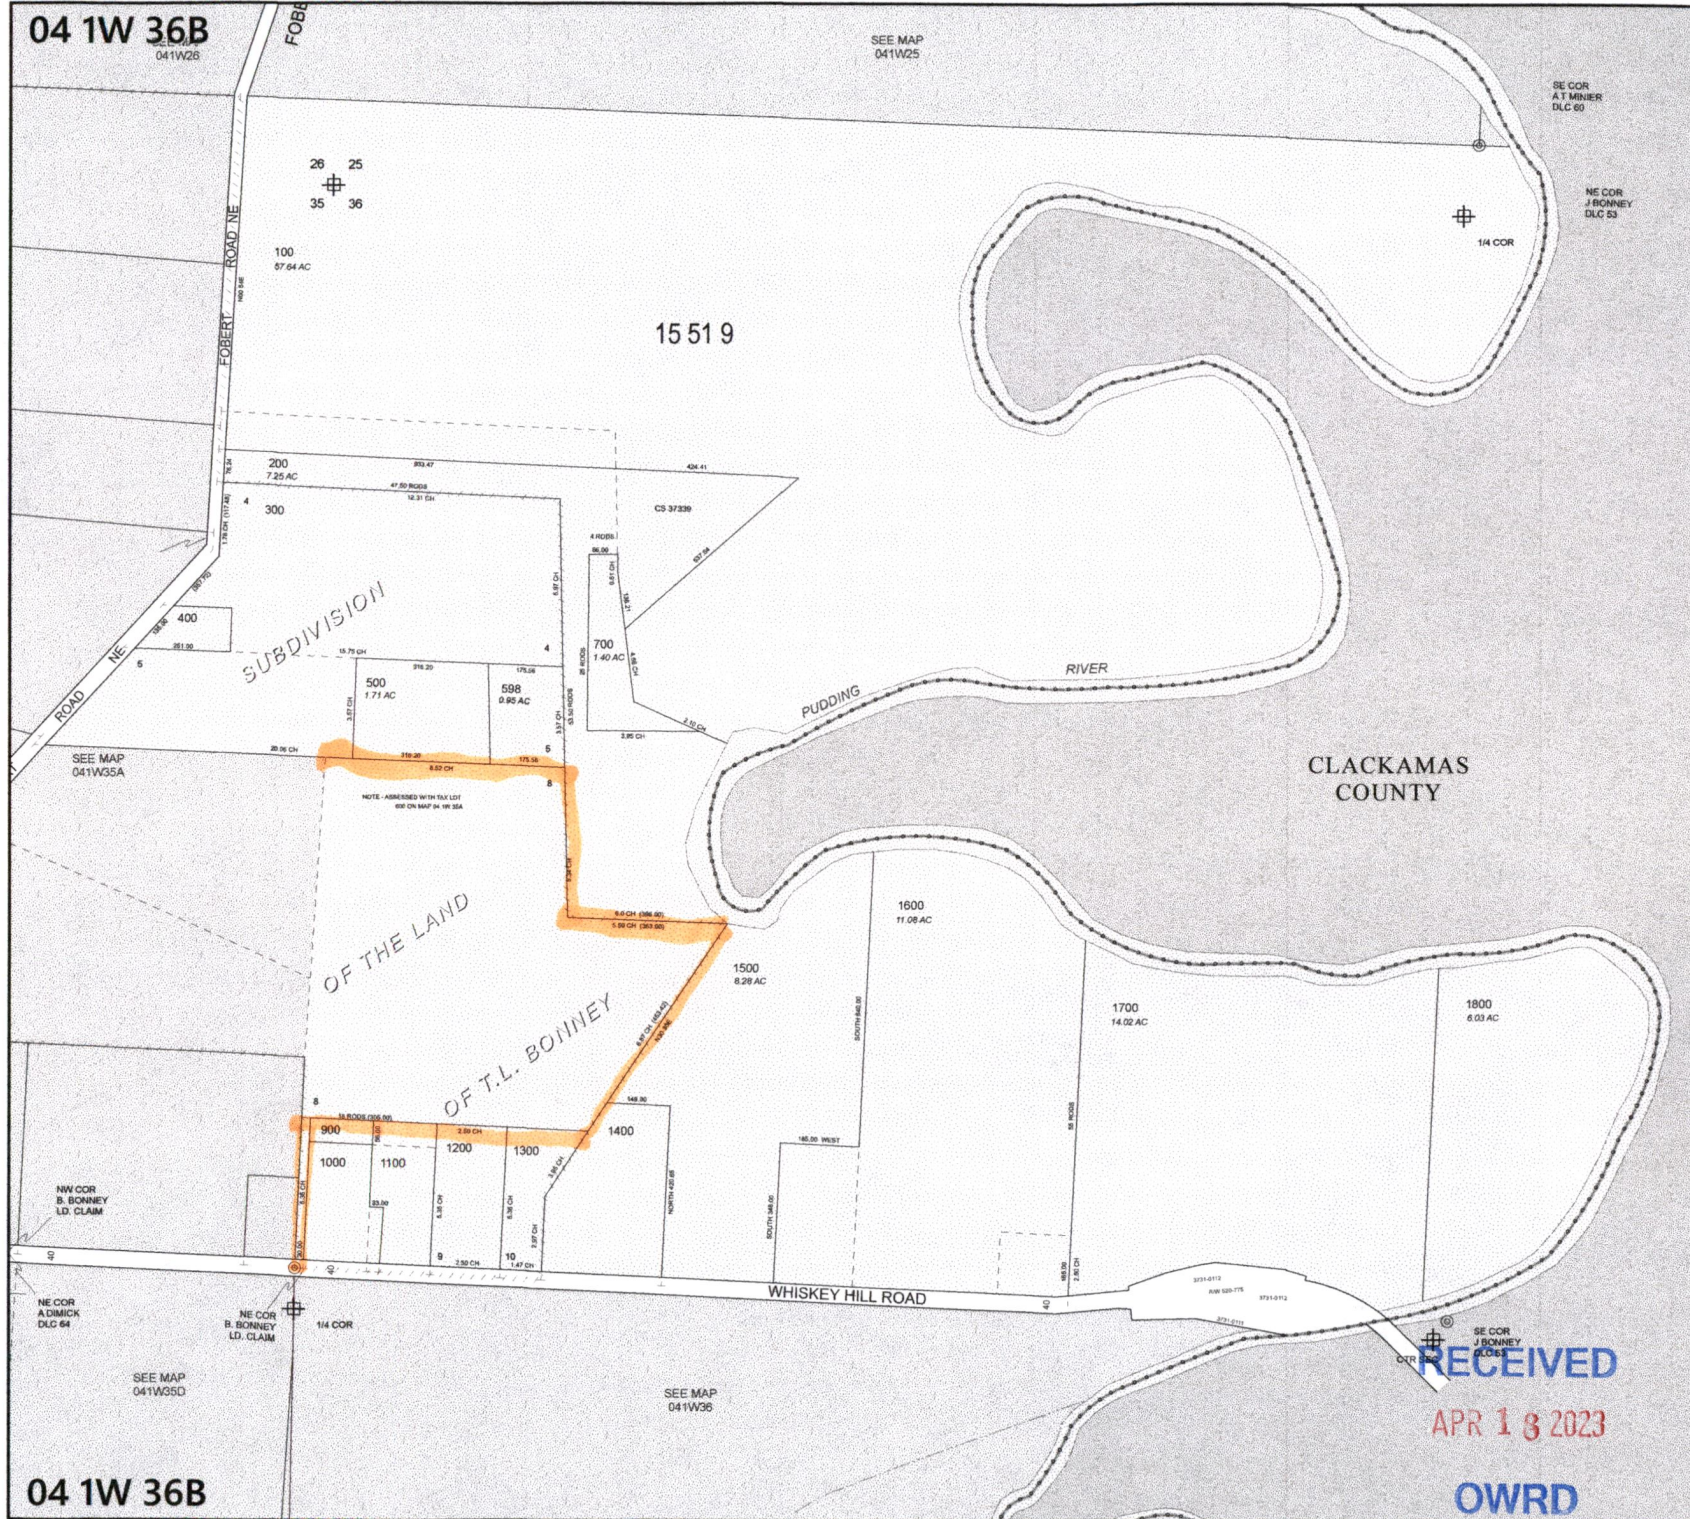

RECEIVED
APR 13 2023
OWRD

04 1W 36B

04 1W 36B