


RECEIVED

MAY 03 2023

OWRD

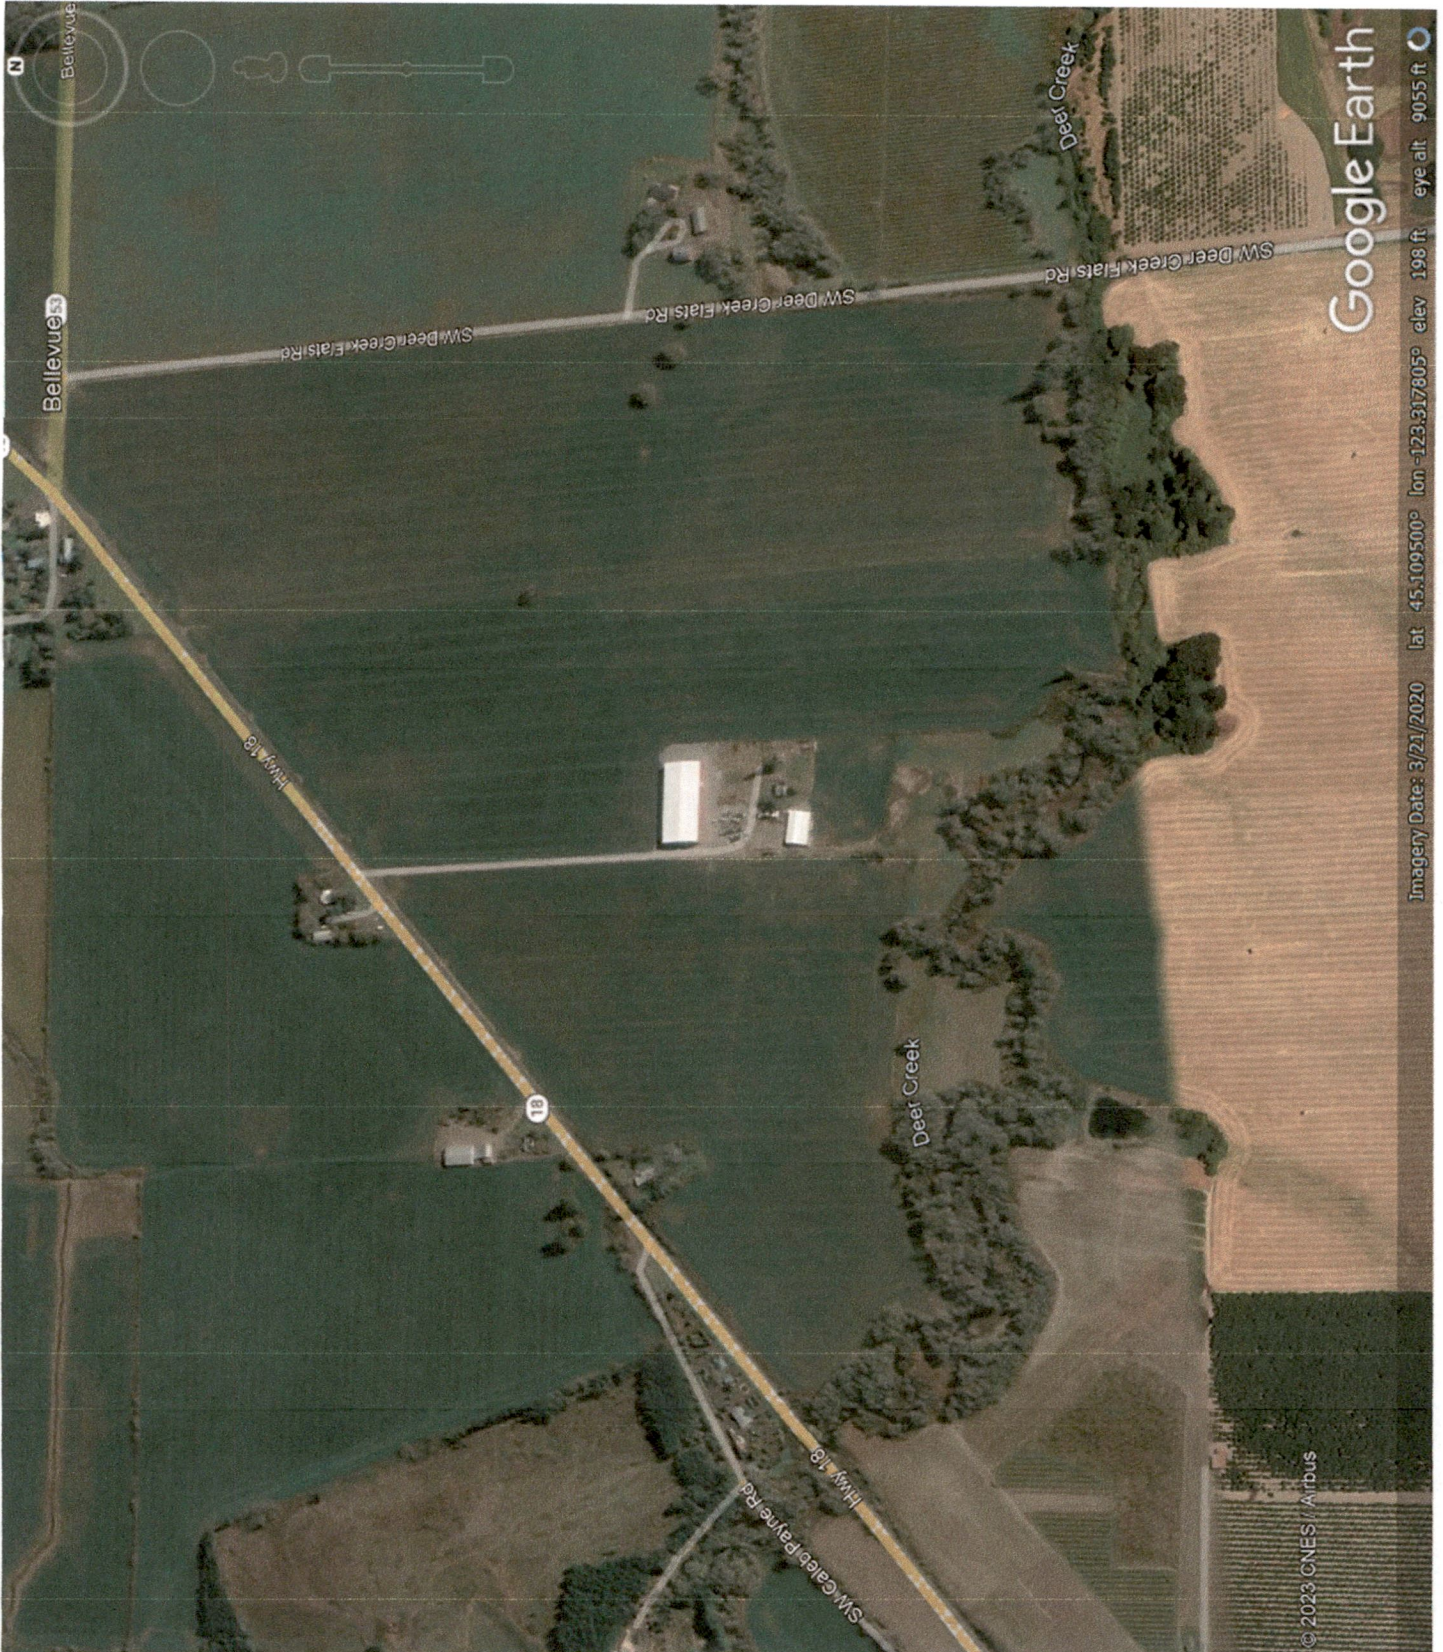


14234



Temporary Transfer - Certificate 40520


Sektan

Township 5S, Range 5W, W.M.

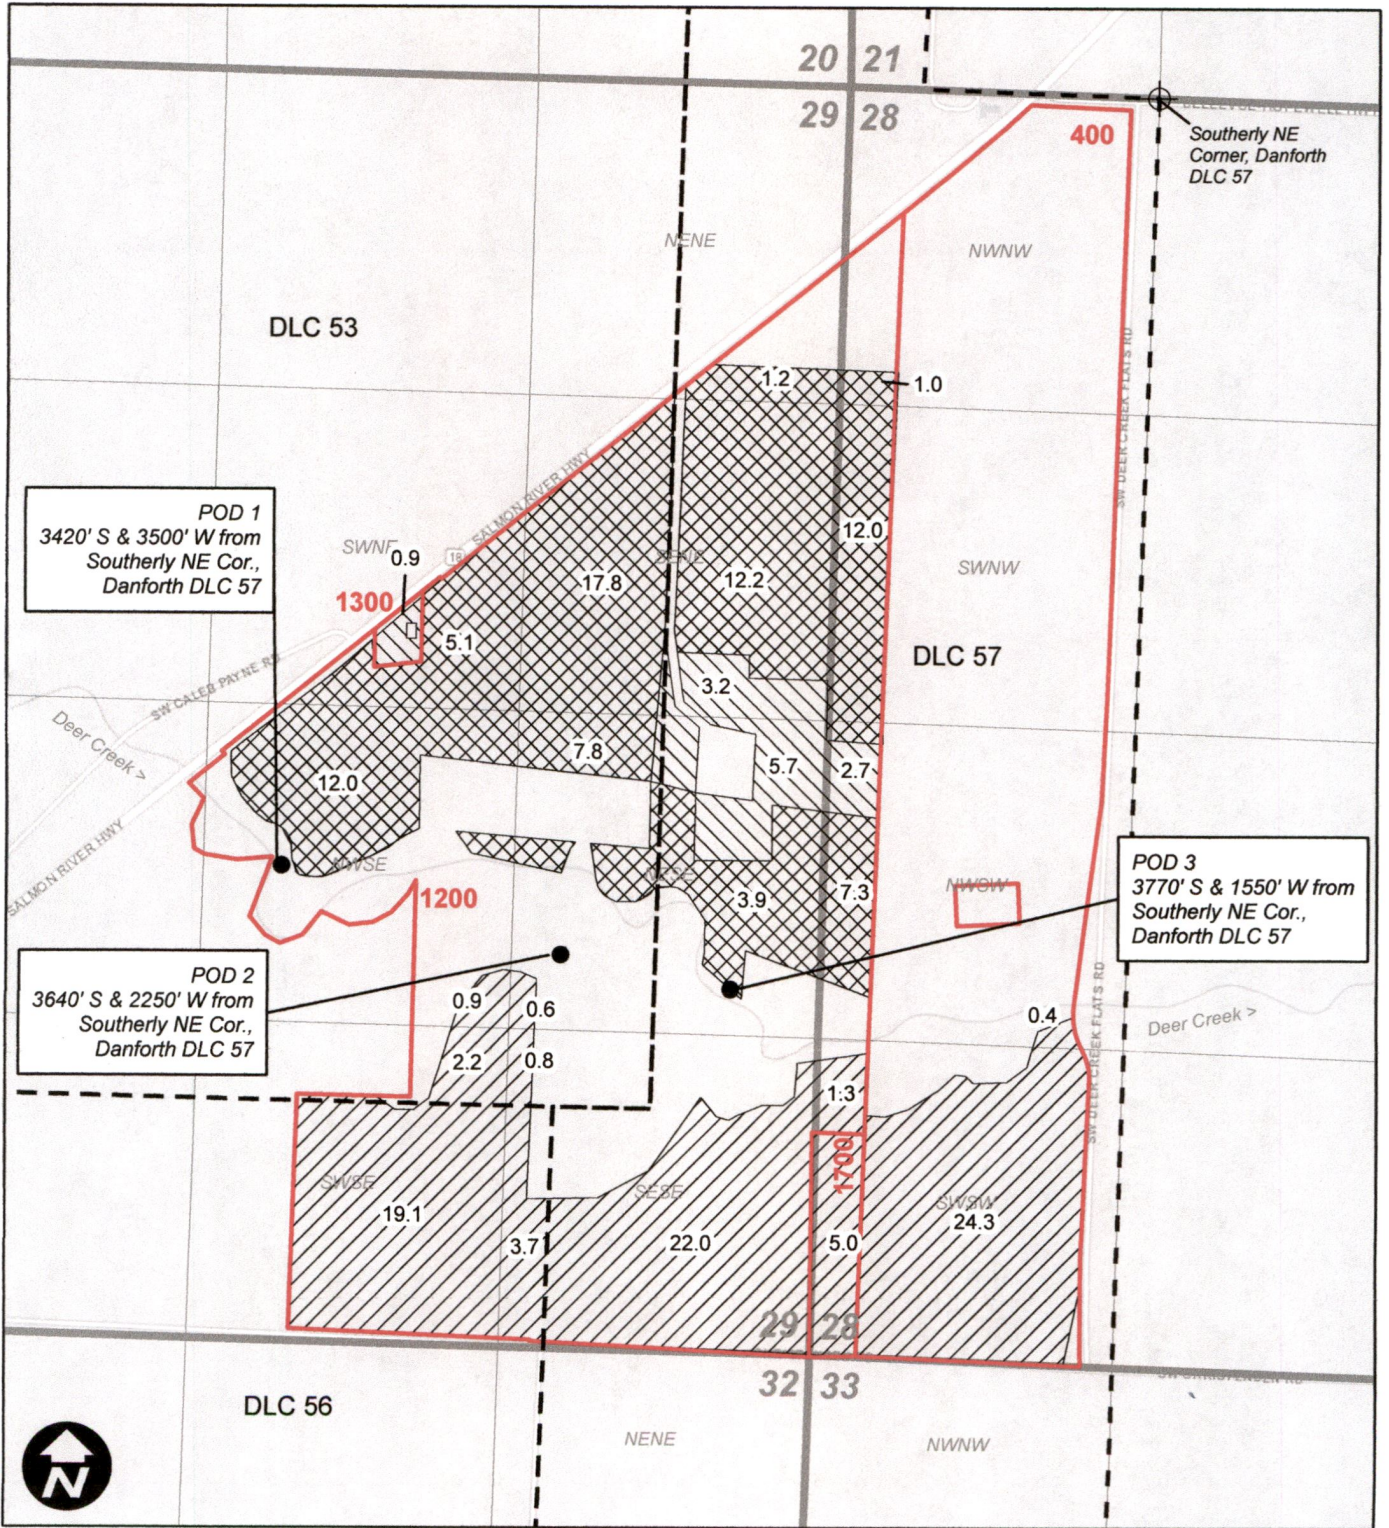

Legend

- Cert. 40520 From
- Cert. 40520 No Change
- DLC
- Cert. 40520 To
- Taxlot

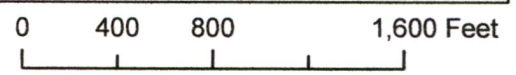

RECEIVED

MAY 03 2023

WILL MCGILL SURVEYING LLC

OWRD

14234