

LEGEND

- Conveyance
- Donation Land Claim (DLC)
- Point of Appropriation (POA)**
- Authorized
- Proposed
- Tax Lot
- Major Road
- Watercourse
- Waterbody
- Authorized Place of Use (POU)**
- GR-2814, 48 ac.

**Groundwater Registration Modification
in the Name of Westwood Farms**

Groundwater Registration-2814

Marion County
Township 6 South, Range 3 West (W.M.)

RECEIVED
MAY 01 2023
OWRD

LOCATION DESCRIPTION

AUTHORIZED POA

Well 1

Located 462 feet South and 2574 feet East from the NW corner of Section 11, Township 6 South, Range 3 West (W.M.)

Well 2

Located 230 feet North and 650 feet West from the N 1/4 corner of Section 11, Township 6 South, Range 3 West (W.M.)

PROPOSED POA

Pump Well

Located 520 feet South and 450 feet East from the N 1/4 corner of Section 11, Township 6 South, Range 3 West (W.M.)


Well 2

Located 285 feet North and 285 feet West from the N 1/4 corner of Section 11, Township 6 South, Range 3 West (W.M.)


DISCLAIMER

This map was prepared for the purpose of identifying the location of a water right only and it is not intended to provide legal dimensions or location of property ownership lines.

Date: October 20, 2022
Data Sources: BLM, ESRI, OWRD, USGS, Marion Co.

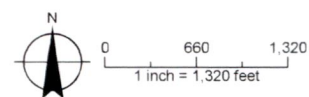

14239th

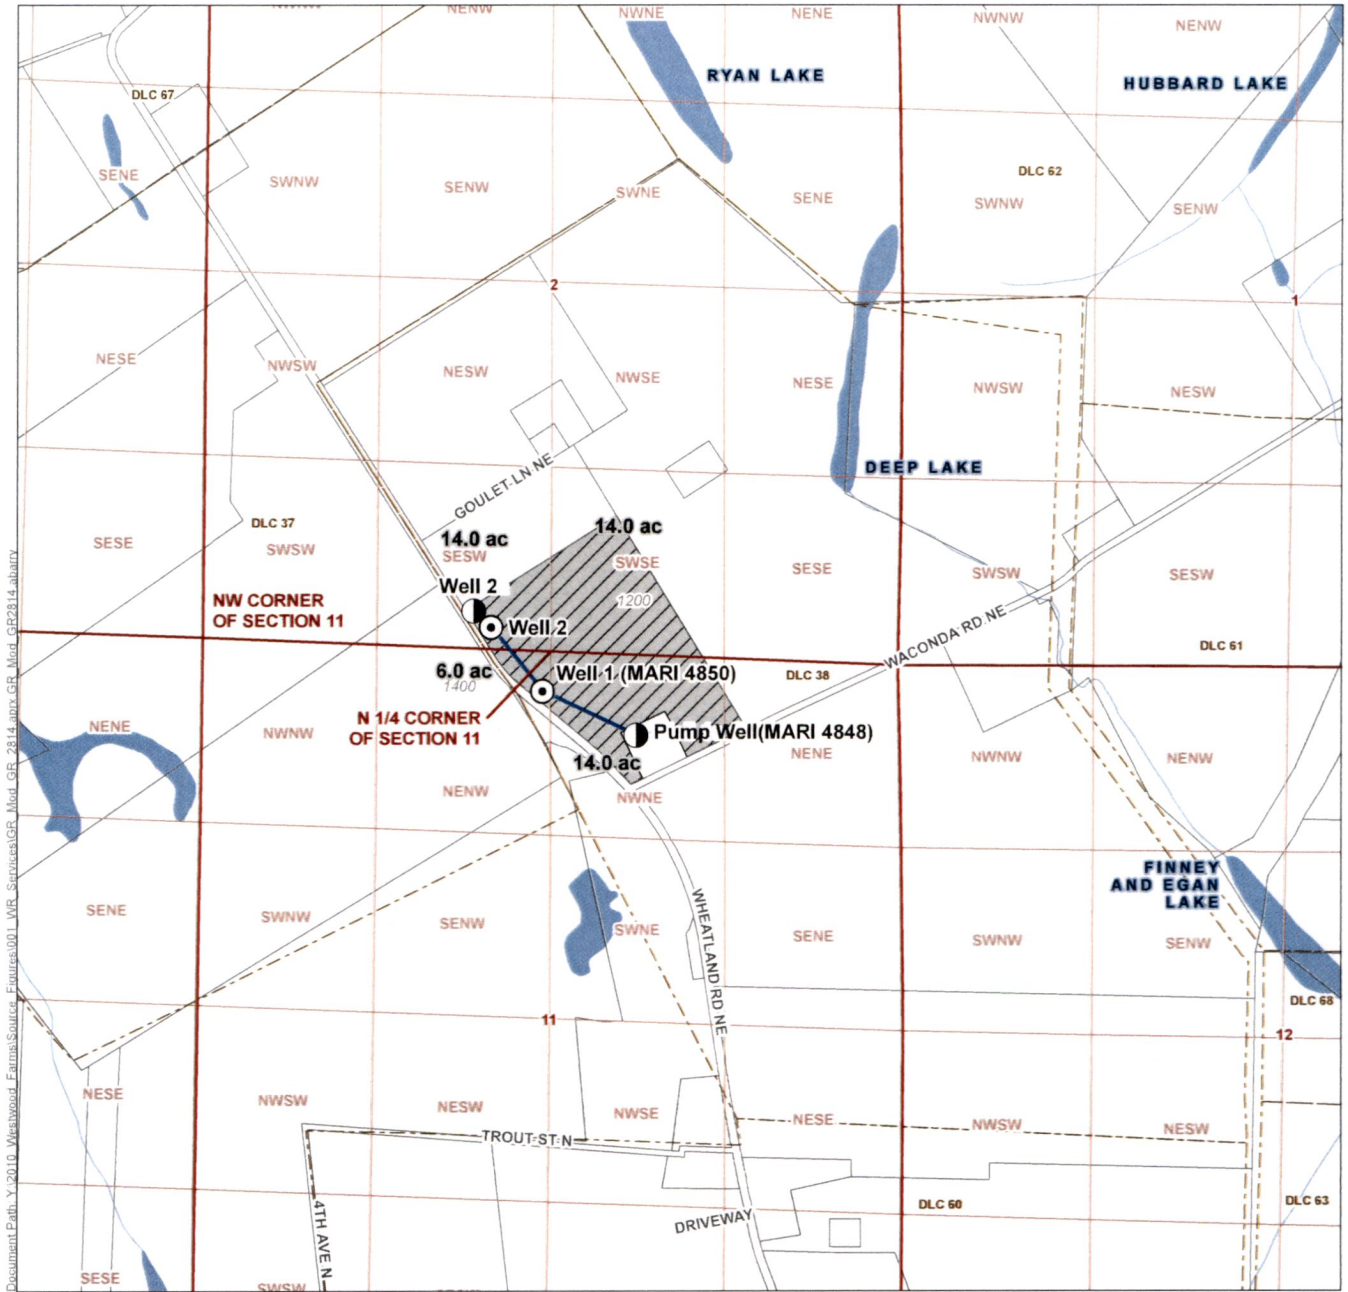

- LEGEND**
- Conveyance
 - Donation Land Claim (DLC)
 - Point of Appropriation (POA)**
 - Authorized
 - Proposed
 - Authorized Place of Use (POU)**
 - GR-2814, 48 ac.
 - Tax Lot
 - Major Road
 - Watercourse
 - Waterbody

Groundwater Registration Modification in the Name of Westwood Farms

Groundwater Registration-2814


Marion County
Township 6 South, Range 3 West (W.M.)

RECEIVED
MAY 01 2023
OWRD

LOCATION DESCRIPTION
AUTHORIZED POA
Well 1
Located 462 feet South and 2574 feet East from the NW corner of Section 11, Township 6 South, Range 3 West (W.M.)
Well 2
Located 230 feet North and 650 feet West from the N 1/4 corner of Section 11, Township 6 South, Range 3 West (W.M.)
PROPOSED POA
Pump Well
Located 520 feet South and 450 feet East from the N 1/4 corner of Section 11, Township 6 South, Range 3 West (W.M.)
Well 2
Located 285 feet North and 285 feet West from the N 1/4 corner of Section 11, Township 6 South, Range 3 West (W.M.)

DISCLAIMER
This map was prepared for the purpose of identifying the location of a water right only and it is not intended to provide legal dimensions or location of property ownership lines.

Date: October 20, 2022
Data Sources: BLM, ESRI, OWRD, USGS, Marion Co.

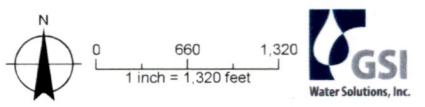

14239

For Local Government Use Only

The following section must be completed by a planning official from each county and city listed unless the project will be located entirely within the city limits. In that case, only the city planning agency must complete this form. This deals only with the local land-use plan. Do not include approval for activities such as building or grading permits.

Please check the appropriate box below and provide the requested information

- Land uses to be served by the proposed water uses (including proposed construction) are allowed outright or are not regulated by your comprehensive plan. Cite applicable ordinance section(s):
- Land uses to be served by the proposed water uses (including proposed construction) involve discretionary land-use approvals as listed in the table below. (Please attach documentation of applicable land-use approvals which have already been obtained. Record of Action/land-use decision and accompanying findings are sufficient.) **If approvals have been obtained but all appeal periods have not ended, check "Being pursued."**

Type of Land-Use Approval Needed (e.g., plan amendments, rezones, conditional-use permits, etc.)	Cite Most Significant, Applicable Plan Policies & Ordinance Section References	Land-Use Approval:	
		<input type="checkbox"/> Obtained <input type="checkbox"/> Denied	<input type="checkbox"/> Being Pursued <input type="checkbox"/> Not Being Pursued
	RECEIVED	<input type="checkbox"/> Obtained <input type="checkbox"/> Denied	<input type="checkbox"/> Being Pursued <input type="checkbox"/> Not Being Pursued
	MAY 01 2023	<input type="checkbox"/> Obtained <input type="checkbox"/> Denied	<input type="checkbox"/> Being Pursued <input type="checkbox"/> Not Being Pursued
	OWRD	<input type="checkbox"/> Obtained <input type="checkbox"/> Denied	<input type="checkbox"/> Being Pursued <input type="checkbox"/> Not Being Pursued

Local governments are invited to express special land-use concerns or make recommendations to the Water Resources Department regarding this proposed use of water below, or on a separate sheet.

Taxlot 06-3W-02-0120, a 44.06 acre parcel lying north of Wheatland Rd N and currently owned by Echo Ridge Farms Inc, Arrowhead Farms Inc, & Westwood Farms Inc, was reviewed in its entirety, both the area lying within Section 2 and 11. Taxlot 06-3W-11-01200, a 0.74 acre parcel lying south of Wheatland Rd N and approximately a 1/4 mile south of taxlot 06-3W-02-01200, and currently owned by Marc A Belleque, was NOT reviewed.

Name: Nicole Inman Title: Associate Planner

Signature: *Nicole Inman* Phone: 503-588-5038 Date: 11/1/2022

Government Entity: Marion County Planning

Note to local government representative: Please complete this form or sign the receipt below and return it to the applicant. If you sign the receipt, you will have 30 days from the Water Resources Department's notice date to return the completed Land Use Information Form or WRD may presume the land use associated with the proposed use of water is compatible with local comprehensive plans.



Receipt for Request for Land Use Information

Applicant name: _____

City or County: _____ Staff contact: _____

Signature: _____ Phone: _____ Date: _____