


Groundwater Registration Modification - GR 2390

Braun

Township 11S, Range 2W, W.M.

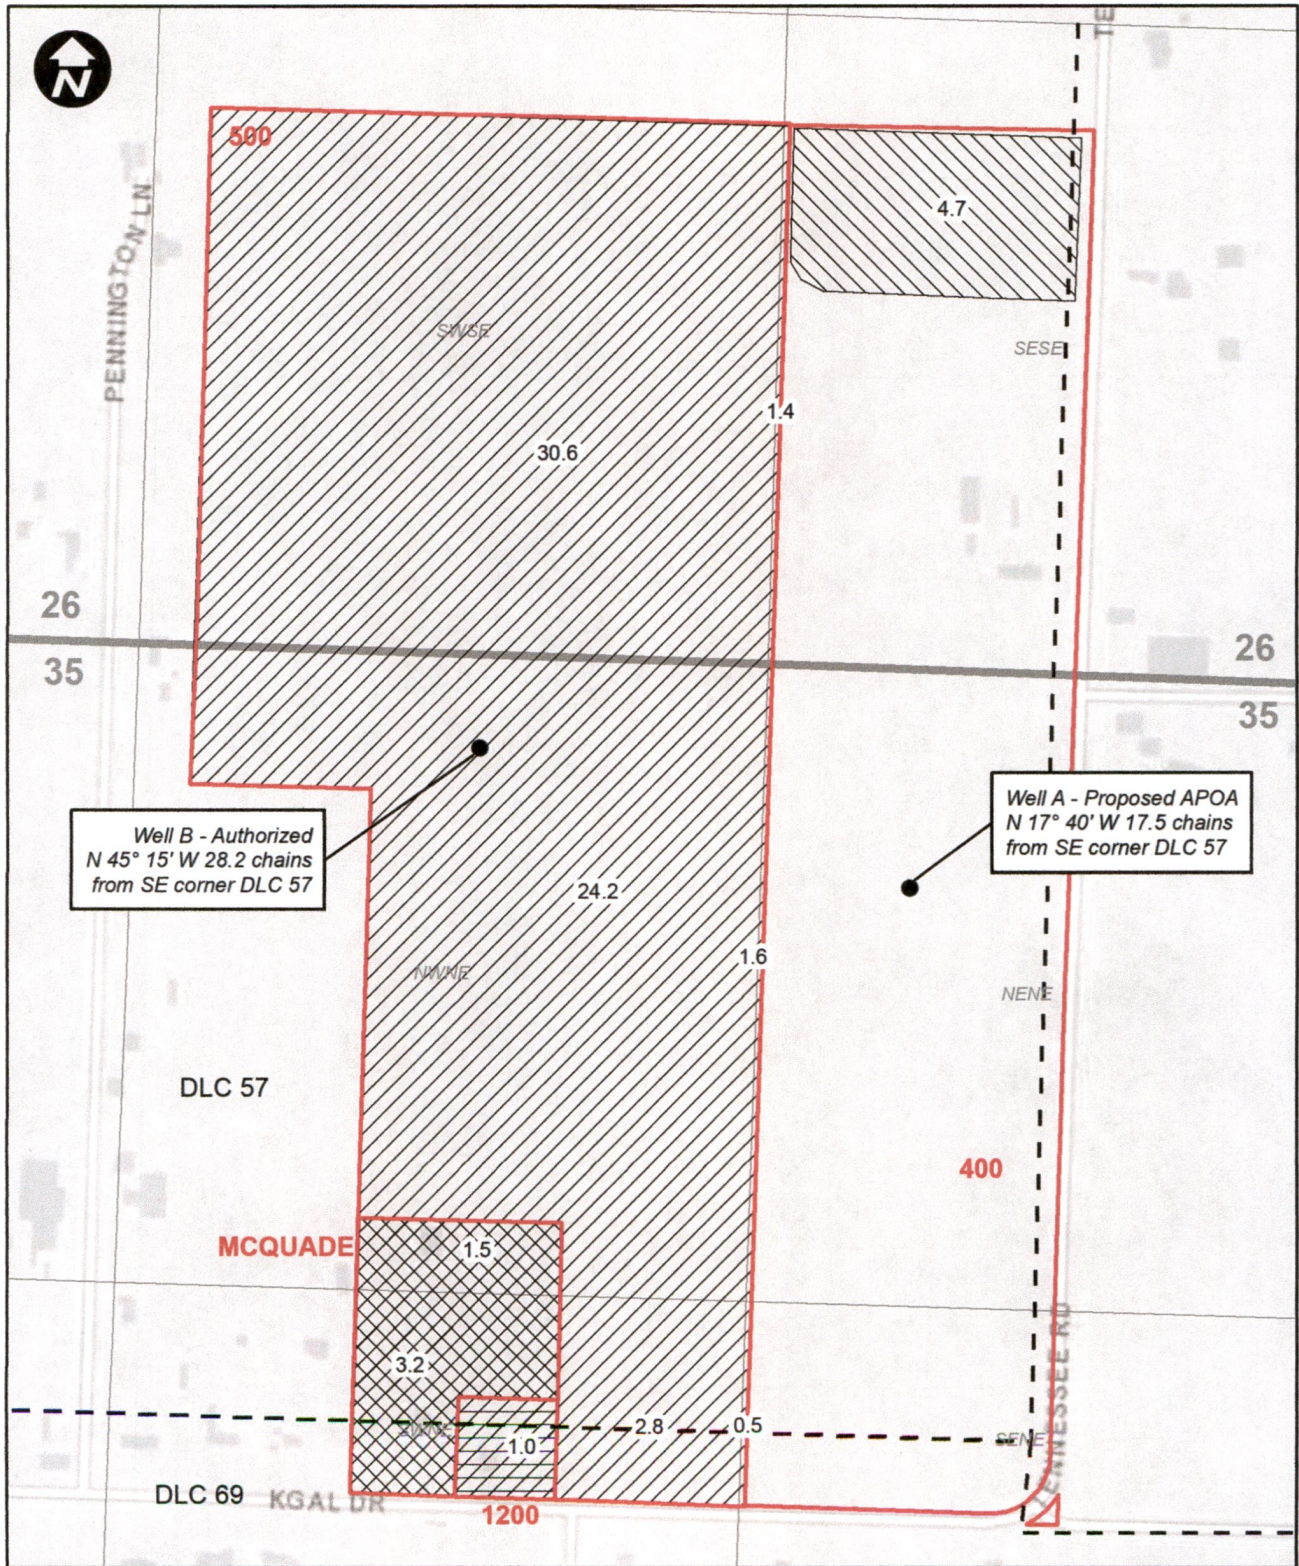

Legend

- GR 2390 From
- GR 2390 APOA only
- Taxlot
- GR 2390 To
- GR 2390 No Change
- DLC

0 200 400 800 Feet

RECEIVED

MAY 19 2023

WILL MCGILL SURVEYING LLC
OWRD

14248 -