


# Transfer Application - Sun-Ray Farms

## Certificates 44215, 83391, 85864

Township 8S,  
Range 4W, W.M.

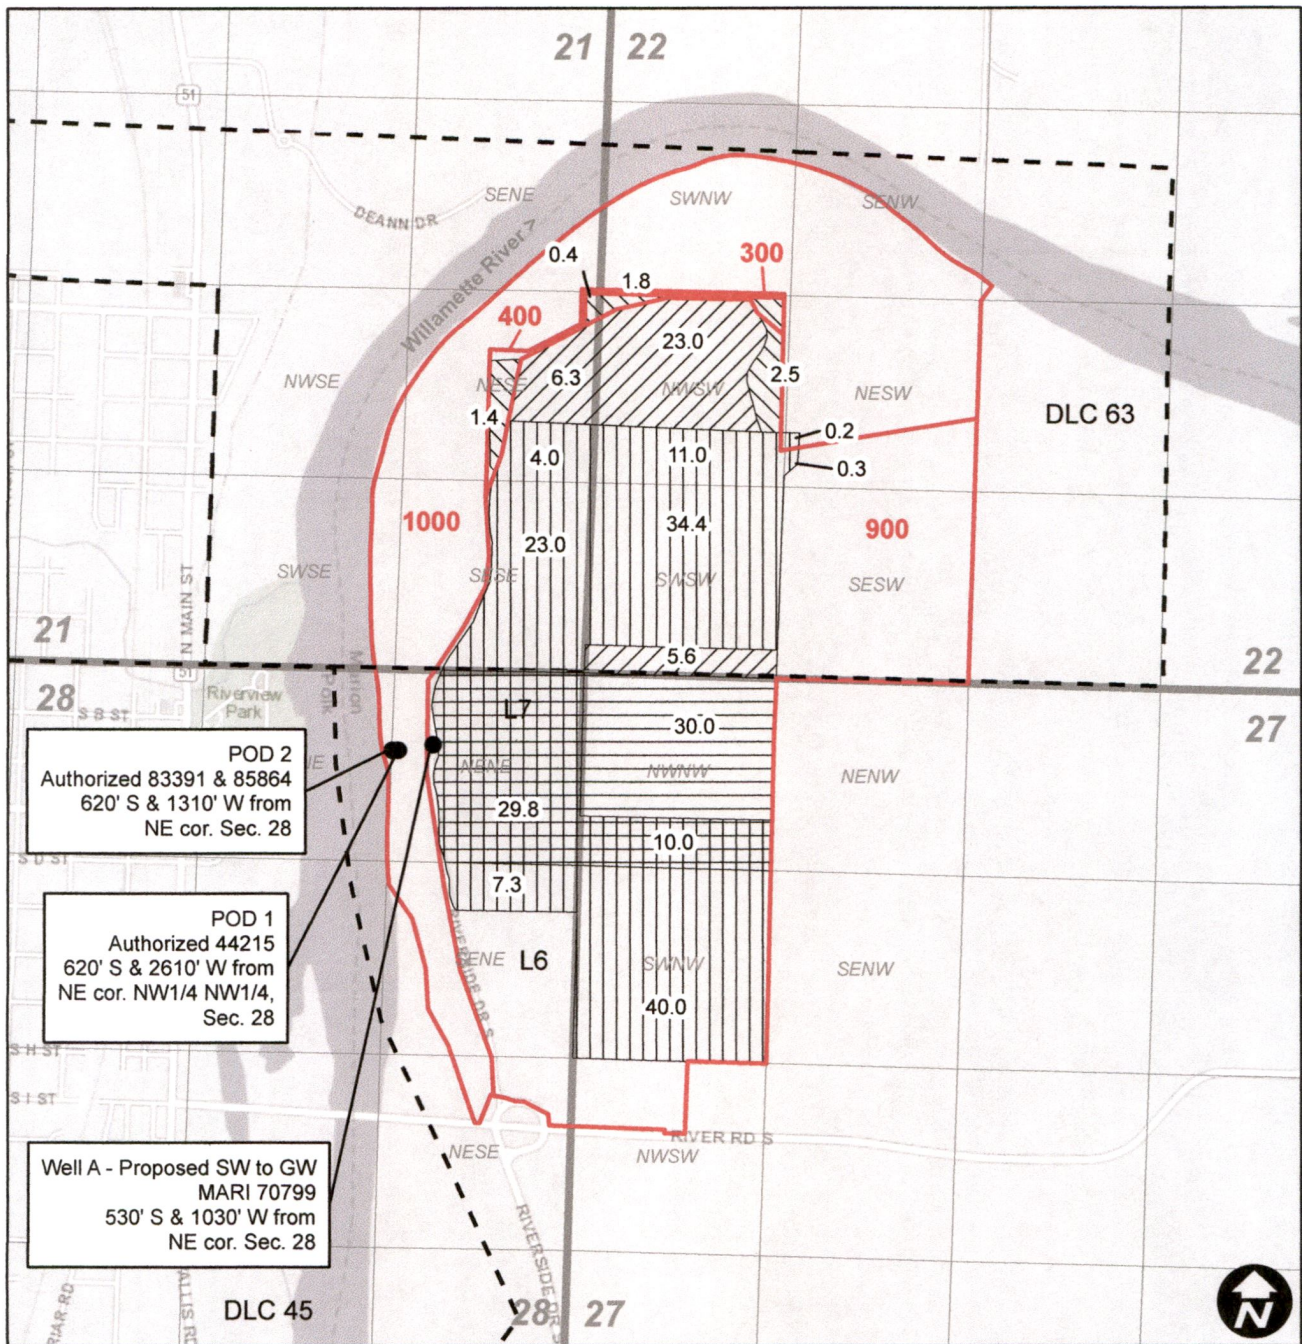

POD 2  
Authorized 83391 & 85864  
620' S & 1310' W from  
NE cor. Sec. 28

POD 1  
Authorized 44215  
620' S & 2610' W from  
NE cor. NW1/4 NW1/4,  
Sec. 28

Well A - Proposed SW to GW  
MARI 70799  
530' S & 1030' W from  
NE cor. Sec. 28

### Legend

- |  |                           |  |                |
|--|---------------------------|--|----------------|
|  | Cert. 44215 IR            |  | Cert. 83391 IS |
|  | Cert. 44215 IR & 85864 IS |  | Taxlots        |
|  | Cert. 85864 IS            |  | DLC            |
|  | Cert. 83391 IR            |  |                |



RECEIVED  
JUN 09 2023  
OWRD

WILL MCGILL SURVEYING LLC

14264 -