


JACKSON COUNTY SEC.15 T38S R1W

E-RECEIVED
6/20/2023
OWRD

SCALE - 1" = 400'



SW 1/4 OF THE NW 1/4; N 1/4 OF THE SW 1/4

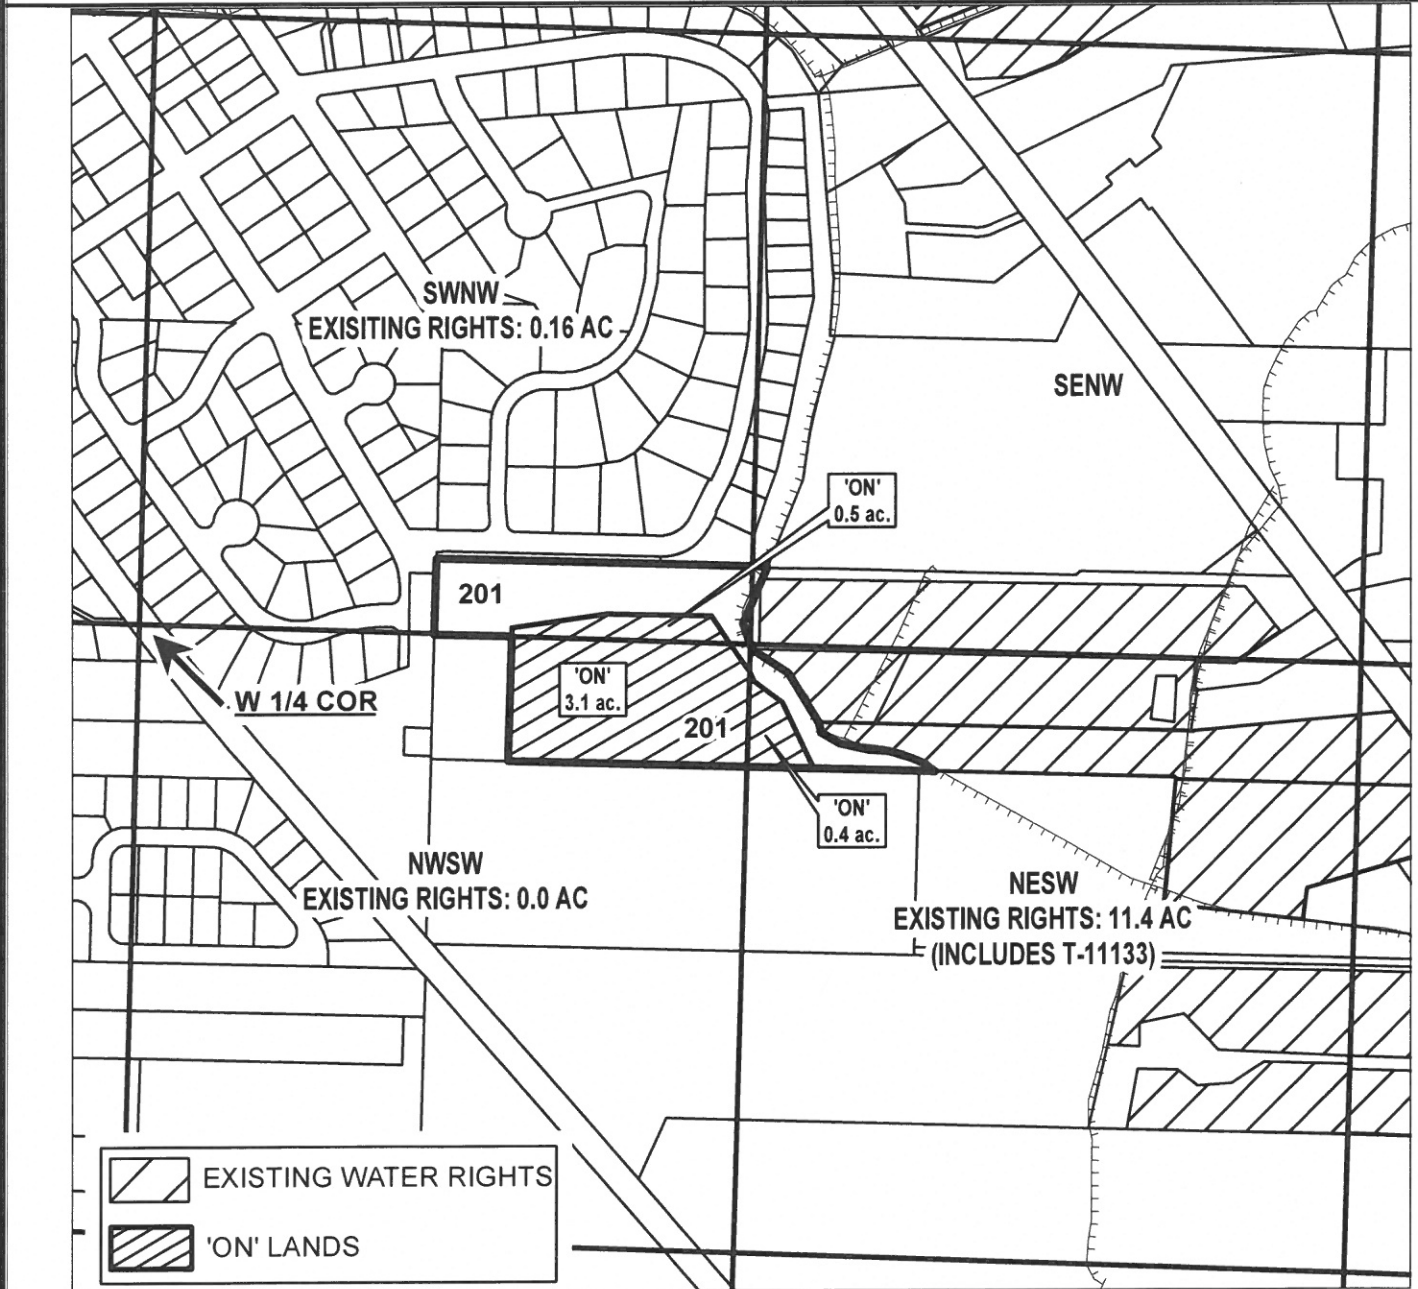

CLAIM OF BENEFICIAL USE

NAME: BRYAN SMITH

TAXLOT #: 201

0.5 AC SWNW
3.1 AC NWSW
0.4 AC NESW

Date: 10/23/2022

"ON" MAP

TRANSPER CERT #:

P 83381

S 83383

S 83278

Permit S-4951

OWRD: T-13333
DIN: T-2019-04

JACKSON COUNTY SEC.28 T37S R2W


E-RECEIVED
6/20/2023
OWRD

SCALE - 1" = 400'



"ON" MAP

S 1/2 OF THE NW 1/4; NE 1/4 OF THE SW 1/4

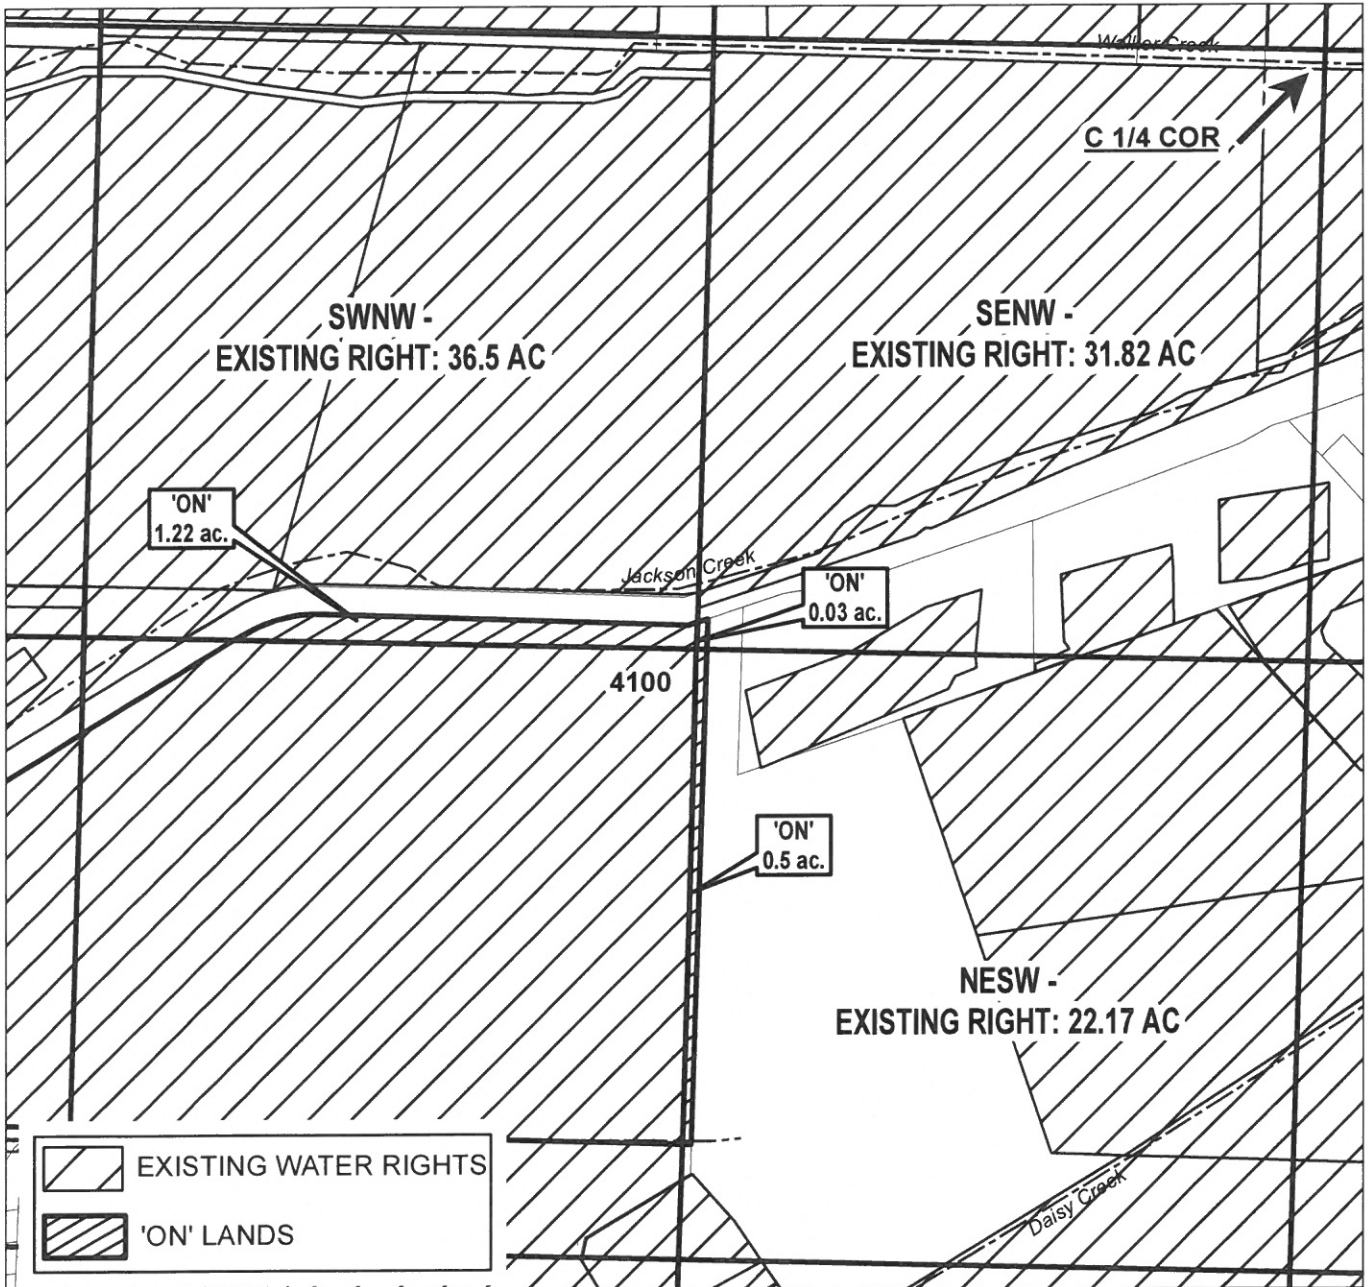

Date: 10/23/2022

CLAIM OF BENEFICIAL USE

NAME: YOUNG, DAVID

TAXLOT #: 4100

1.75 ACRES

TRANSFER CERT #:

P 83381

S 83383

S 80578

S 83728

Permit S-4951