

APPLICATION MAP FOR PERMIT AMENDMENT TO PERMIT G-17616 (APPLICATION G-18082)

REFERENCE CORNER:
LOCATED AT THE NW CORNER OF SECTION 6, TOWNSHIP 7 SOUTH,
RANGE 39 EAST, W.M.

BAKER COUNTY TAX LOT OWNERSHIP: 2401, 1102 & 1100

AS PERMITTED WELL LOCATIONS

WELL #1:
150 FT EAST & 1,590 FT SOUTH OF THE REFERENCE CORNER.


 







WELL #2
160 FT EAST & 1,700 FT SOUTH OF THE REFERENCE CORNER.

WELL #3:
930 FT EAST & 1,625 FT SOUTH OF THE REFERENCE CORNER.


AS DRILLED WELL LOCATION:

Well #2:
227 FT EAST & 1,638 FT SOUTH OF THE REFERENCE CORNER
(BAKE 52667)


LEGEND:

-  TAX LOT BOUNDARY
 -  SECTION BOUNDARY
 -  QUARTER/QUARTER
 -  REFERENCE CORNER
 -  LOCATION OF PERMITTED WELLS
 -  LOCATION OF AS DRILLED WELL #2
 -  EXISTING POU TO BE CHANGED (2.7 AC)
 -  EXISTING POU UNCHANGED (97.3 AC)
 -  NEW POU (2.7 AC)
- 1 INCH = 1,320 FEET

RECEIVED
JUL 03 2023
OWRD

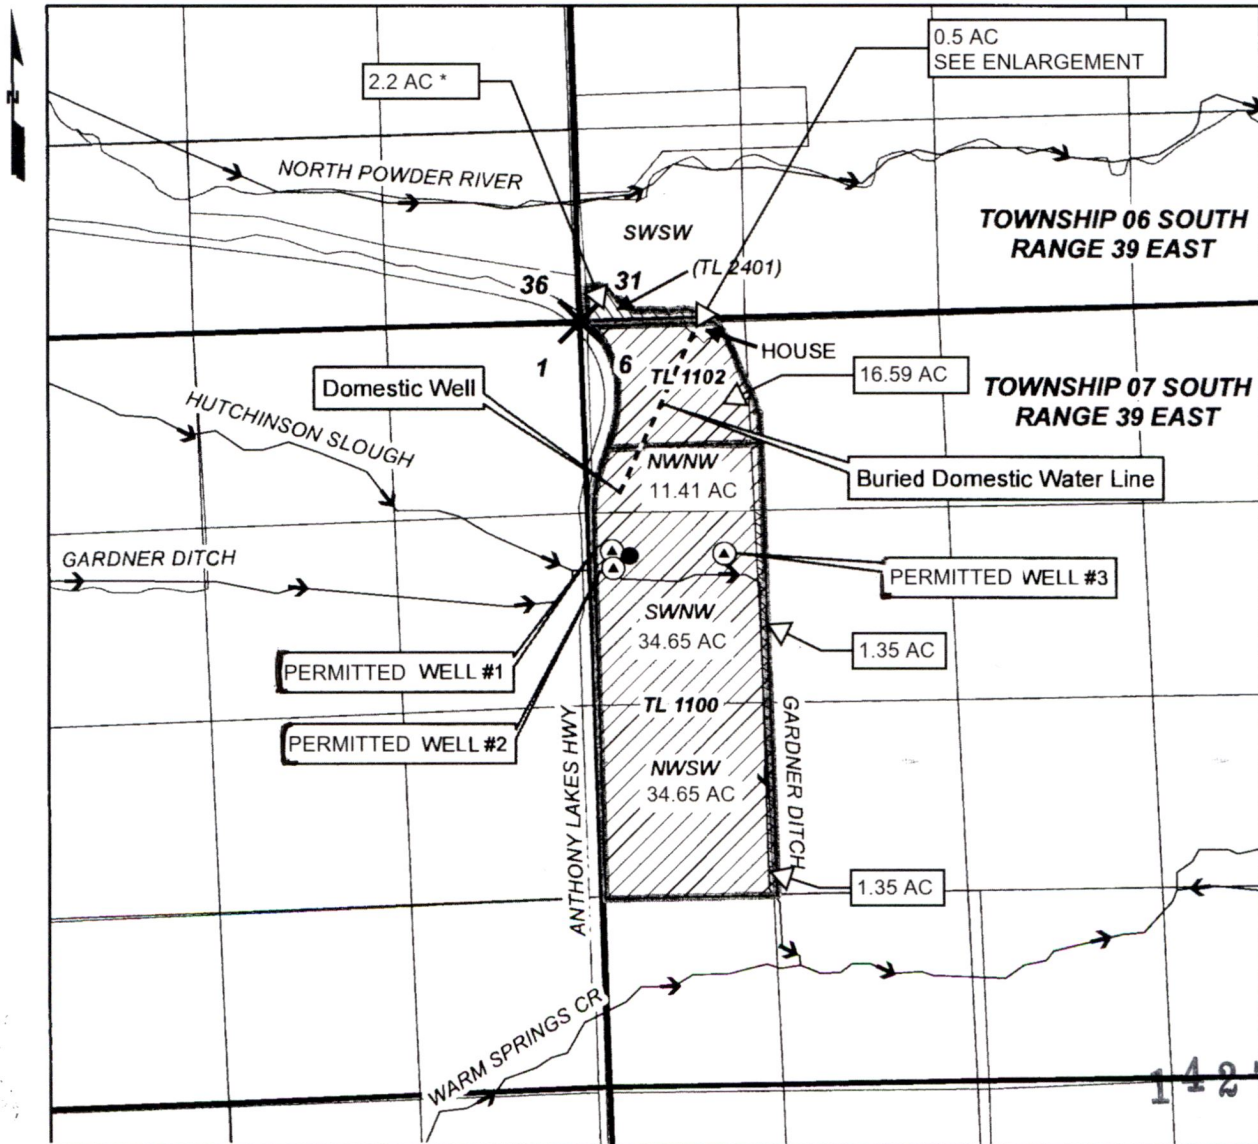

ENLARGEMENT: HOUSE Parcel = 1.0 acre total

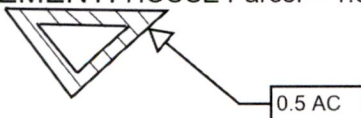

* TL 2401 is 2.58 acres total,
thus proposed 2.2 acres does
not cover entirety of tax lot.

PREPARATION OF THIS MAP IS FOR
THE PURPOSE OF IDENTIFYING THE
LOCATION OF THE WATER RIGHT
ONLY. THERE IS NO INTENT TO
PROVIDE DIMENSIONS OR LOCATIONS
OF PROPERTY OWNERSHIP LINES.