





Voluntary Partial Cancellation - Hudspeth

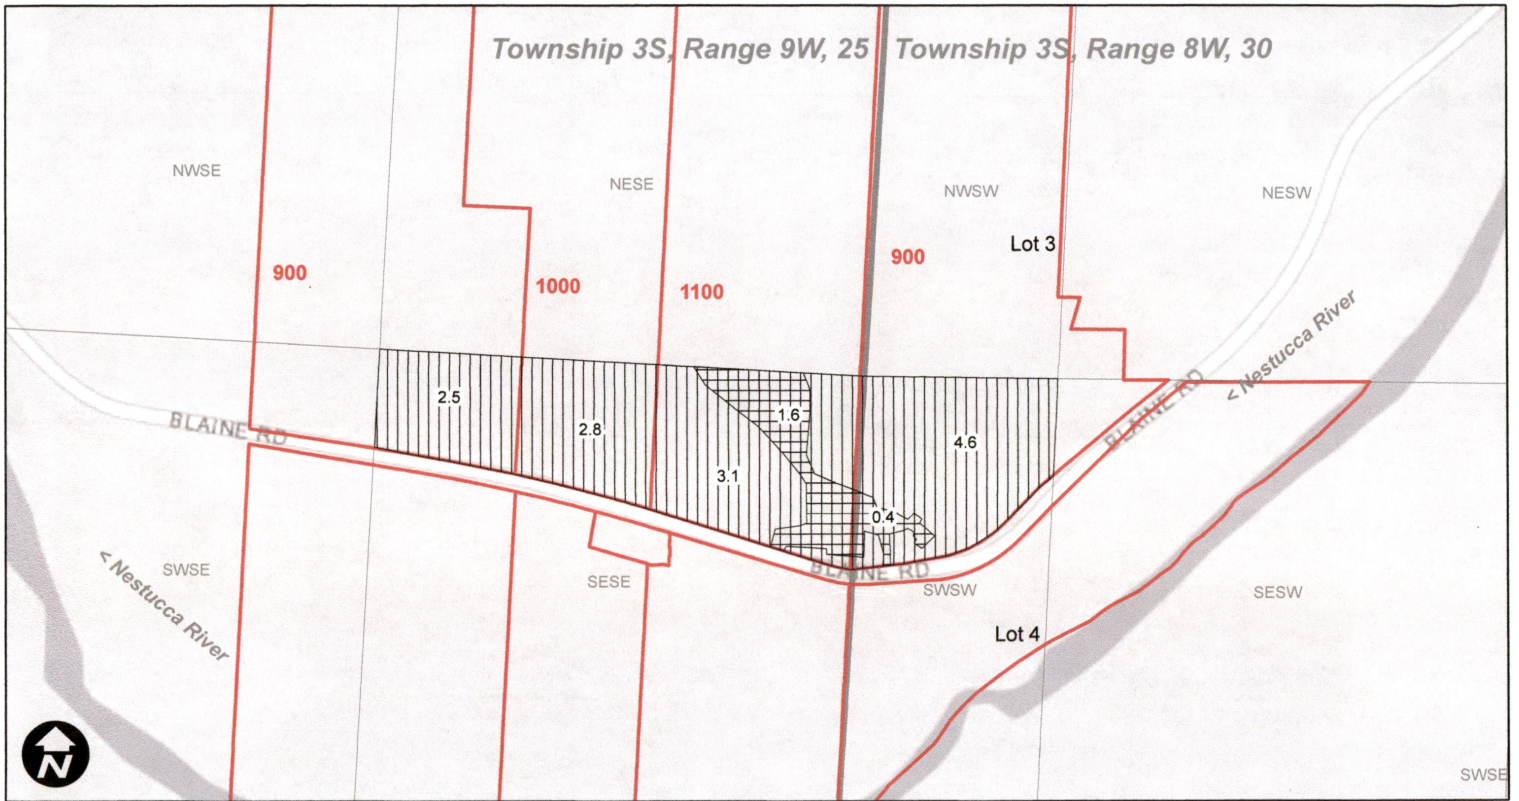

Legend

-  Cert. 9536 No Change
-  Cert. 9536 Voluntary Cancellation
-  Taxlots

RECEIVED

AUG 21 2023

OWRD

 WILL MCGILL SURVEYING LLC




1149111-

RECEIVED

AUG 21 2023

OWRD

Transfer Application - Hudspeth

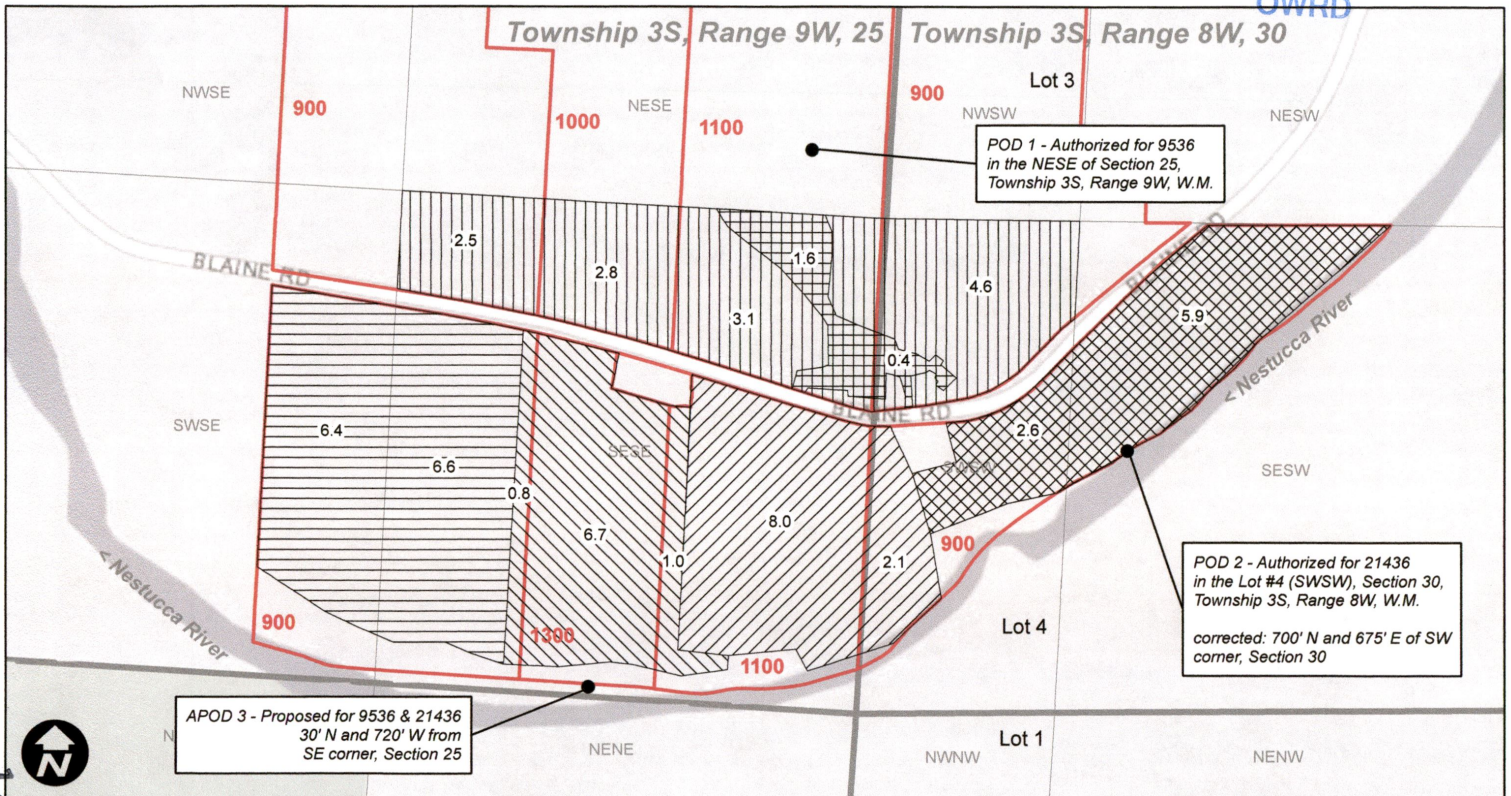

14311

Legend

- Cert. 9536 From
- Cert. 9536 To
- Pending Cancellation 9536
- Cert. 21436 From
- Cert. 21436 To
- Cert. 21436 No Change
- Taxlots

0 200 400 800 Feet

WILL MCGILL SURVEYING LLC

CERTIFIED WATER RIGHT EXAMINER
30680
William E. McGill
WILLIAM E. MCGILL
 MAY 3, 2011
STATE OF OREGON
 EXPIRES: 12-31-2024