


JOHN B. RAMOS & LYNN D. RAMOS
 TRANSFER APPLICATION MAP
 DESCRIBED IN UMATILLA DECREE ALLEN DITCH CO.
 VOL 3 PAGE 127 (UMATILLA RIVER)
 UMATILLA COUNTY
 TAX LOT #1900 - 17.0 AC
 T3N, R29E, SEC 16 WM

RECEIVED
 AUG 07 2023
 OWRD

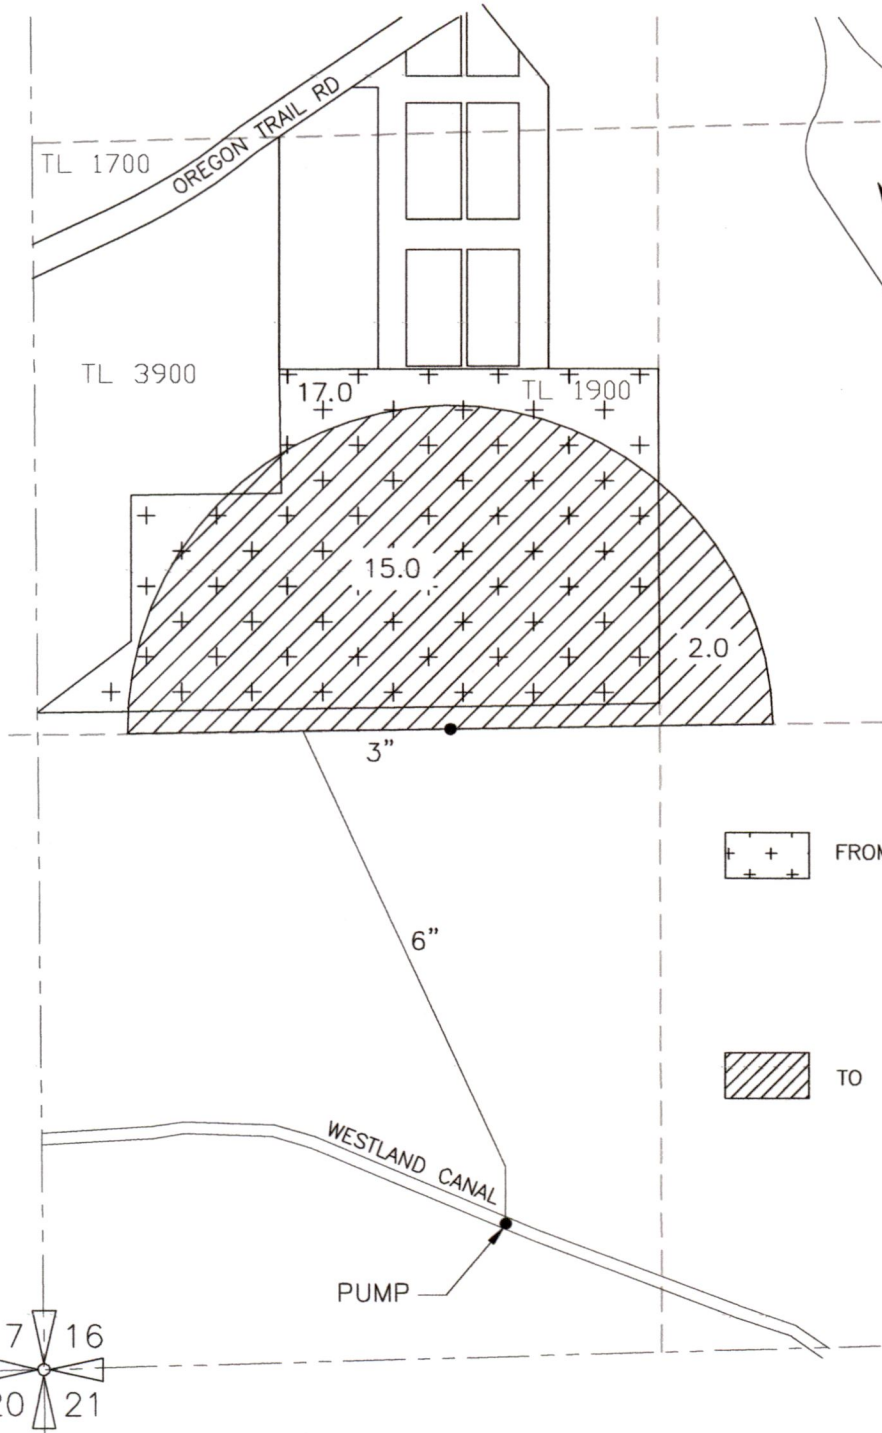

CERTIFIED WATER RIGHT EXAMINER
 96512
 TY JAMES LORD
 MAY 10, 2022
 STATE OF OREGON

EXPIRES: 12/31/24




FROM 17.0 ACRES
 PRIMARY IRRIGATION 1916
 UMATILLA DECREE -
 PRIORITY DATE 1870
 SUPPLEMENTAL IRRIGATION
 CERTIFICATE 96353 -
 PRIORITY DATE JULY 1, 1924



TO 17.0 ACRES
 PRIMARY IRRIGATION 1916
 UMATILLA DECREE -
 PRIORITY DATE 1870
 SUPPLEMENTAL IRRIGATION
 CERTIFICATE 96353 -
 PRIORITY DATE JULY 1, 1924

14300-

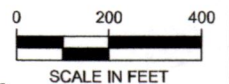

SCALE IN FEET

NOTE:
 THE PURPOSE OF THIS MAP IS TO IDENTIFY THE APPROXIMATE LOCATION OF THE WATER RIGHT. IT IS NOT
 INTENDED TO PROVIDE INFORMATION RELATIVE TO THE LOCATION OF PROPERTY OWNERSHIP BOUNDARY LINES.