



E-RECEIVED
09/11/2023
OWRD

N22.001

Tumalo Irrigation District

2022 Beneficial Use Map T-14135

Certificates: 95175* (IR), 95177 (IS), 95178 (IS), 74149 (IS)
for McClain Revocable Trust

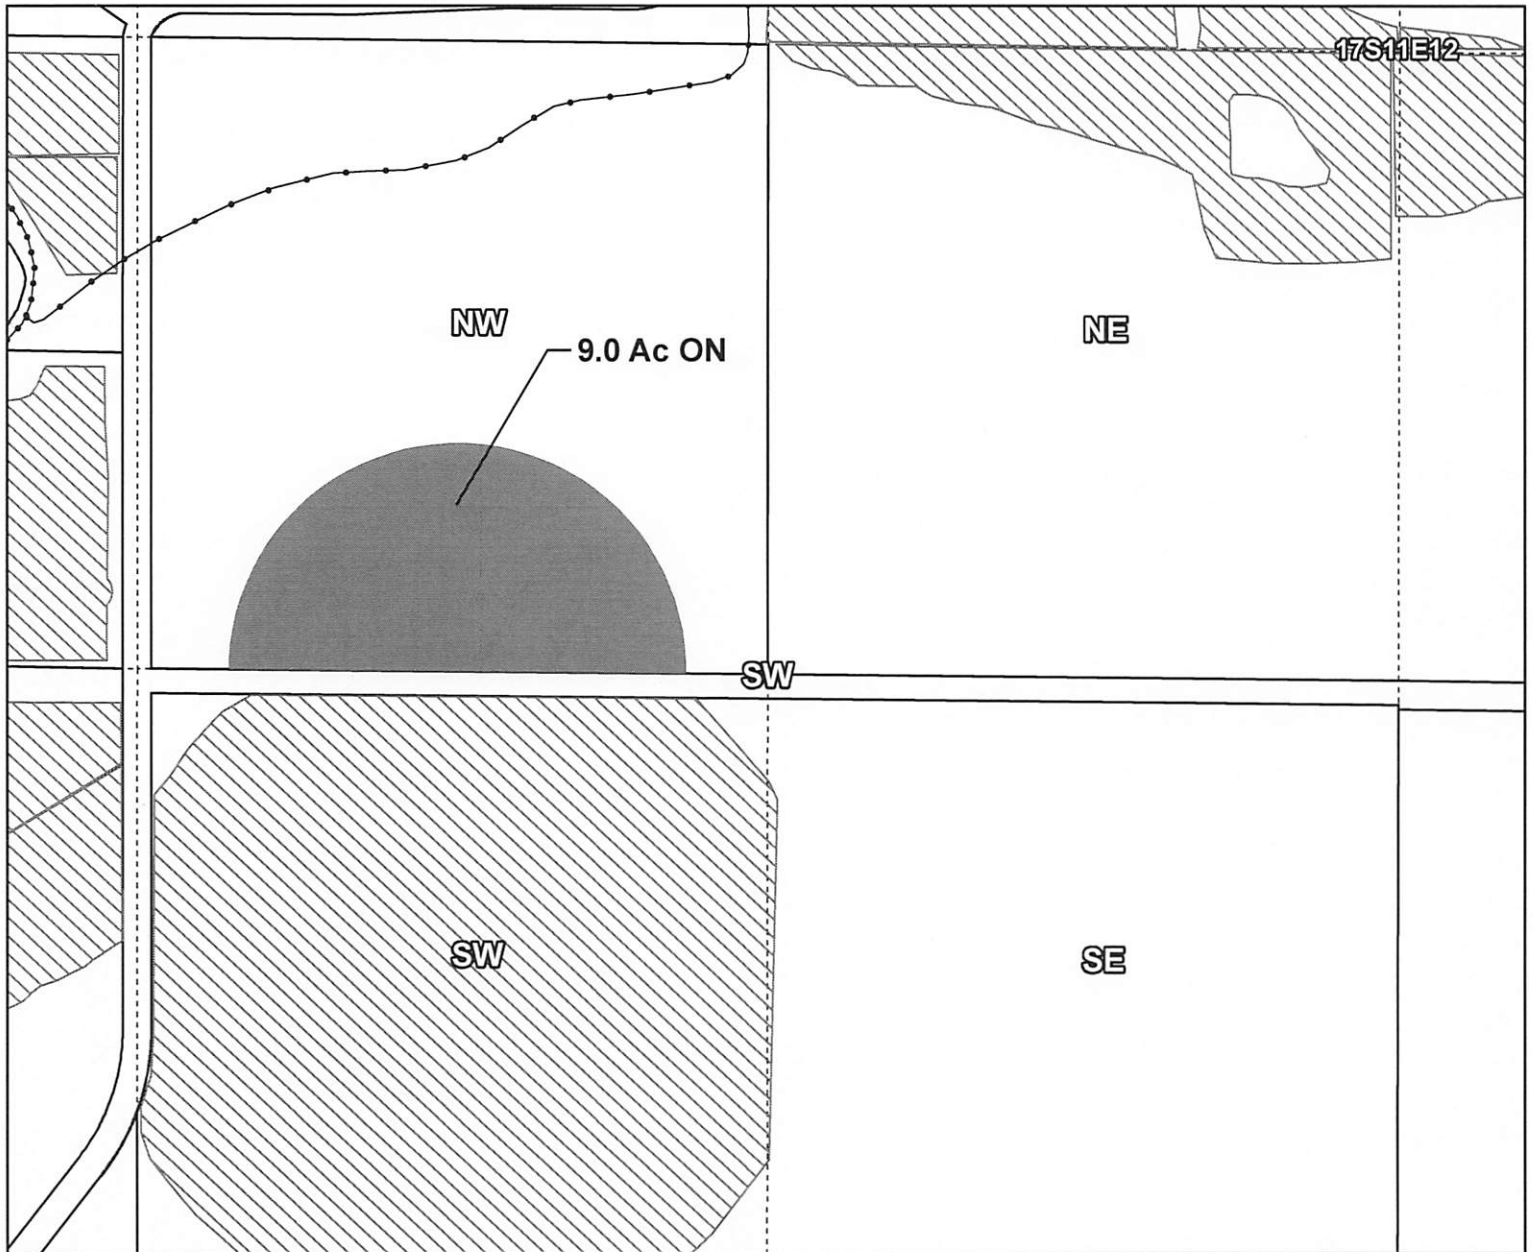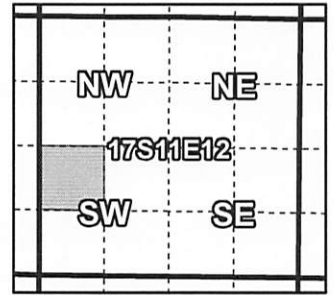

Taxlot 1711120000900, 17-11-12-NW/SW: 9.0 Acres On, 9.0 Acres Total

- Pipelines and Canals
- Transfer
- ▨ Primary Water Right
- Taxlots





1 inch = 400 feet

Prepared by Tumalo Irrigation District | October 2022

Tumalo Irrigation District

2022 Beneficial Use Map T-14135

Certificates: 95175 (IR), 95176 (IS), 95177 (IS), 95178 (IS), 74149 (IS),
79719 (S) for Kingery, John

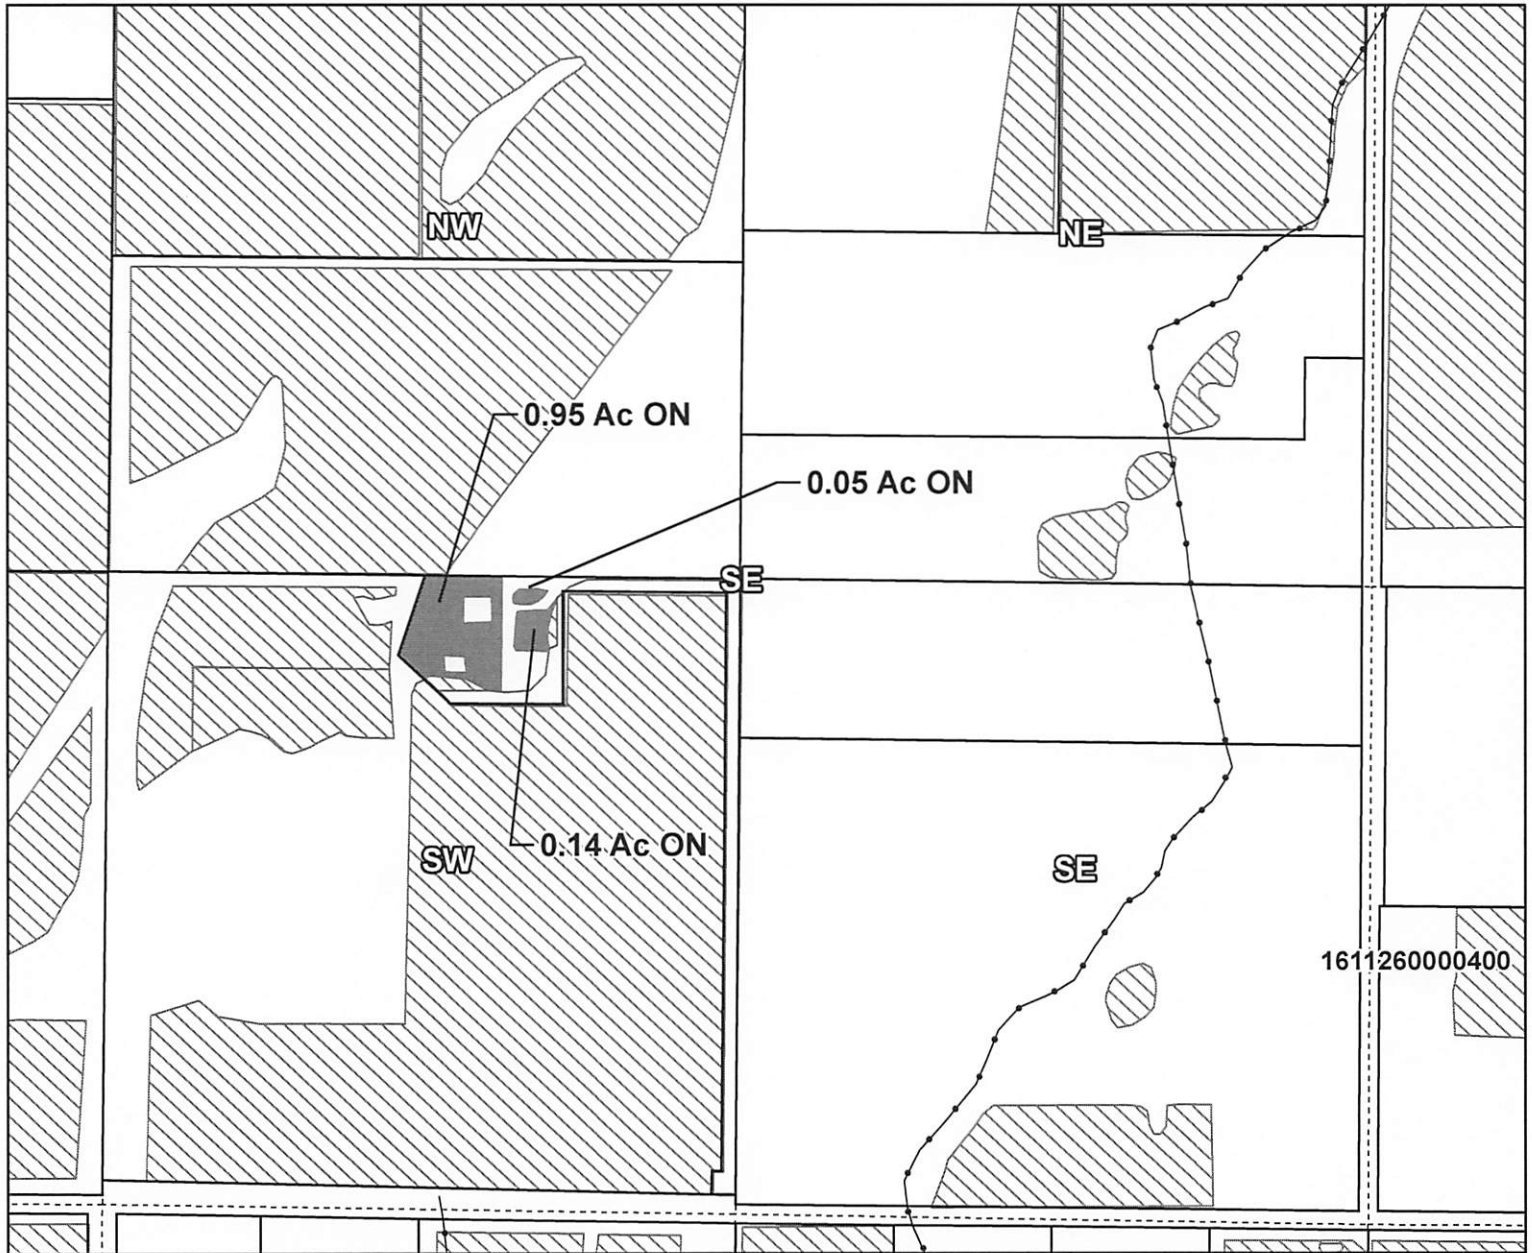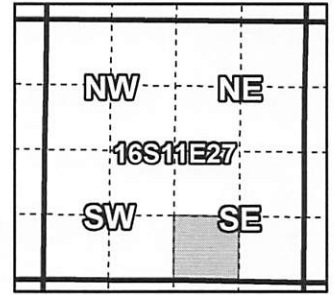

Taxlot 1611270000502, 16-11-27-SW/SE: 1.14 Acres On, 1.48 Acres Total

- Pipelines and Canals
- Transfer
- ▨ Primary Water Right
- Taxlots





1 inch = 400 feet

Tumalo Irrigation District

2022 Beneficial Use Map T-14135

Certificates: 95175 (IR), 95176 (IS), 95177 (IS), 95178 (IS), 74149 (IS)
for Dugan

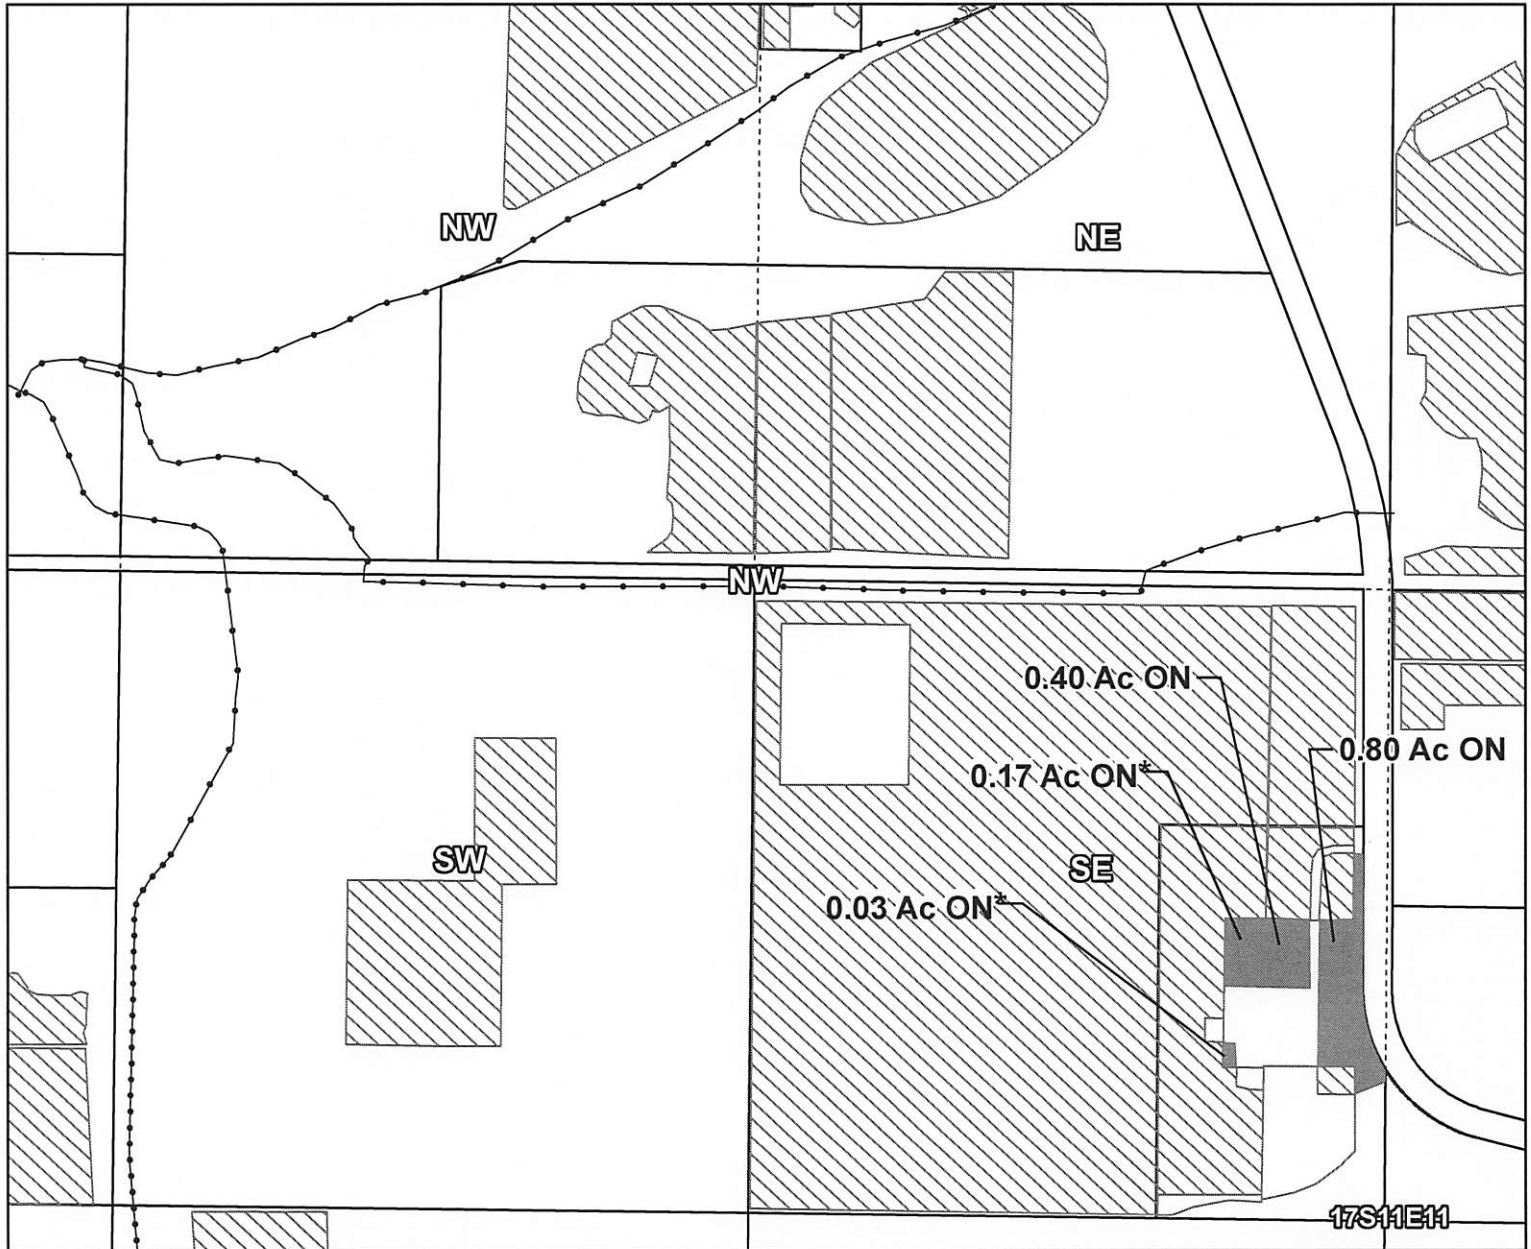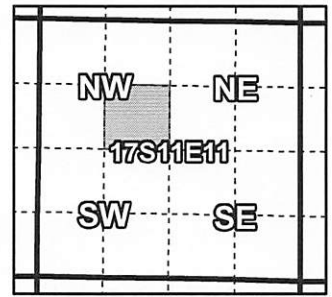

Taxlot 1711110000600, 17-11-11-SE/NW: 1.4 Acres On, 5.35 Acres Total

*Incorporated CW-9 Lands

- Pipelines and Canals
- Transfer
- ▨ Primary Water Right
- Taxlots





1 inch = 400 feet

Tumalo Irrigation District

2022 Beneficial Use Map T-14135

Certificates: 95176 (IR), 95177 (IS), 95178 (IS), 74149 (IS)
for Lahey

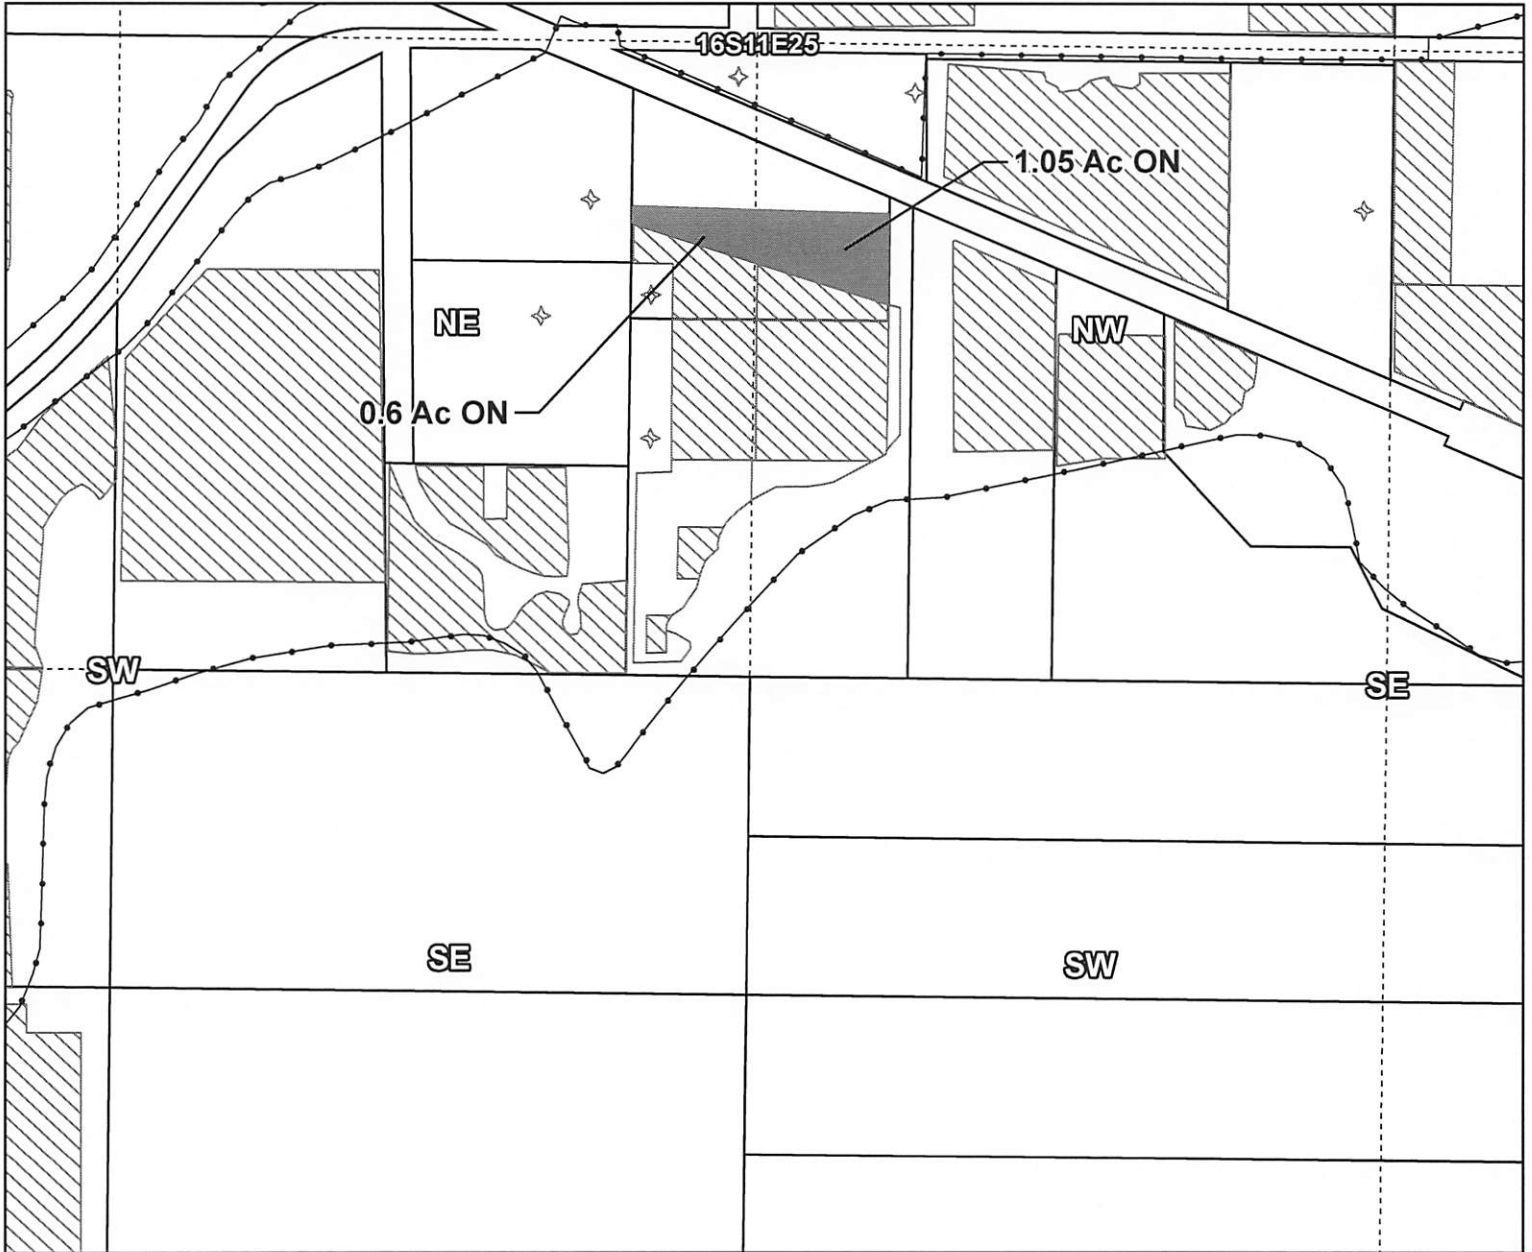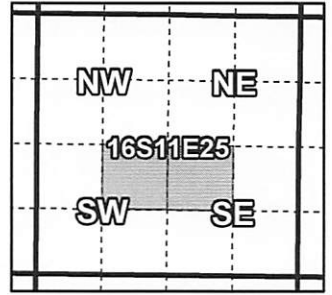

Taxlot 161125000913, 16-11-25-NE/SW: 0.60 Acres On, 1.50 Acres Total
Taxlot 161125000913, 16-11-25-NW/SE: 1.05 Acres On, 1.55 Acres Total

- Pipelines and Canals
- Transfer
- ▨ Primary Water Right
- Taxlots



1 inch = 400 feet

Prepared by Tumalo Irrigation District | October 2022