


RIDGEVIEW IRRIGATION DISTRICT

Final Proof Map for Price Seed Farm T-13886

E-RECEIVED  
09/28/2023  
OWRD

T-13886  
DINN: 2021-0003  
Tax Lot 100 22S46E10 NENW  
ON 1.4 Acres Total

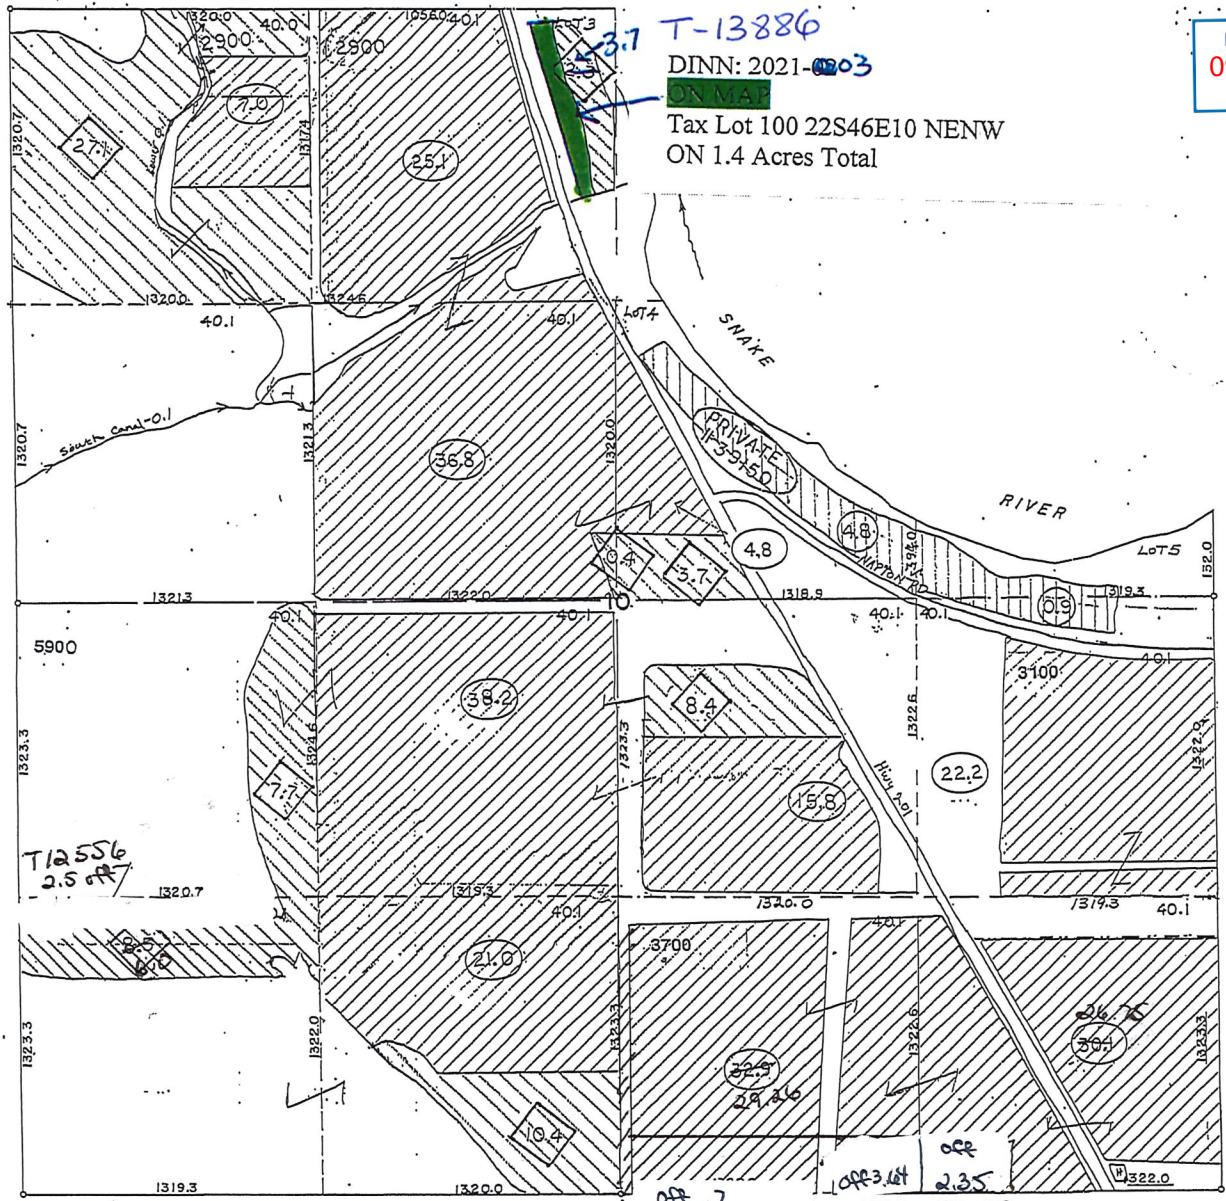

on Area

RECEIVED  
AUG 29 2003  
WATER RESOURCES DEPT.  
SALEM, OREGON

- xx.2  
IRR. ACRES  
IN 1/4 1/4
- IRR. ACRES
- xx.2  
PENDING
- PENDING ACRES
- xx.2  
PRIVATE
- PRIVATE ACRES
- PROPERTY LINE IF  
OTHER THAN 1/4 1/4

Now Approved



SCALE: 1" = 400'

SOUTHWEST CORNER  
OF SECTION 10

on T-12233  
off 7 T-12233  
off 3.44 T-12233  
off 2.35 T-12233  
SEC. 10, T.22 S., R.46 E., W.M. 48-102-1552

Traced: RWR 4-15-53  
Checked: RE 6-20-55

# RIDGEVIEW IRRIGATION DISTRICT

## Final Proof Map For Paul Shenk T-13886



T-13886  
 DINN:2021-02  
 ON AREA  
 Tax Lot 100 22S46E36 SWNE  
 ON 4.0 Acres Total

E-RECEIVED  
 09/28/2023  
 OWRD

ON AREA

- 22.2
- 22.2 ACRES IN 1/4 1/4
- 22.2
- 22.2 ACRES
- 22.2
- PENDING
- 22.2
- PENDING ACRES
- 22.2
- PRIVATE
- 22.2
- PRIVATE ACRES

Now Approved Inc.



SCALE: 1" = 400'

SEC. 36, T:22 S., R.46 E., W.M.

48-102-1572

Traced: R.E. 6-13-55  
 Checked: H.G. 6-21-55