


Vale Oregon Irrigation District

CLAIM OF BENEFICIAL USE


T 20 R 41 Sec 12


ALLAIRE

E-RECEIVED
10/24/2023
OWRD

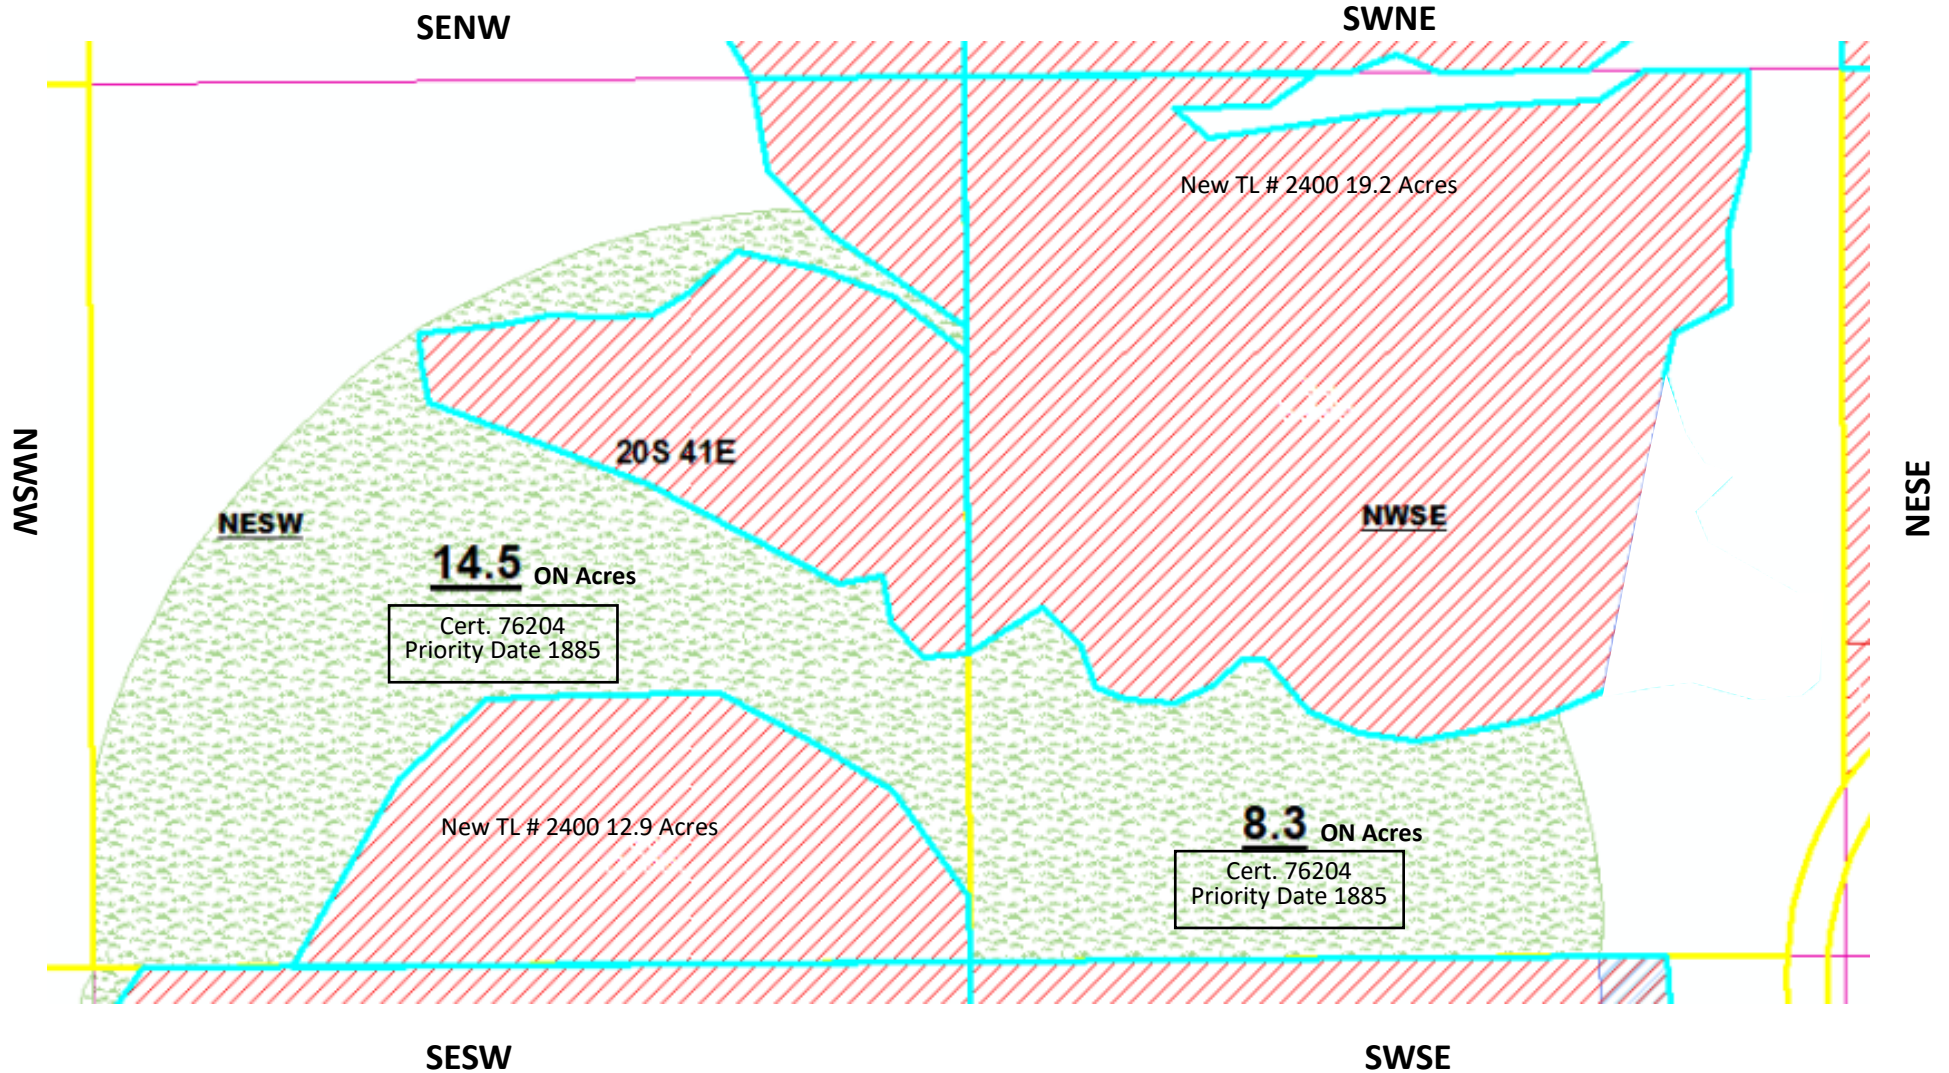

Legend

 BA_Remaining_ 21.1 Acres

 BA_On_ 22.8 Acres

Certificate: 76204 (IR)
74080 (IS)
74081 (IS)

Claim of Beneficial Use Transfer	
Tax Lot #2400	On Acres
	22.8




Vale Oregon Irrigation District

CLAIM OF BENEFICIAL USE

T 20 R 41 Sec 12

ALLAIRE

E-RECEIVED
10/24/2023
OWRD

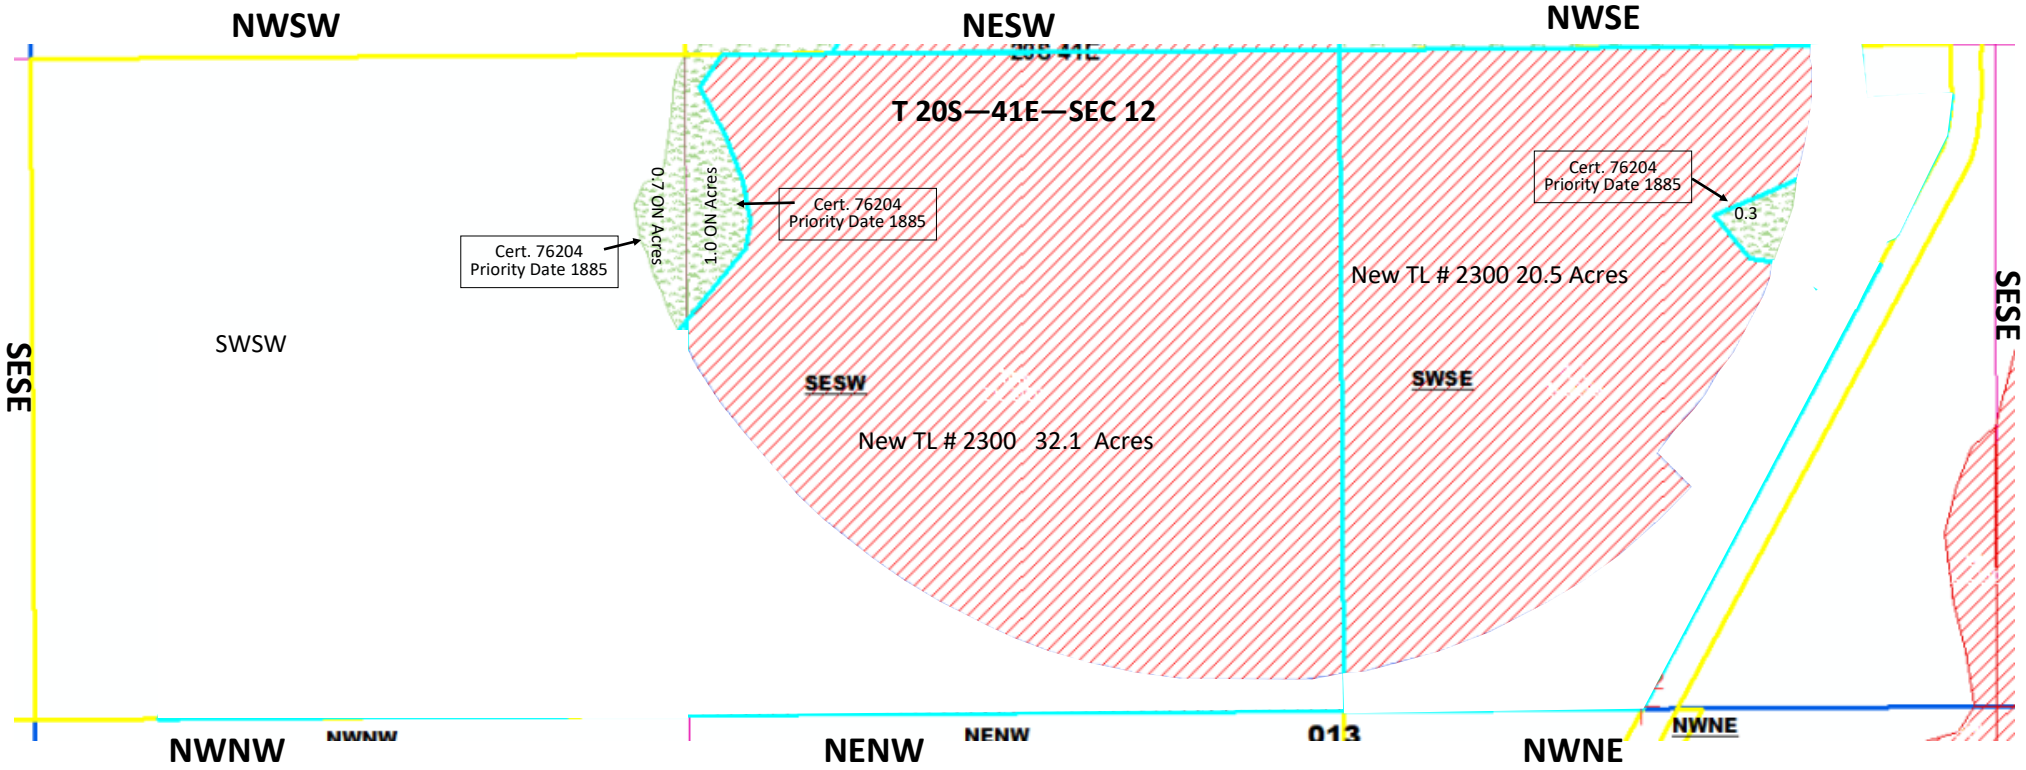

Legend

- BA_Remaining_ 52.6 Acres
- BA_On_ 2.0 Acres

Certificate: 76204 (IR)
74080 (IS)
74081 (IS)

Claim of Beneficial Use Transfer	
	On
Tax Lot #2300	2.0




Vale Oregon Irrigation District

T 18 R 44 Sec 23

Craig Hiatt 2.0 Acres

E-RECEIVED
10/24/2023
OWRD

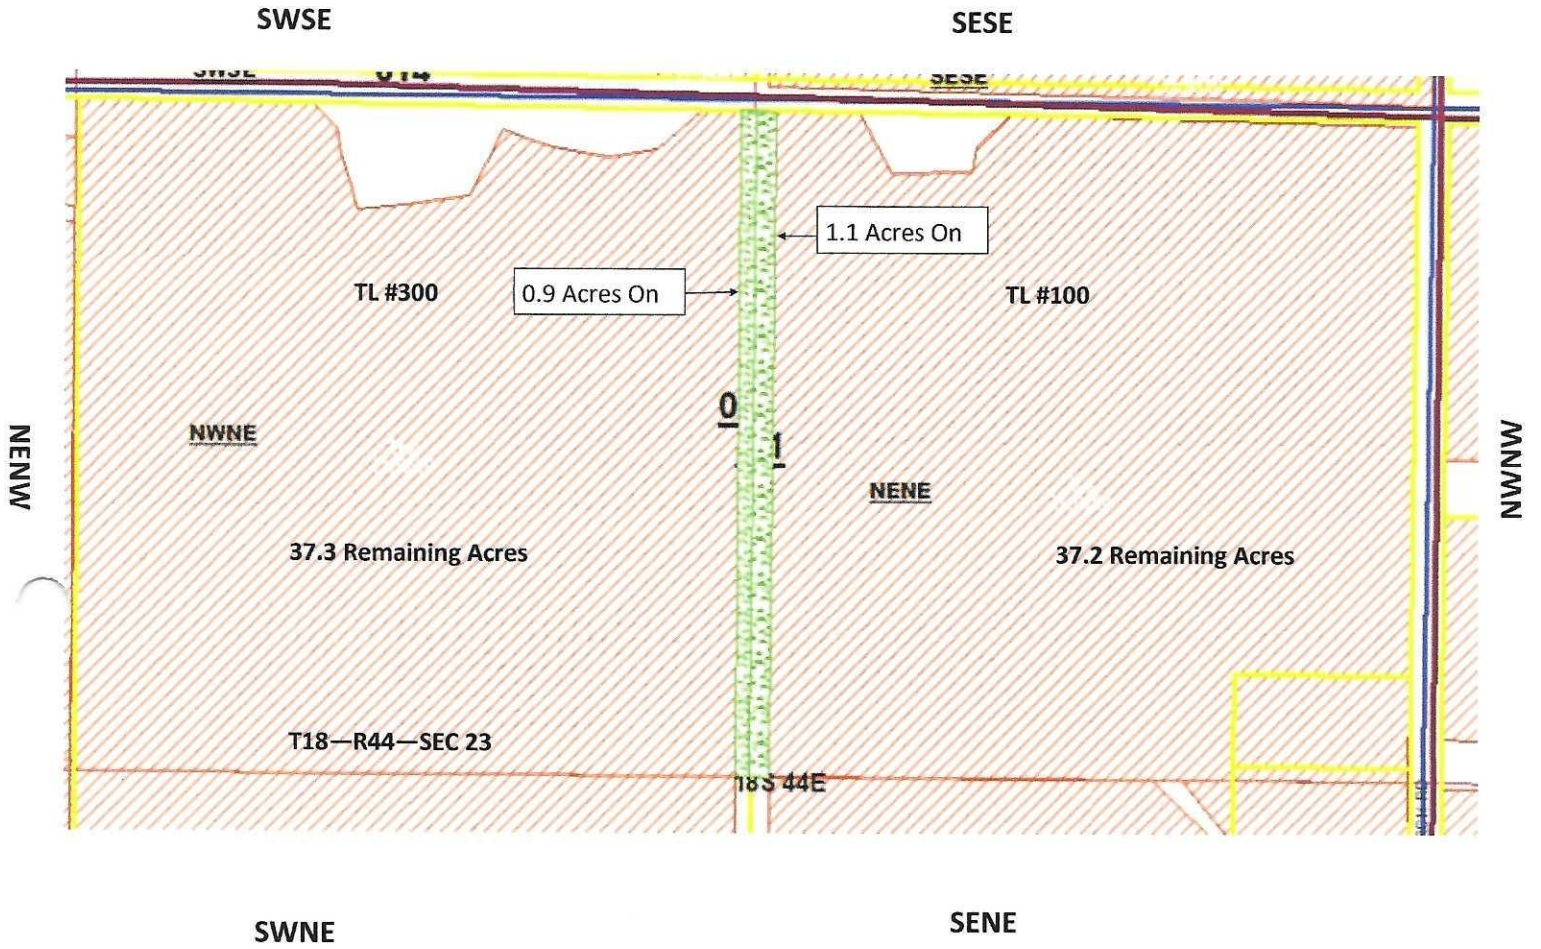

Legend

- CH_Remaining_ 74.5 Acres
- CH_To_ 2.0 Acres

Certificate: 74080 IR
74081 (IS)

Claim of Beneficial Use Transfer

Tax Lot #300	0.9 acres on
Tax Lot #100	1.1 acres on