


T.5S. R.1E. Sec. 1 & 12, W.M.

RECEIVED

JAN 26 2024

OWRD

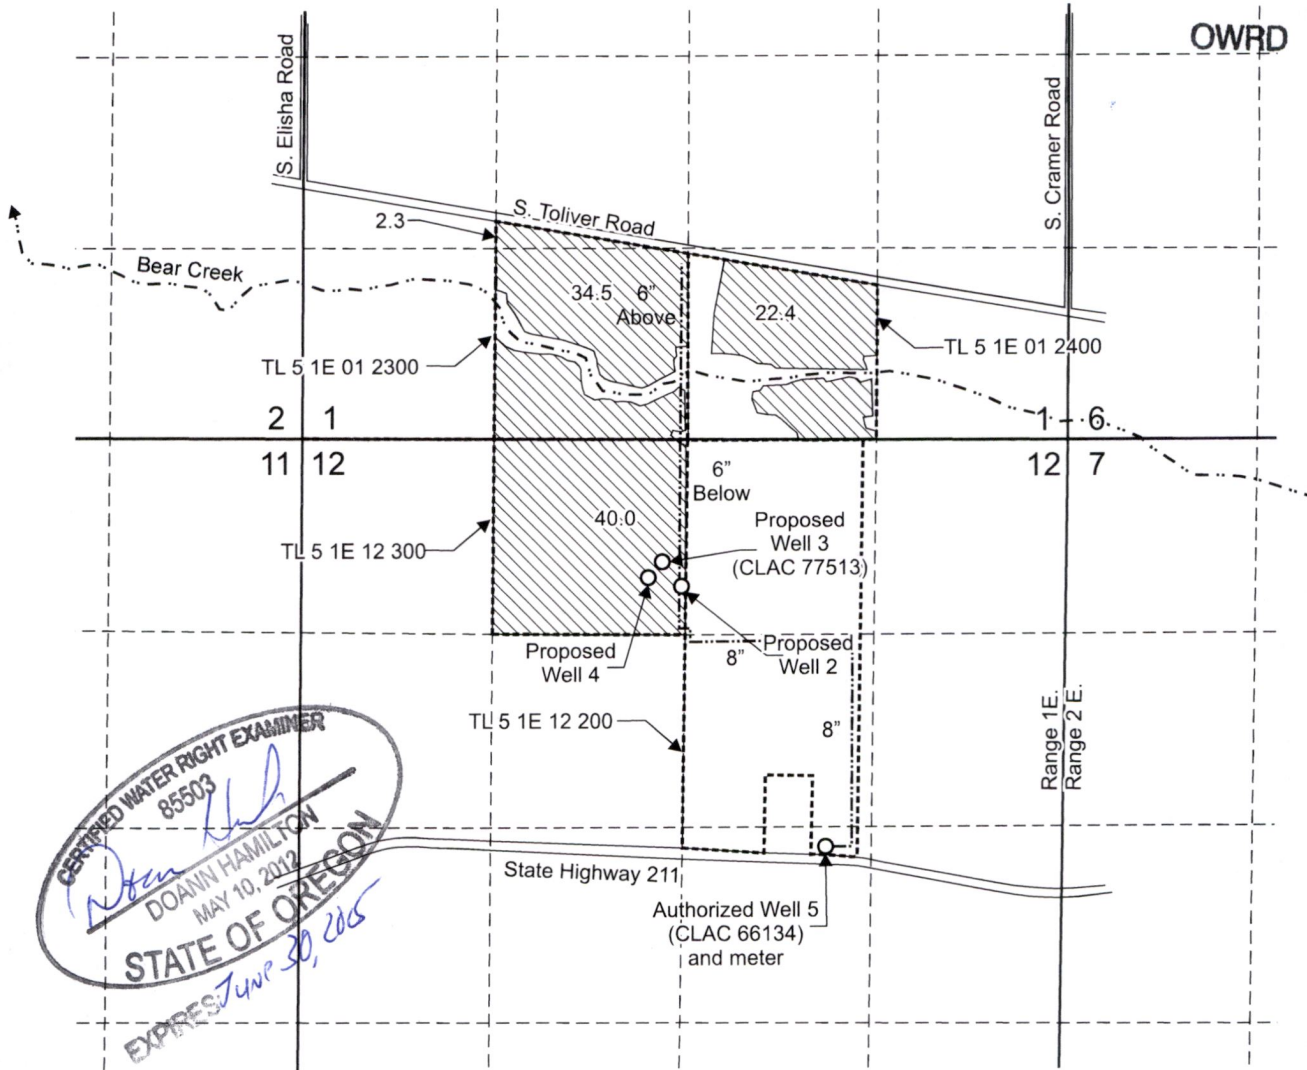

CERTIFIED WATER RIGHT EXAMINER
 85503
Doan Hamilton
 DOAN HAMILTON
 MAY 10, 2012
STATE OF OREGON
 EXPIRES *June 30, 2015*

Authorized Well 5 (CLAC 66134) is located 2,750 feet south and 1,660 feet west from the NE corner, Section 12.
 Proposed Well 2 is located 1,005 feet south and 2,610 feet east from the NW corner, Section 12.
 Proposed Well 3 (CLAC 77513) is located 840 feet south and 2,475 feet east from the NW corner, Section 12.
 Proposed Well 4 is located 945 feet south and 2,380 feet east from the NW corner, Section 12.

- Area (99.2 Acres) irrigated under Certificate 97364, priority date: 11-29-2001.
- Tax lot boundary
- Irrigation mainline

Scale: 1" = 1,320'



This map was prepared for the purpose of identifying the location of a water right only and is not intended to provide legal dimensions or location of property ownership lines.



Transfer Application Map Certificate 97364

Bradley and Mary Gilbert
 T.5S. R.1E. Sec. 1 & 12, W.M.

Pacific Hydro-Geology Inc.

12/2023