


Tumalo Irrigation District


2023 "Beneficial Use" Map

E-RECEIVED
03/22/2024
OWRD

N23.001

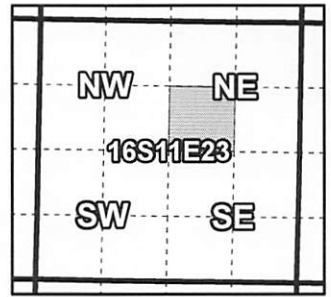

Certificates: 95175 (IR), 95176 (IR), 95176 (IS), 95177 (IS), 95178 (IS), 74149 (IS)
for DANIELS, JONATHAN AND ANNA

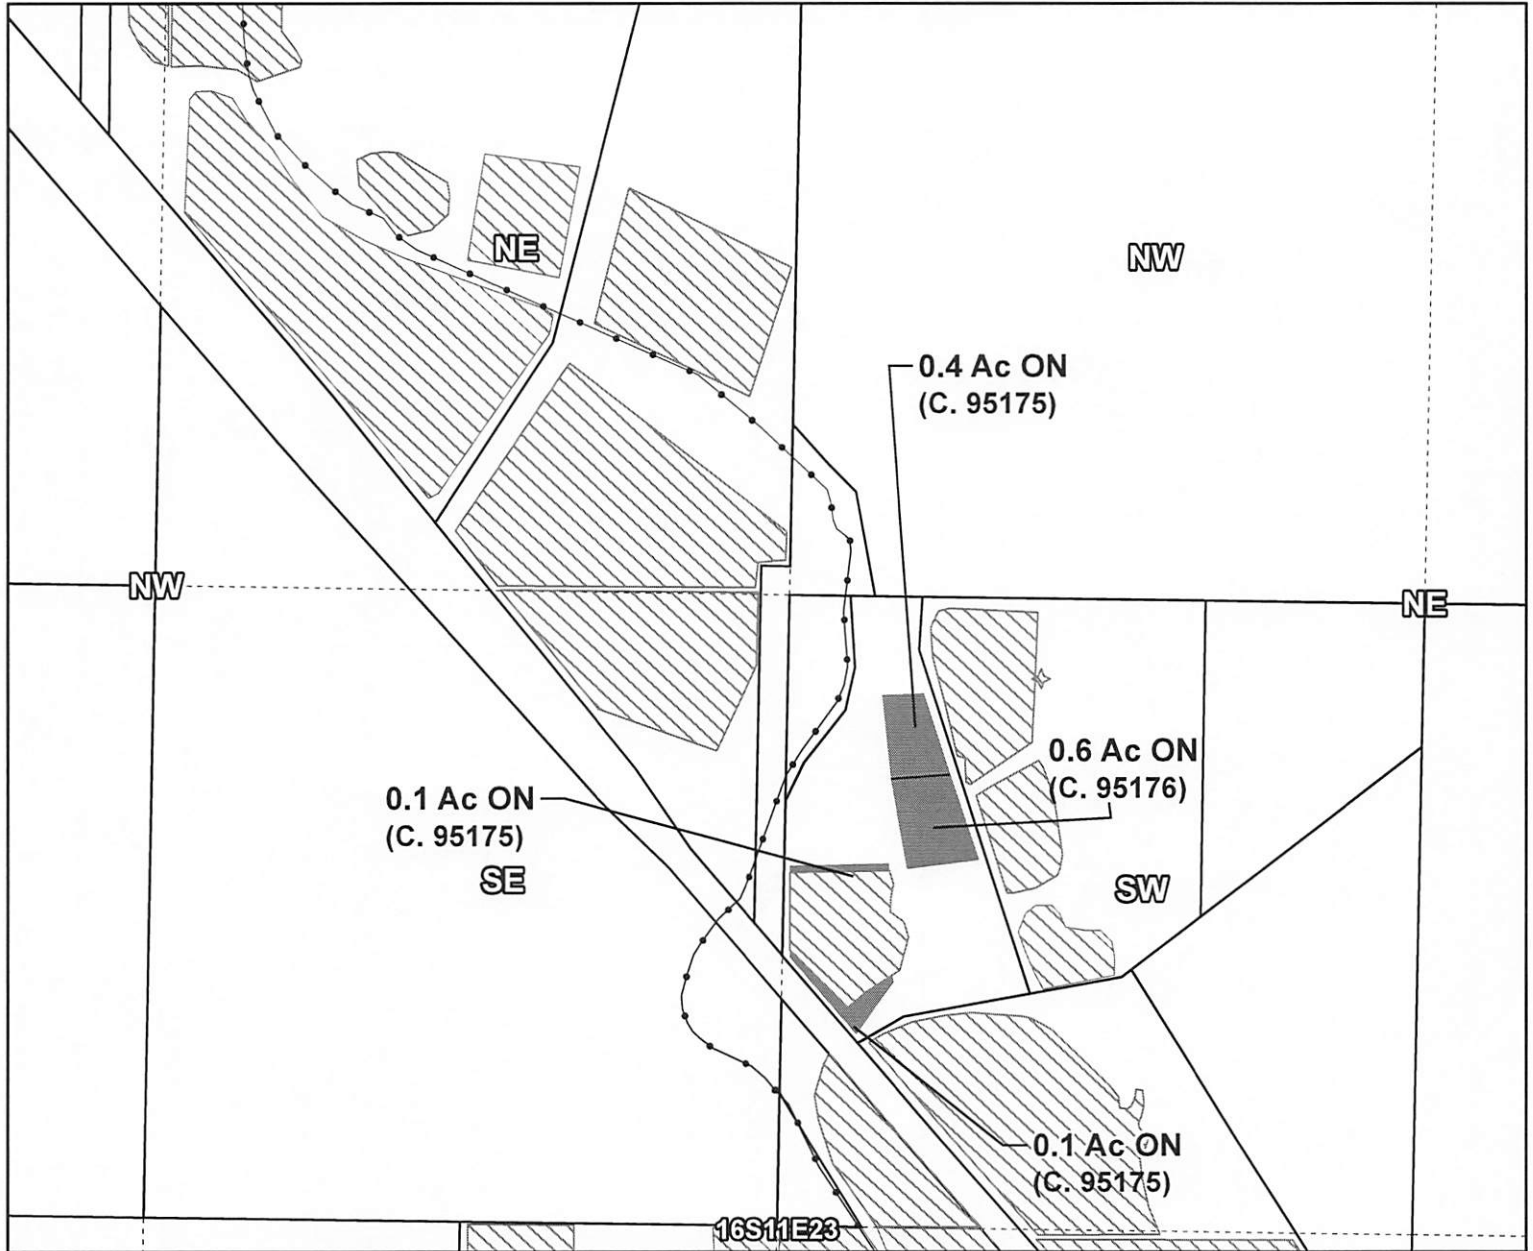

Taxlot 1611230000503, 16-11-23-SW/NE: 1.2 Acres On, 2.7 Acres Total
 Cert #: 95175 Date: 08-05-1900, 0.6 acres
 Cert #: 95176 Date: 10-29-1913, 0.6 acres

- Pipelines and Canals
- Transfer
- Primary Water Right
- Taxlots




1 inch = 400 feet

Prepared by Tumalo Irrigation District | August 2023

Tumalo Irrigation District 2023 "Beneficial Use" Map

Certificates: 95176 (IR), 95177 (IS), 95178 (IS), 74149 (IS)
for MICHAEL AND SANDRA SKIENS

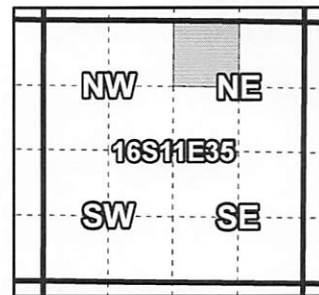

Taxlot 1611350000800, 16-11-35-NW/NE: 1.5 Acres On, 7.9 Acres Total



- Pipelines and Canals
- Transfer
- Primary Water Right
- Taxlots



1 inch = 400 feet

Tumalo Irrigation District 2023 "Beneficial Use" Map

Certificates: 95176 (IR), 95177 (IS), 95178 (IS), 74149 (IS)
for ARNOLD, DAVID AND REBECCA

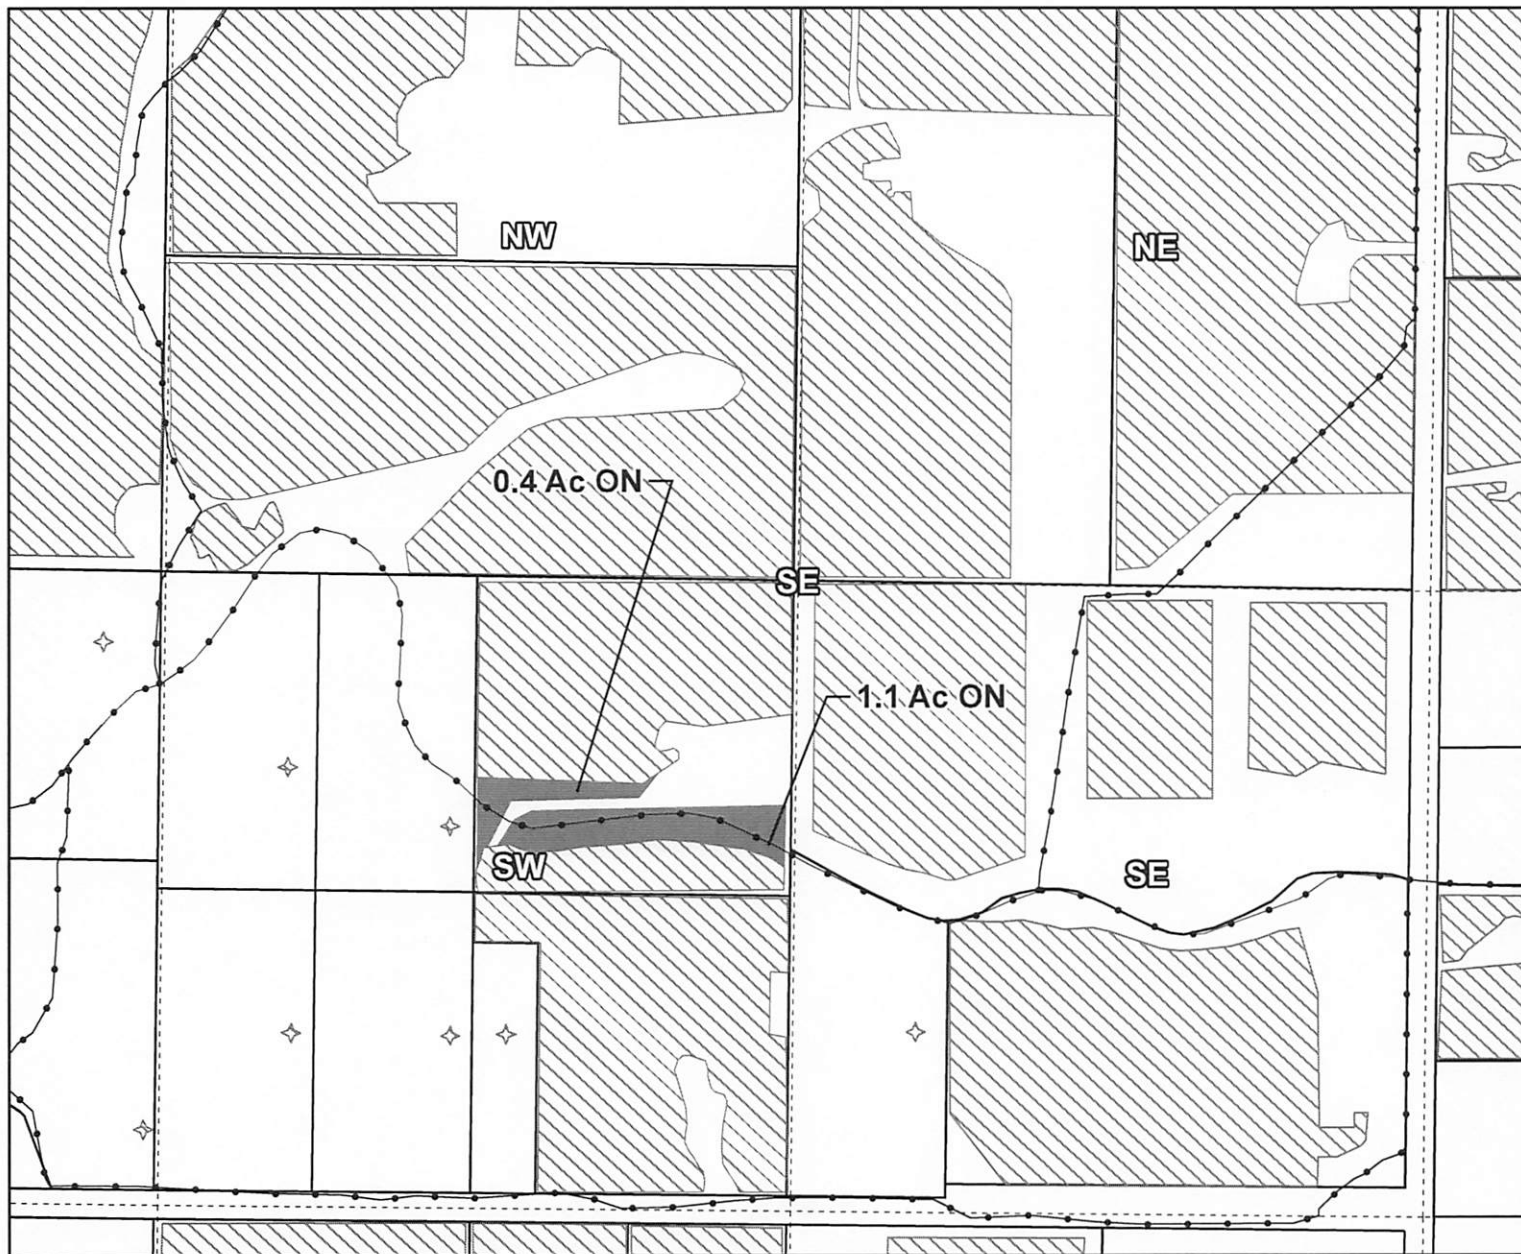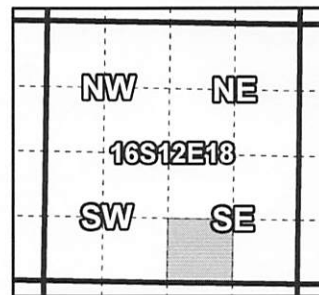

Taxlot 1612180001500, 16-12-18-SW/SE: 1.5 Acres On, 8.5 Acres Total

- Pipelines and Canals
- Transfer
- ▨ Primary Water Right
- Taxlots





1 inch = 400 feet

E-RECEIVED
03/22/2024
OWRD

N23.003

Tumalo Irrigation District 2023 "Beneficial Use" Map

Certificates: 95175 (IR), 95176 (IS), 95177 (IS), 95178 (IS), 74149 (IS)
for POWELL, KATHY

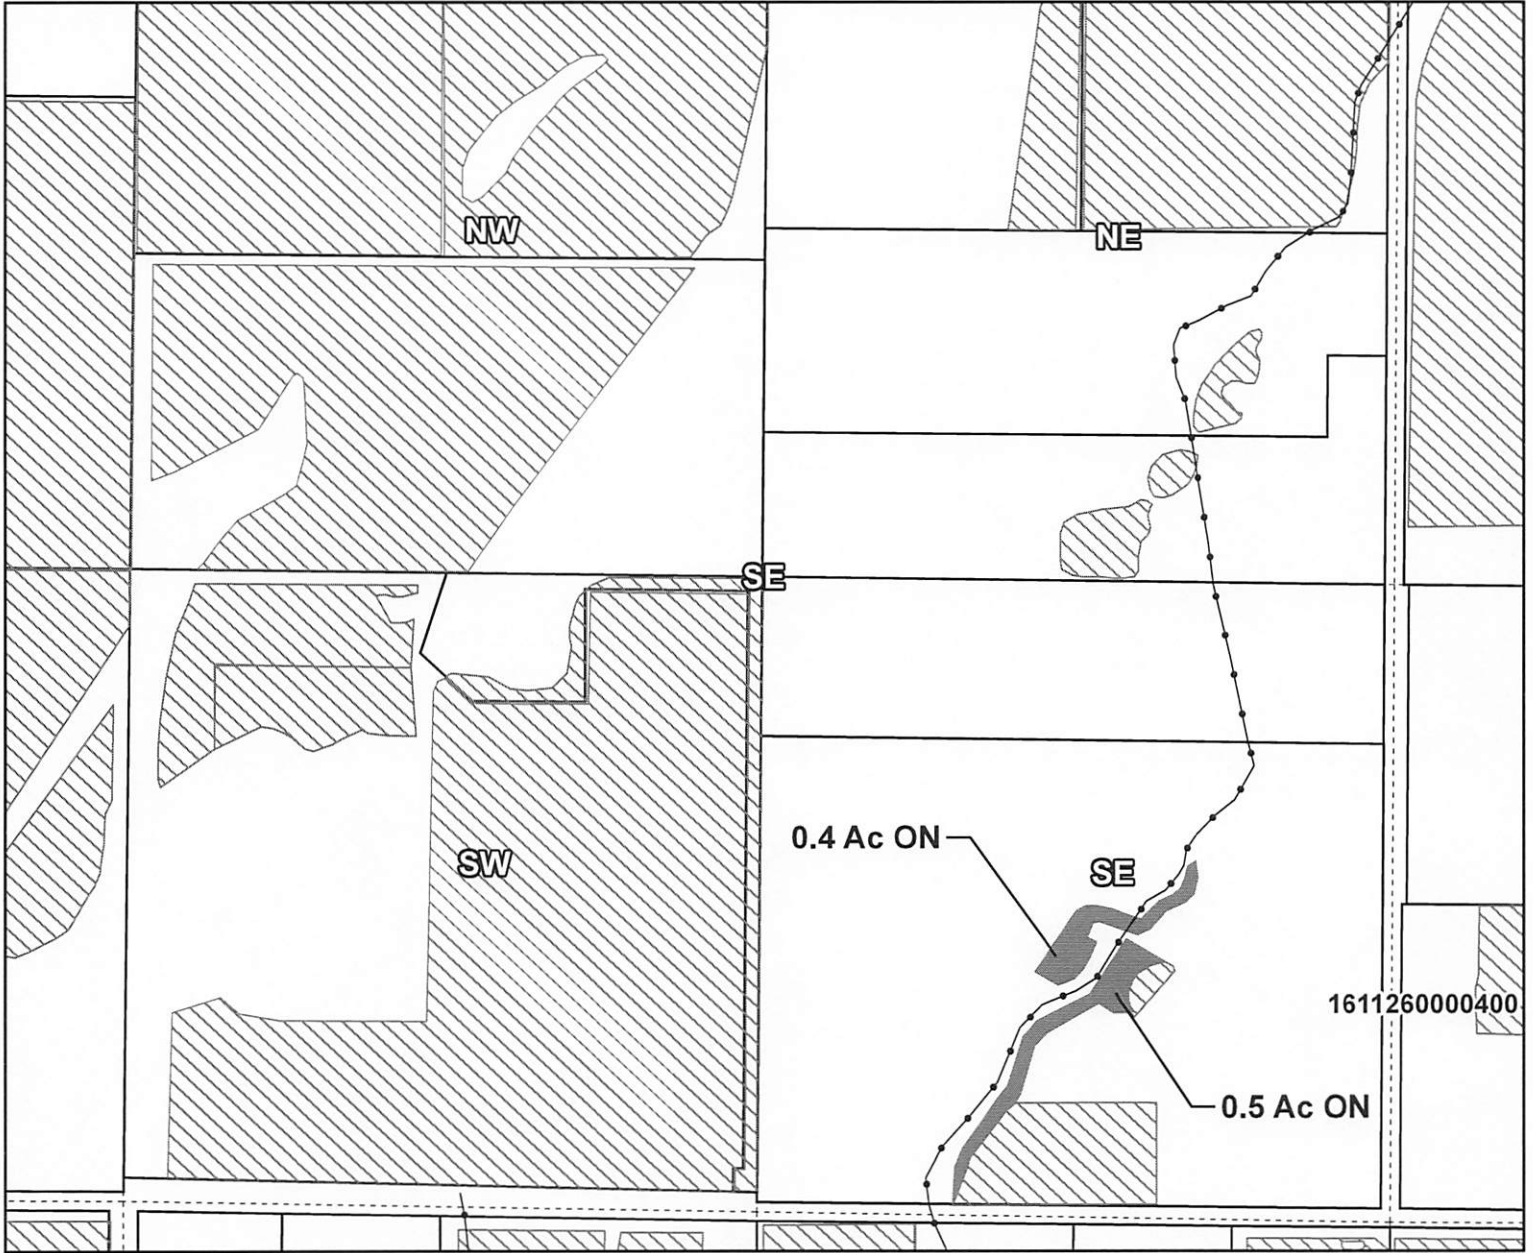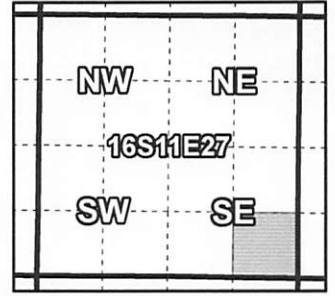

Taxlot 1611270000603, 16-11-27-SE/SE: 0.9 Acres On, 3.0 Acres Total

- Pipelines and Canals
- Transfer
- Primary Water Right
- Taxlots



1 inch = 400 feet


Prepared by Tumalo Irrigation District | August 2023

Tumalo Irrigation District


2023 "Beneficial Use" Map

E-RECEIVED
03/22/2024
OWRD

N23.004

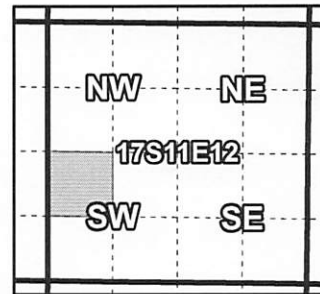

Certificates: 95175* (IR), 95177 (IS), 95178 (IS), 74149 (IS) for
MCCLAIN REVOCABLE TRUST

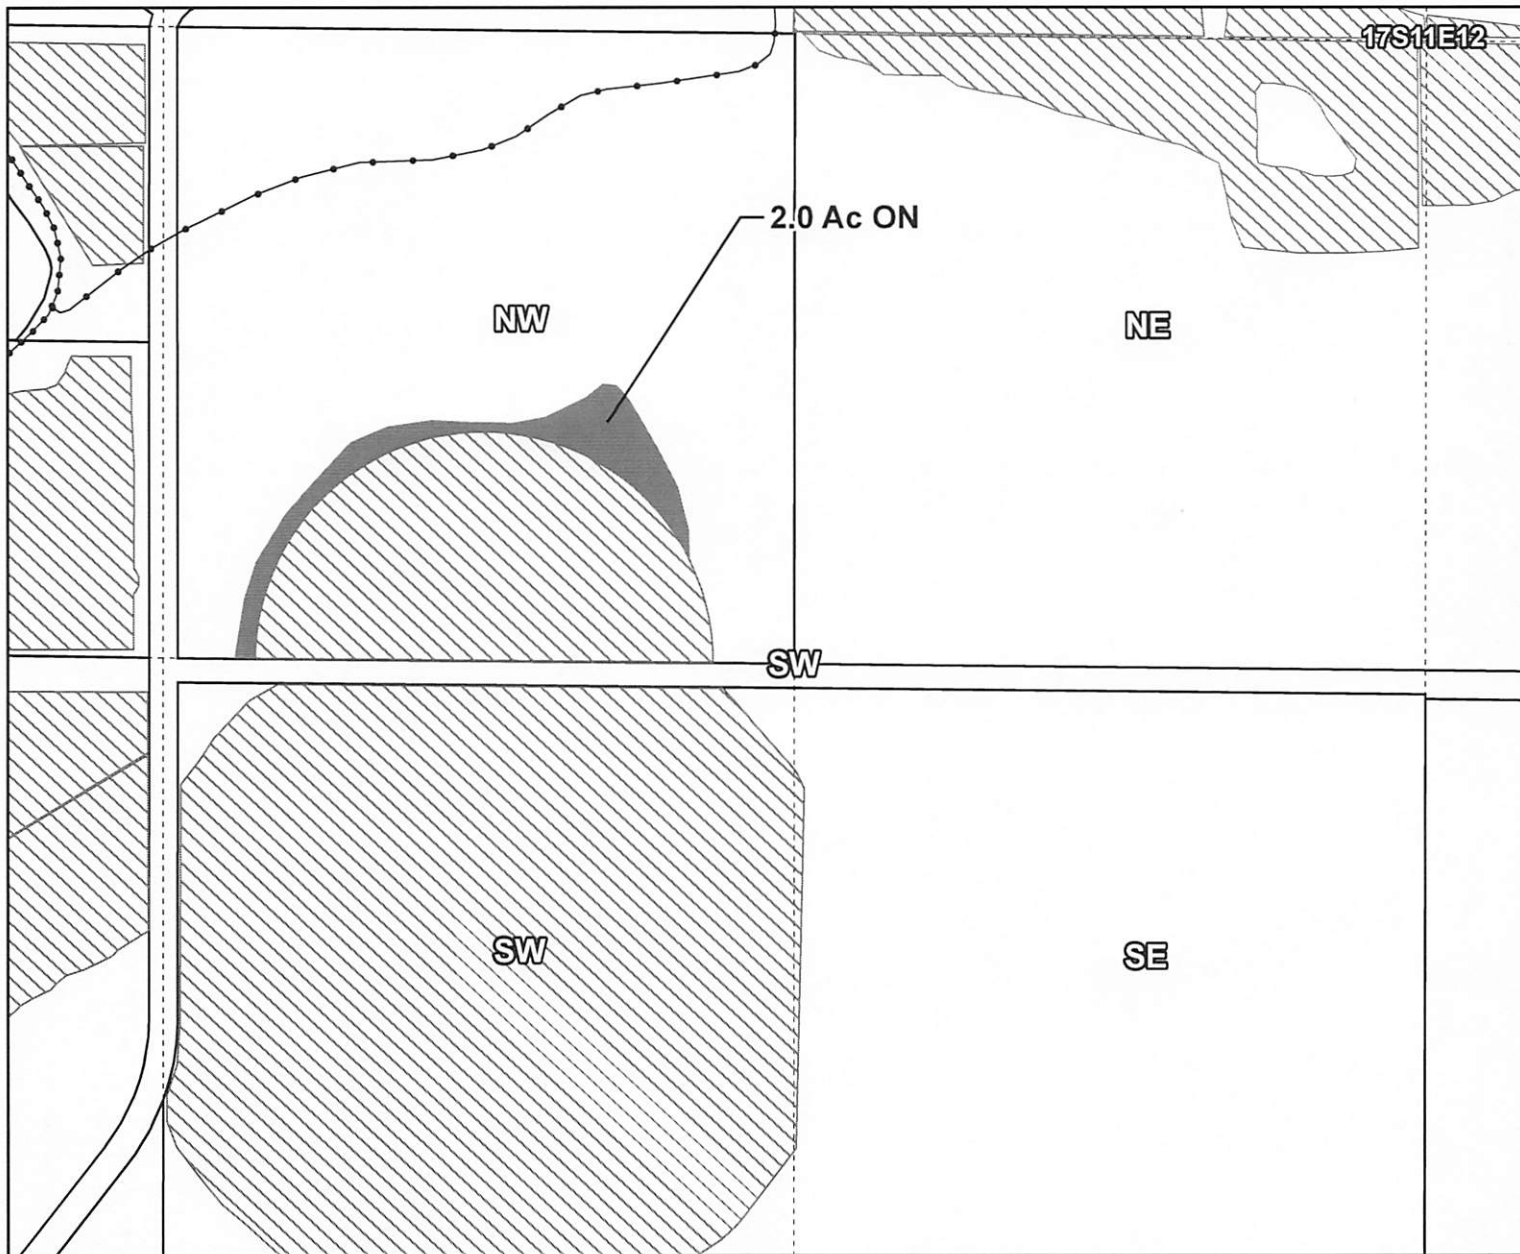

Taxlot 1711120000900, 17-11-12-NW/SW: 2.0 Acres On, 11.0 Acres Total
*Incorporated CW-9 Lands

- Pipelines and Canals
- Transfer
- ▨ Primary Water Right
- Taxlots




1 inch = 400 feet

Prepared by Tumalo Irrigation District | August 2023

Tumalo Irrigation District 2023 "Beneficial Use" Map

Certificates: 95175 (IR), 95176 (IS), 95177 (IS), 95178 (IS), 74149 (IS)
for SIR EDWARD LLC

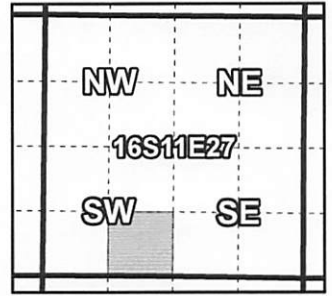

Taxlot 161127000401, 16-11-27-SE/SW: 0.45 Acres On, 27.97 Acres Total

- Pipelines and Canals
- Transfer
- Primary Water Right
- Taxlots



1 inch = 400 feet


E-RECEIVED
03/22/2024
OWRD

N23.005

Tumalo Irrigation District

2023 "Beneficial Use" Map

Certificates: 95175 (IR), 95176 (IS), 95177 (IS), 95178 (IS), 74149 (IS)
for HERMELING-BUCKENDORF, SHOSHANA

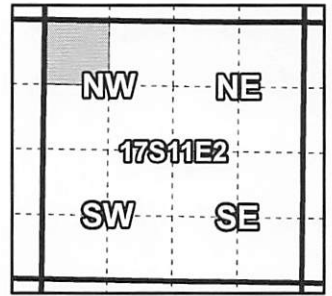

Taxlot 1711020000300, 17-11-02-NW/NW: 2.7 Acres On, 23.25 Acres Total
Taxlot 1711020000301, 17-11-02-NW/NW: 0.2 Acres On, 0.2 Acres Total
Cert #: 95175 Date: 06-01-1907, 0.95 acres
Cert #: 95175 Date: 09-01-1900, 1.95 acres

- Pipelines and Canals
- Transfer
- ▨ Primary Water Right
- Taxlots



1 inch = 400 feet

Prepared by Tumalo Irrigation District | August 2023