

58-3

Received
APR 22 2024
OWRD

Well where
water is
moving to





WASHINGTON COUNTY OREGON
SECTION 25 T1S R3W W.M.
SCALE 1" = 400'

36	31	32	33	34	35	36	31
1	6	5	4	3	2	1	6
12	7	8	9	10	11	12	7
13	18	17	16	15	14	13	18
24	19	20	21	22	23	24	19
25	30	29	28	27	26	25	30
36	31	32	33	34	35	36	31
1	6	5	4	3	2	1	6

FOR ADDITIONAL MAPS VISIT OUR WEBSITE AT
www.co.washington.or.us

BB	BA	AB	AA
B		A	
BC	BD	AC	AD
CB	CA	DB	DA
C		D	
CC	CD	DC	DD

Cancelled Taxlots For: 1S325
1700-1711, 1800, 1901, 1900, 1901, 2000-2009, 2100,
2200, 2300, 2400, 2401, 3500, 3501, 3600, 3700,
3800-3806, 3900-3905, 4000, 4100, 4101, 4200, 4300,
4400, 4500, 4600, 2500, 2600, 2900, 100, 1103, 4900,
104.

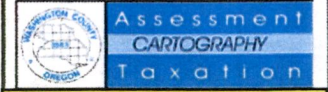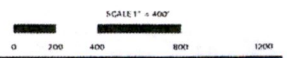

KEY TO WATER RIGHTS TRANSFER

- 10 Acres Total
- Taxlot
- Existing POU (10 Acres Total)
- Proposed Temporary POU (1.05 Acres)
- Existing POU Left Unchanged (8.95 Acres)
- Well