







Transfer Application - McKee - Certificate 23923

Township 9S, Range 5W, Section 16, W.M.

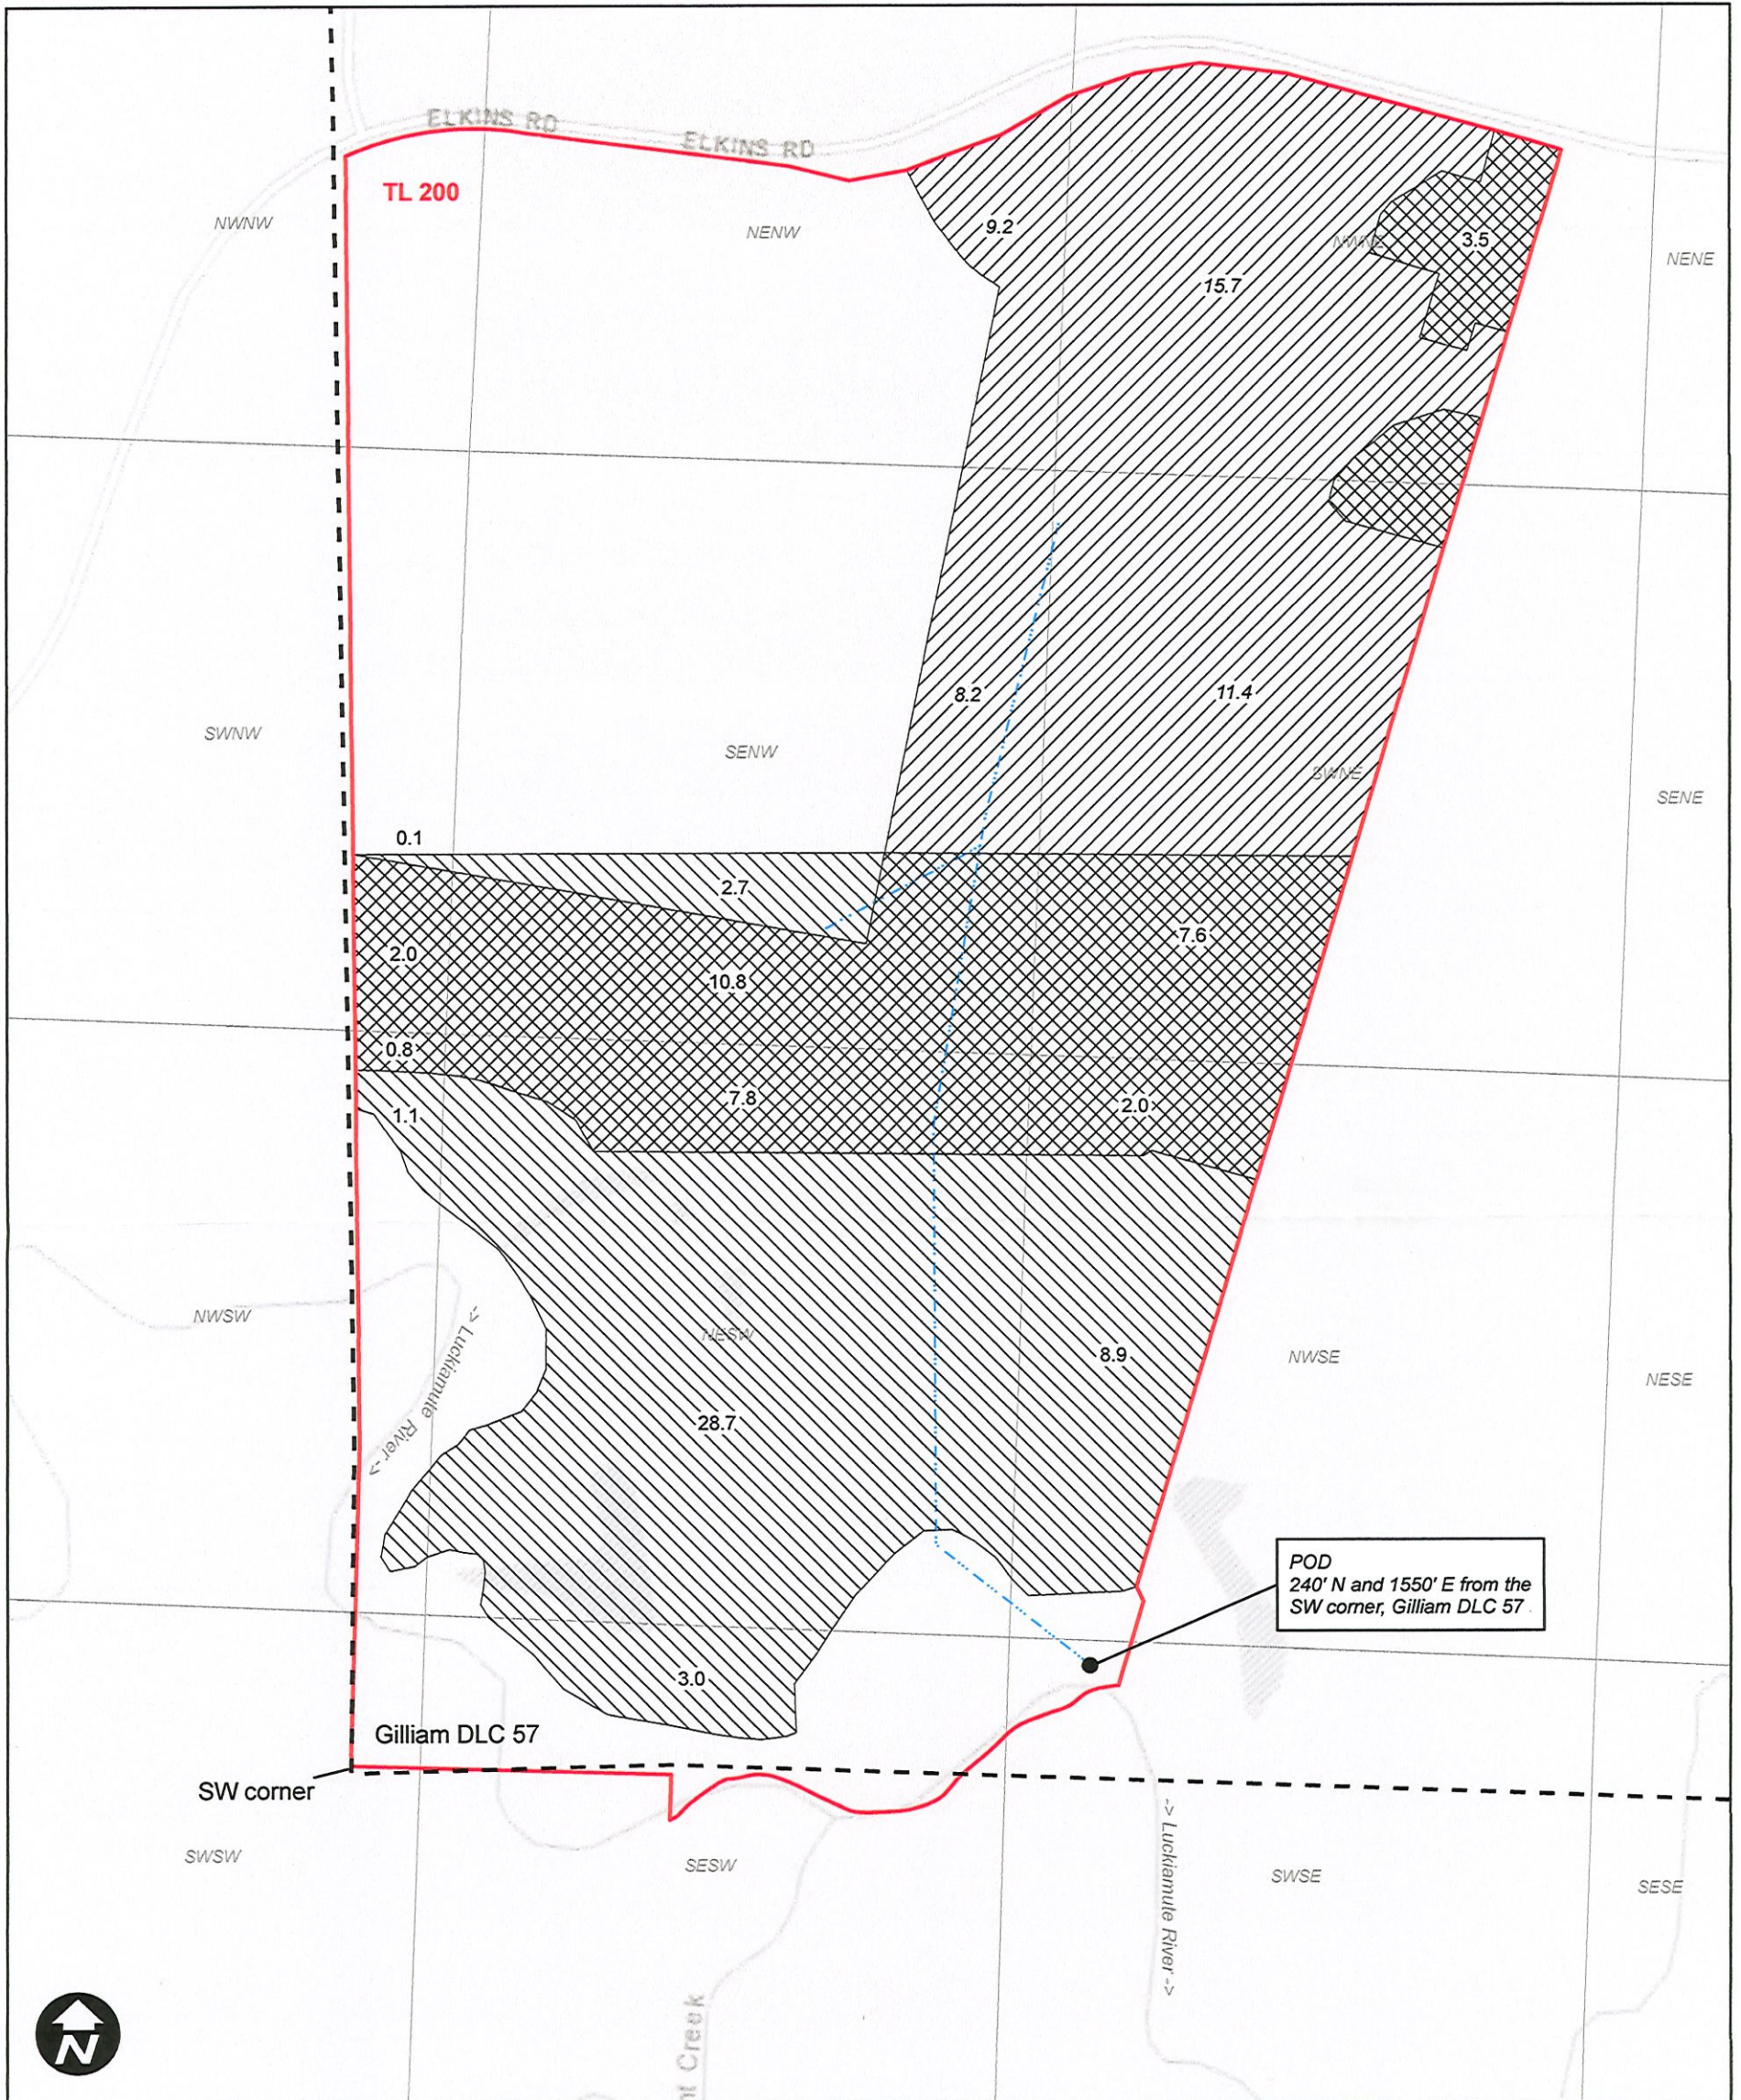


Legend

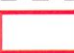-  Cert. 23923 From
-  Cert. 23923 No Change
-  Cert. 23923 To
-  Mainline
-  DLC
-  Taxlot




Transfer Application - McKee - Certificate 45701

Township 9S, Range 5W, Section 16, W.M.

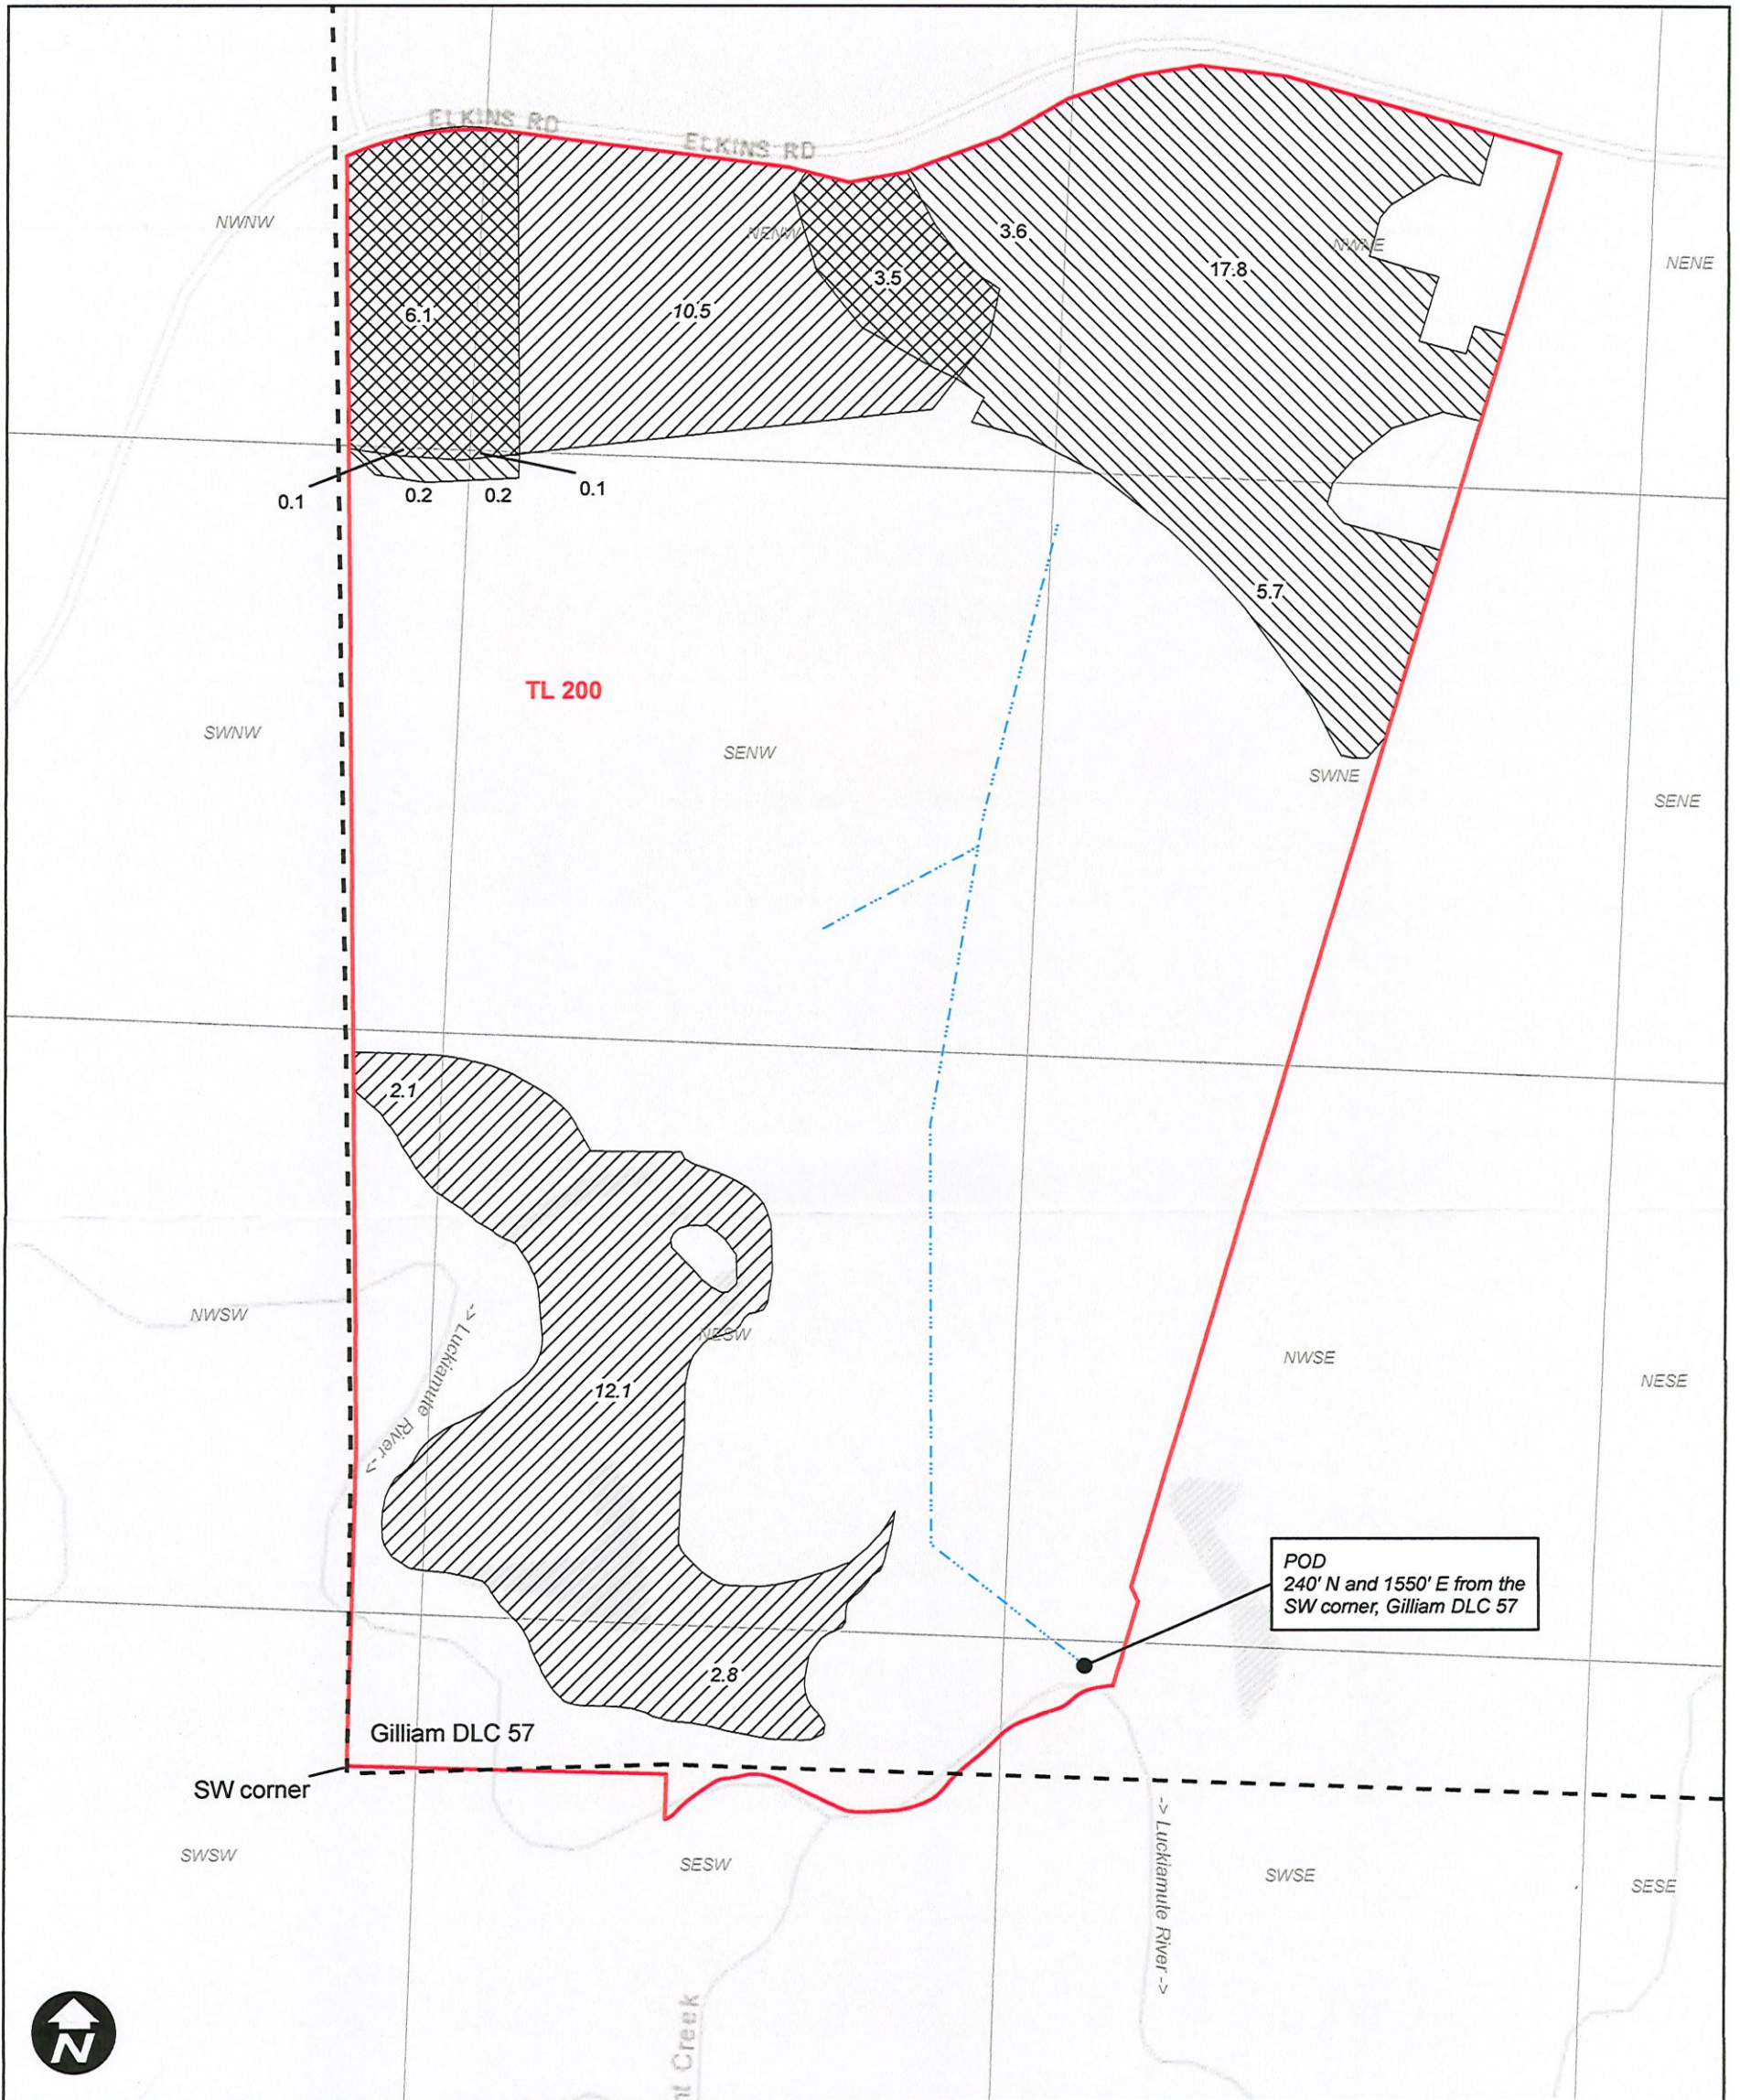


Legend

-  Cert. 45701 From
-  Cert. 45701 No Change
-  Cert. 45701 To
-  Mainline
-  DLC
-  Taxlot

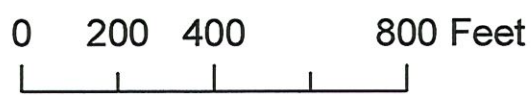

Transfer Application - McKee - Certificate 32589

Township 9S, Range 5W, Section 16, W.M.

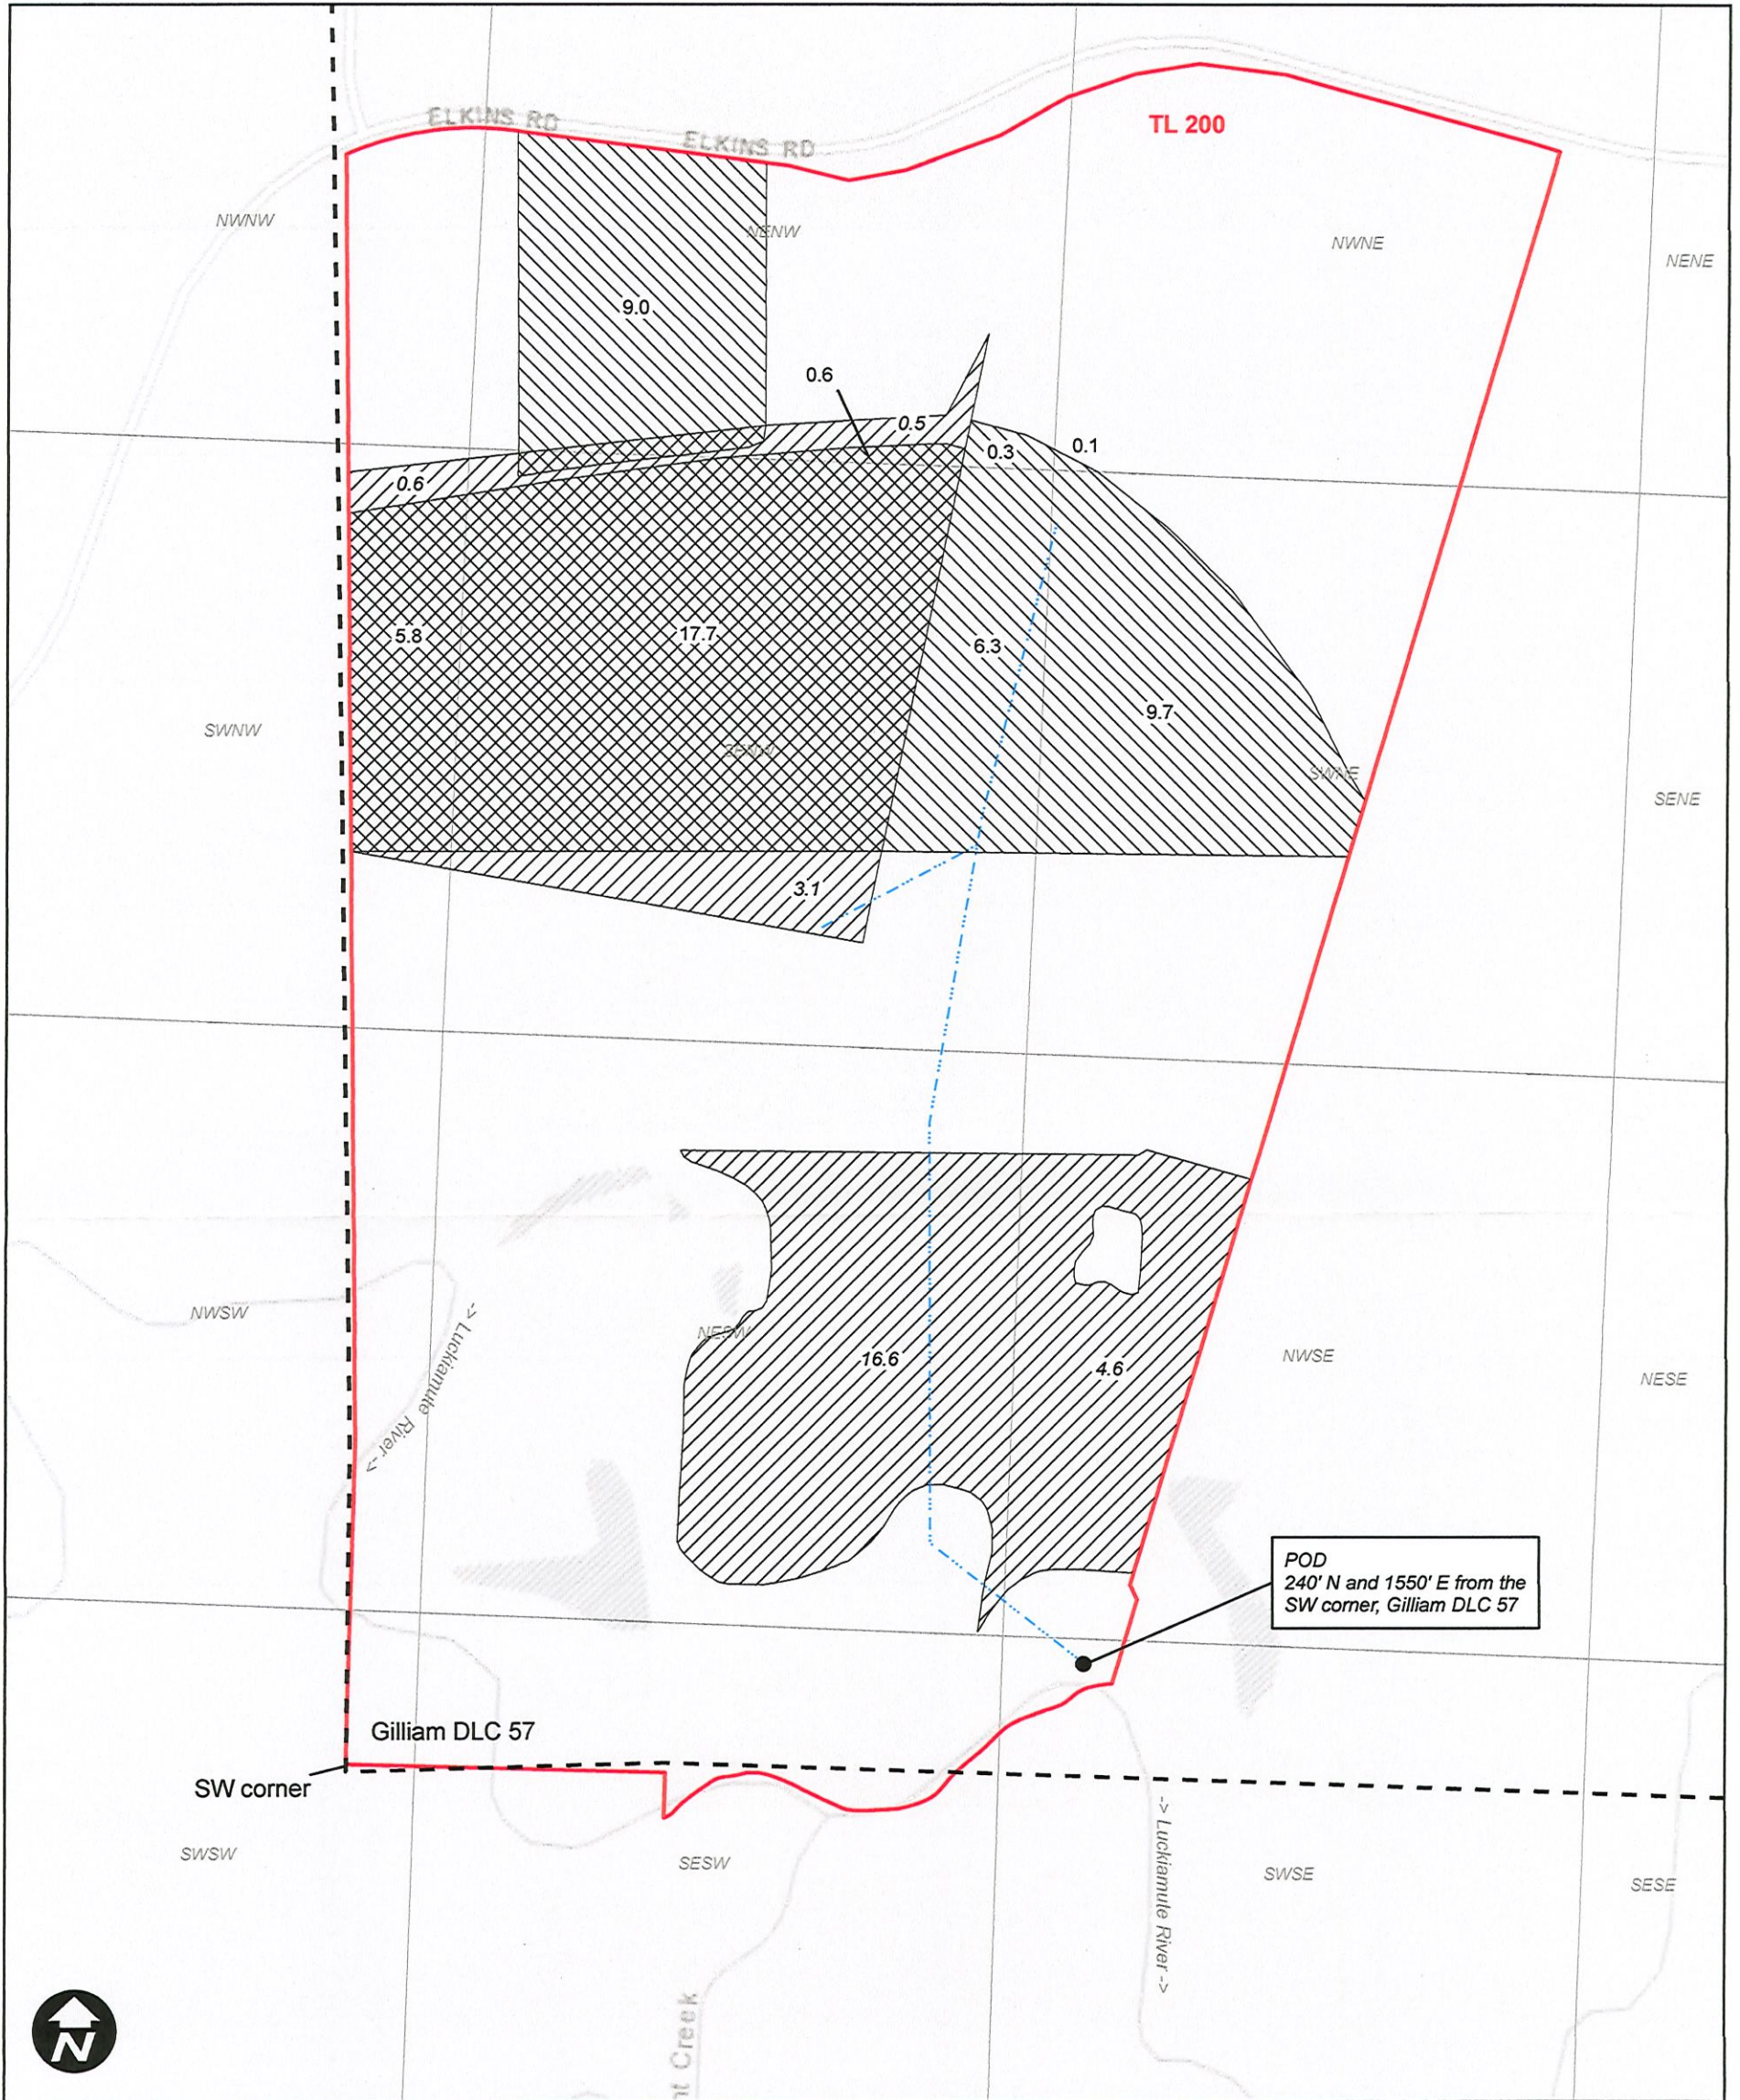

Legend

-  Cert. 32589 From
-  Cert. 32589 No Change
-  Cert. 32589 To
-  Mainline
-  DLC
-  Taxlot

