


# T. 4 N. R. 28 E. W.M.

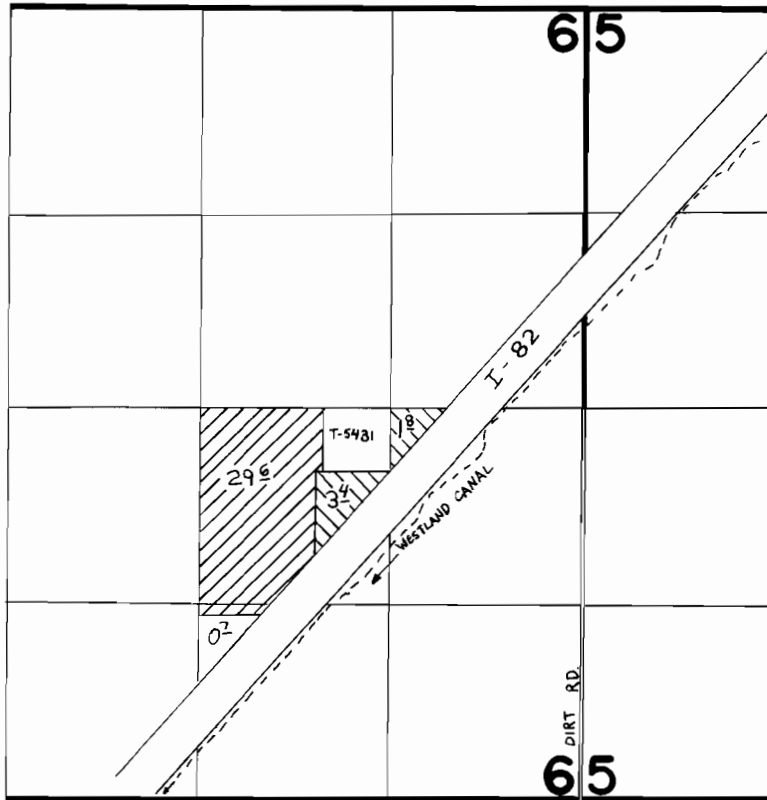

Scale 1" = 1320'



PER. 47621



T-5676

## FINAL PROOF SURVEY UNDER


### TRANSFER 5676

Application No. 6.4.91.7... Permit No. 4.7.621.....  
IN NAME OF

**MATTHEW P. DOHERTY**

Surveyed March 4, 1987, by V. Church.....

# T. 3 N. R. 29 E. W.M.

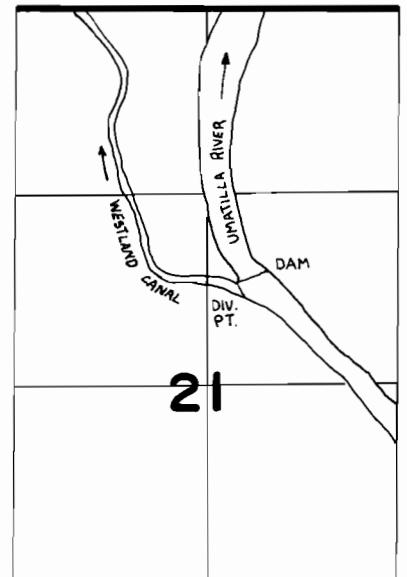

DIV. PT. LOC. N. 76°45'56" E 2913.19' FROM  
W. 1/4 COR. SEC. 21