


T. 24 S., R. 5 W., W.M.

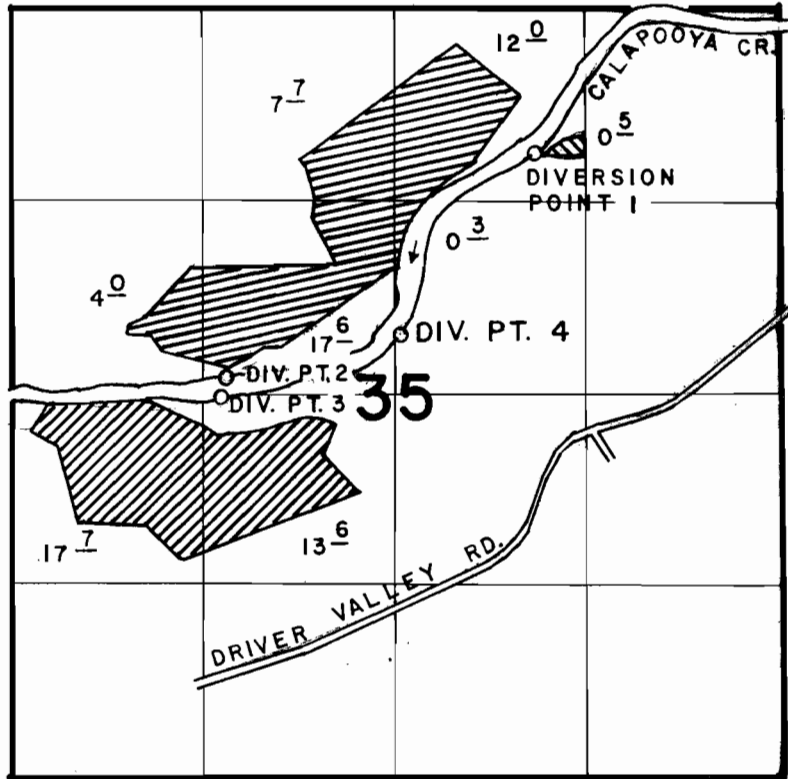

DIV. PT. 1 (T-4781) ; 980' S. & 3580' E. &
 DIV. PT. 2 (T-4779) ; 2530' S. & 1460' E. &
 DIV. PT. 3 (T-4780) ; 2660' S. & 1420' E. &
 DIV. PT. 4 (T-4780) ; 2250' S. & 2660' E.
 ALL FROM NW CORNER SECTION 35.

SCALE: 4" = 1 MILE

FINAL PROOF SURVEY

UNDER

TRANSFER NUMBERS 4779 
 4780 
 4781 

IN NAME OF

CREIGHTON & PHYLLIS M. BAXTER

Surveyed OCT. 15, 1986, by J. M. SCHMORDE