


T. 5 S. R. 1 W. W. M.

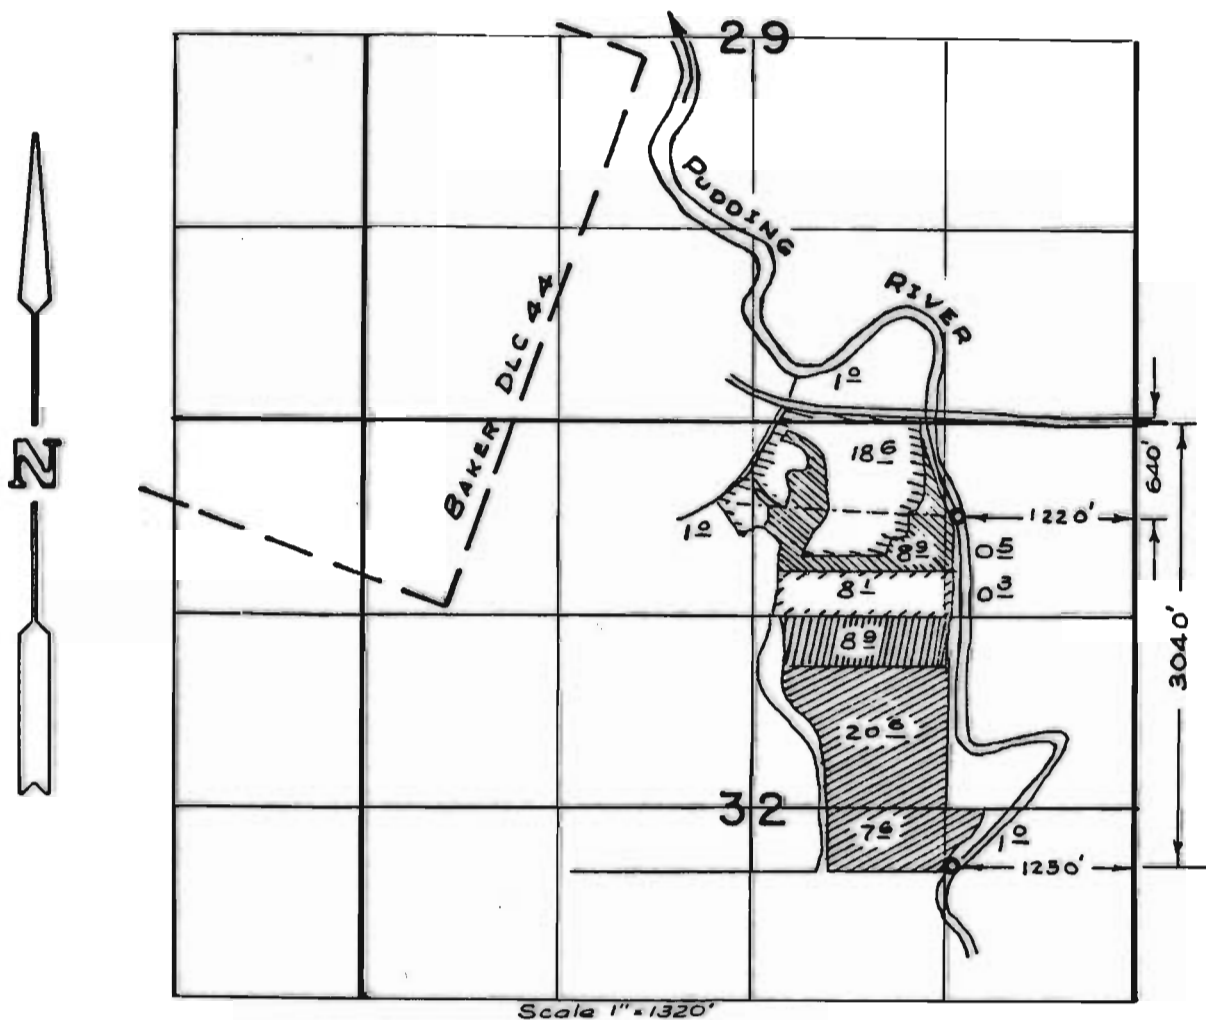

Claim of Beneficial Use - Transfer T-6431  
for  
TRECO

RECEIVED


JUN 26 1992

WATER RESOURCES DEPT.  
SALEM, OREGON


Permit 13084 Cert. No. 14423

Permit 15399 Cert. No. 16879

Permit 15399 Cert. No. 16877

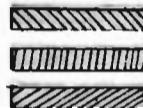

Remaining

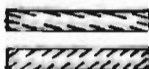

THE PREPARATION OF THIS MAP IS FOR THE  
PURPOSE OF IDENTIFYING THE LOCATION  
OF THE WATER RIGHT ONLY AND HAS NO  
INTENT TO PROVIDE DIMENSIONS OR LOCATION  
OF PROPERTY OWNERSHIP LINES.

