

5-PR-1-9-07

# T. 1 S., R. 24 E., W.M.


MORROW COUNTY

SCALE 1" = 1320'

RECEIVED

AUG 25 2004

WATER RESOURCES DEPT  
SALEM, OREGON

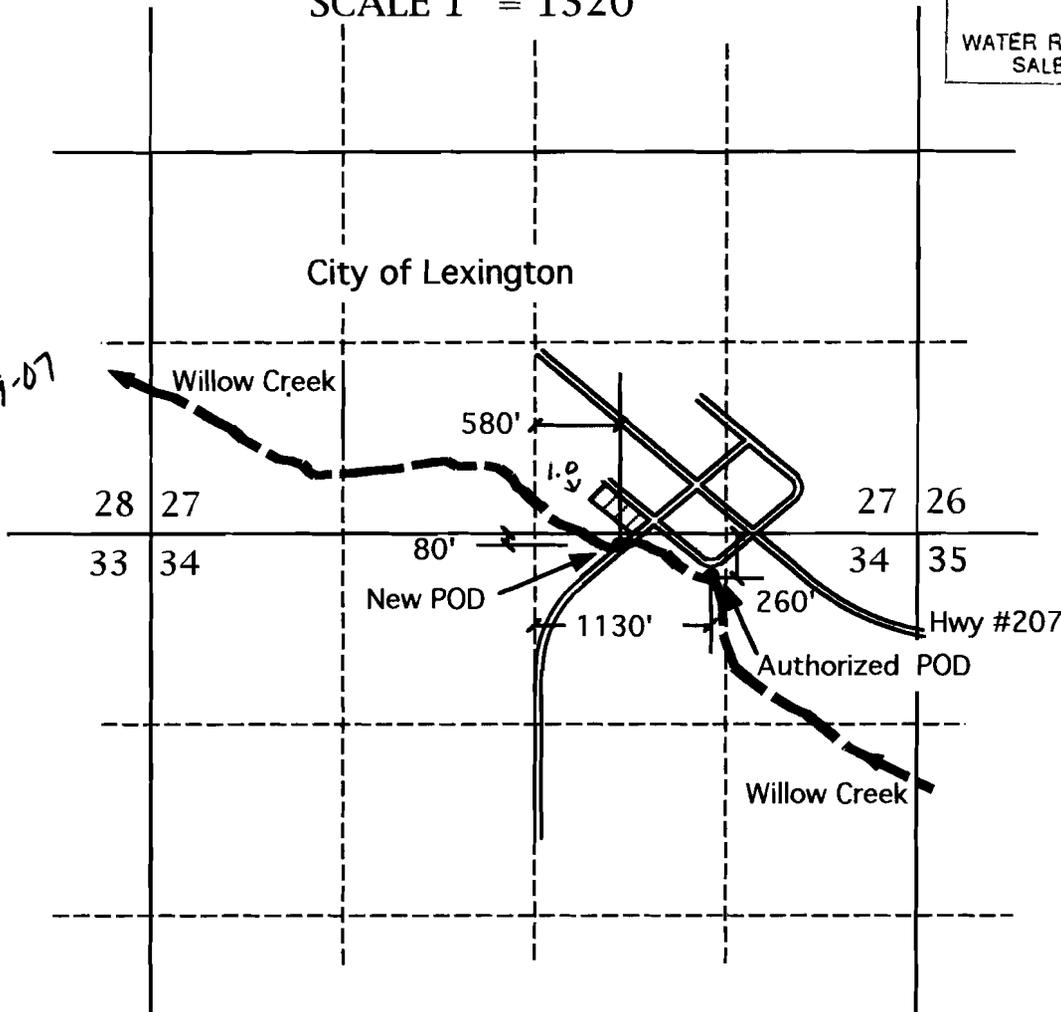

PR-1-9-07  
(1.0 ACRES)



Decree Acres

Authorized P.O.D. - Located 1130 Ft. East & 260 Ft. South of the South 1/4 Corner Section 27  
 NEW P.O.D. - Located 580 Ft. East & 80 Ft. South of the South 1/4 Corner Section 27

## WATER RIGHTS TRANSFER MAP


RECEIVED

MAY 11 2006

WATER RESOURCES DEPT  
SALEM, OREGON

IN NAME OF

Vilas D. Ropp

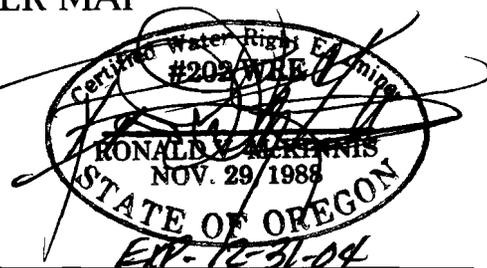

THIS MAP IS FOR THE PURPOSE OF IDENTIFYING THE LOCATION OF WATER RIGHTS ONLY AND IS NOT INTENDED TO PROVIDE THE LEGAL DIMENSIONS OR LOCATIONS OF PROPERTY OWNERSHIP LINES.

ENGINEERING - LAND SURVEYING - WATER RIGHTS  
**R. V. McKINNIS ENGINEERING**  
 79980 Prindle Loop Road  
 Hermiston, Oregon 97838  
 (541) -567-2017




T 10170