T.14S., R.7&8W., W.M.

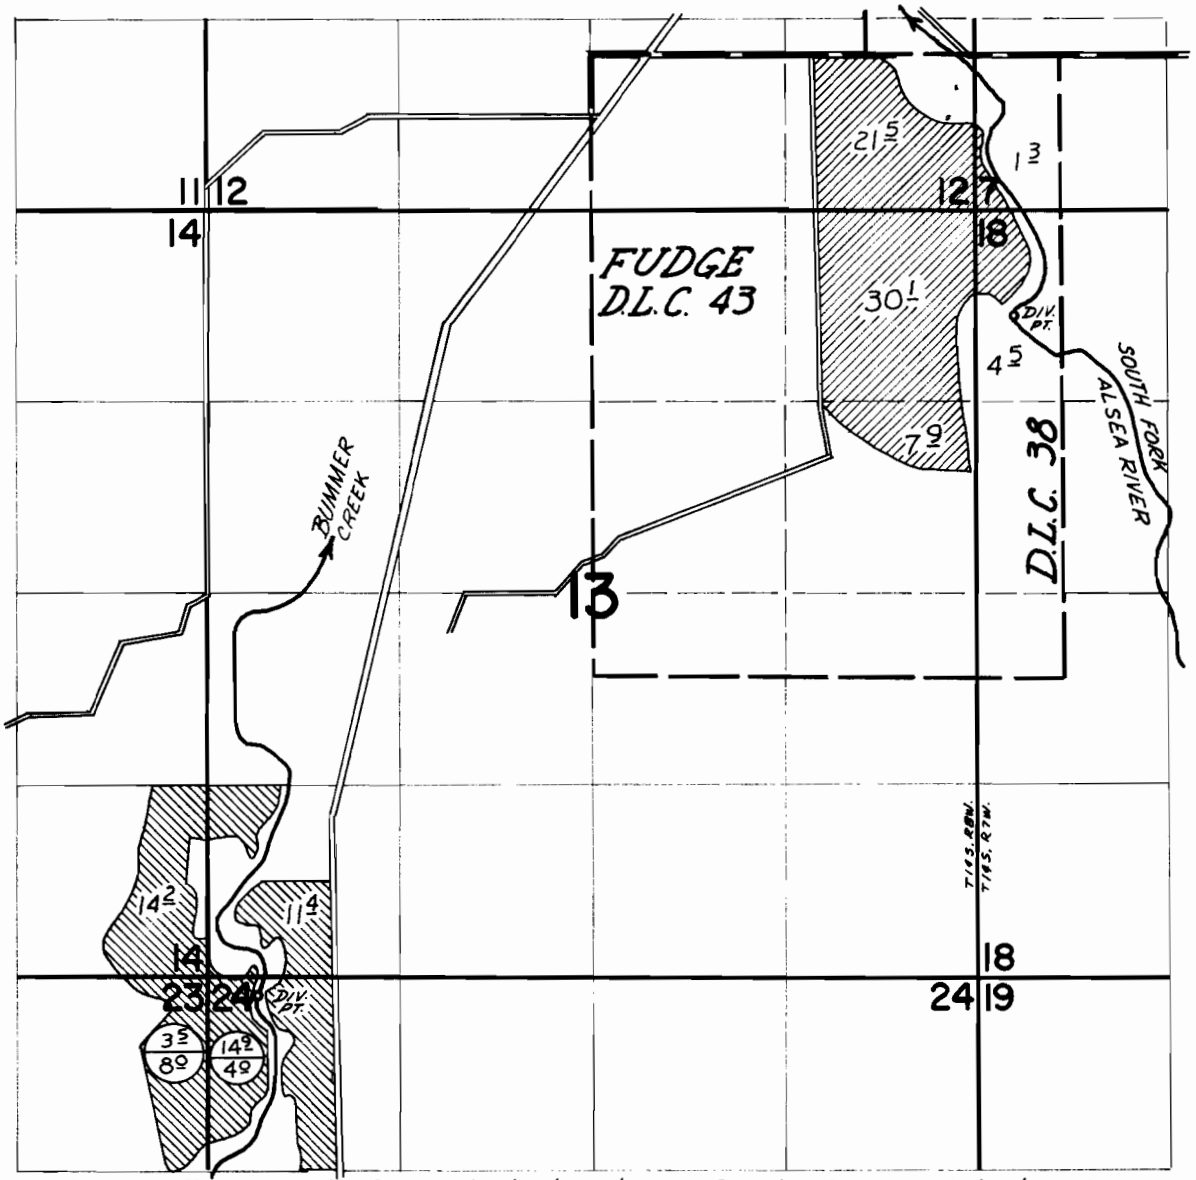

DIV. PTS. LOCATED: BUMMER CREEK - 6480' S & 2300' W; S. FORK ALSEA RIVER - 1800' S & 2900' E; BOTH FROM NW COR. FUDGE DLC 43.

A-# 48094, P-# 35332
A-# 12031, P-# 8436, C-# 8524

FINAL PROOF SURVEY
UNDER

Transfer No. 2442
47500 35577
Application No. 48094 Permit No. 35332
IN NAME OF

BRUCE L. ENGEL

Surveyed APRIL 26 1973, by D. NORBY

DFJ-1P-104 DN