


Old point of Diversion Cert. 7046, 6867
SENE Sec. 2, T17 S.R. 46 E.W.M.

WATER RESOURCES DEPT
SALEM, OREGON

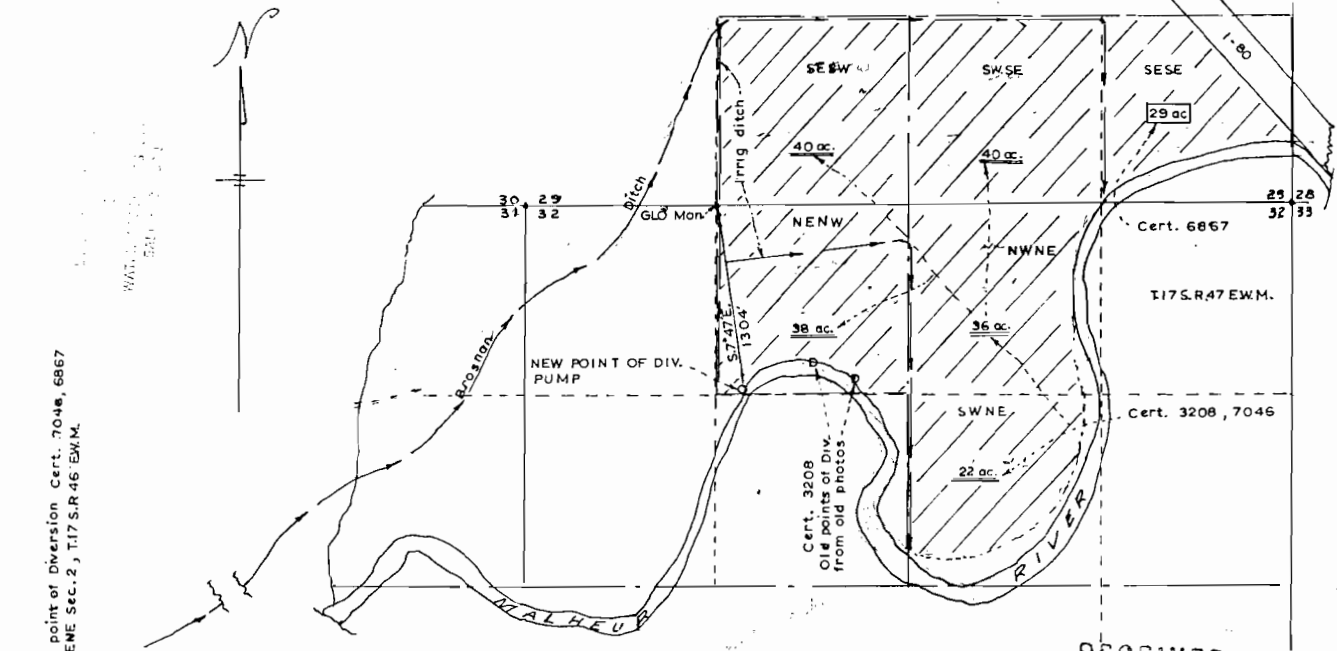

APPLICATION FOR CHANGE IN POINT OF DIVERSION
Marguerite Decker - Ontario, Oregon
Scale 1:660'

RECEIVED
OCT 13 1977
WATER RESOURCES DEPT
SALEM, OREGON

COPY