


T.37S.R.5W.W.M.

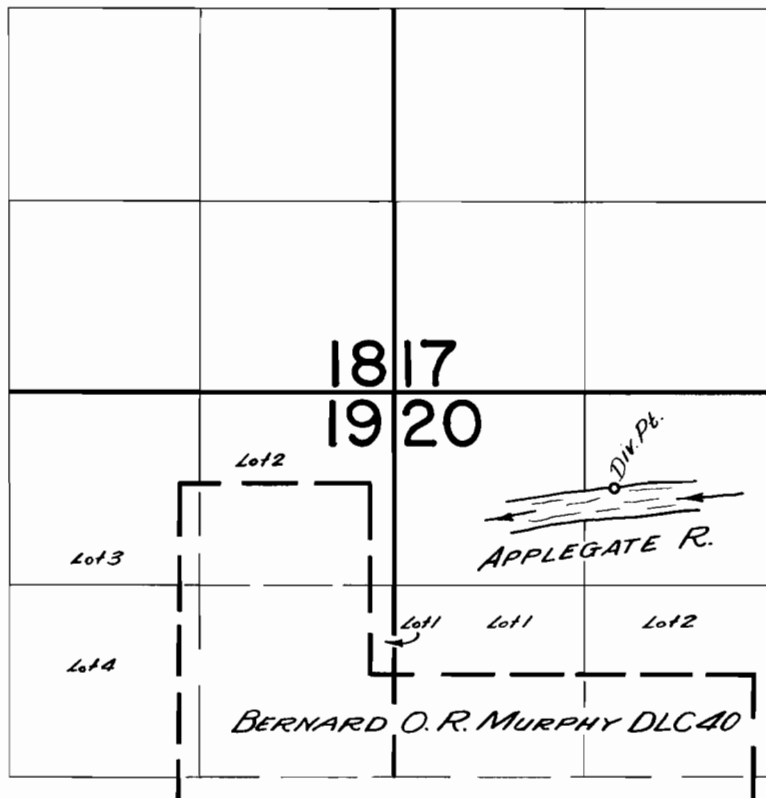

FINAL PROOF SURVEY
UNDER

Application No. T-48 Permit No. _____
IN NAME OF

..... LOREN F. FLANNERY

Surveyed APRIL 12 1961, by C. O. Burt