


T. 1 S. R. 13 E. W.M.

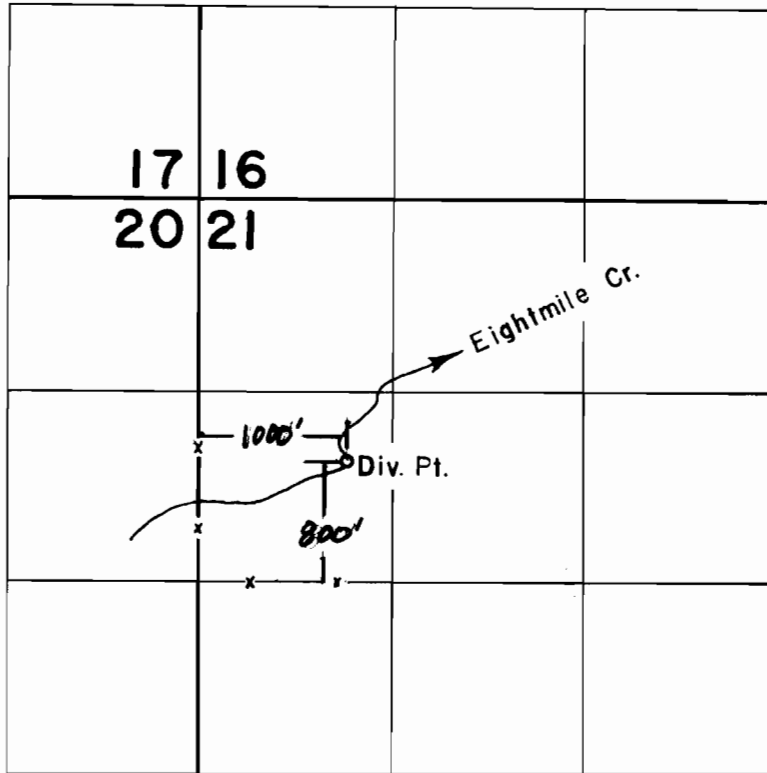

FINAL PROOF SURVEY
UNDER

Transfer No. T-53
IN NAME OF

.....TED TIDWELL.....

Surveyed June 5, 1962, by *A. W. Gebousek*