


T. 16 S. R. 12 E. W.M.

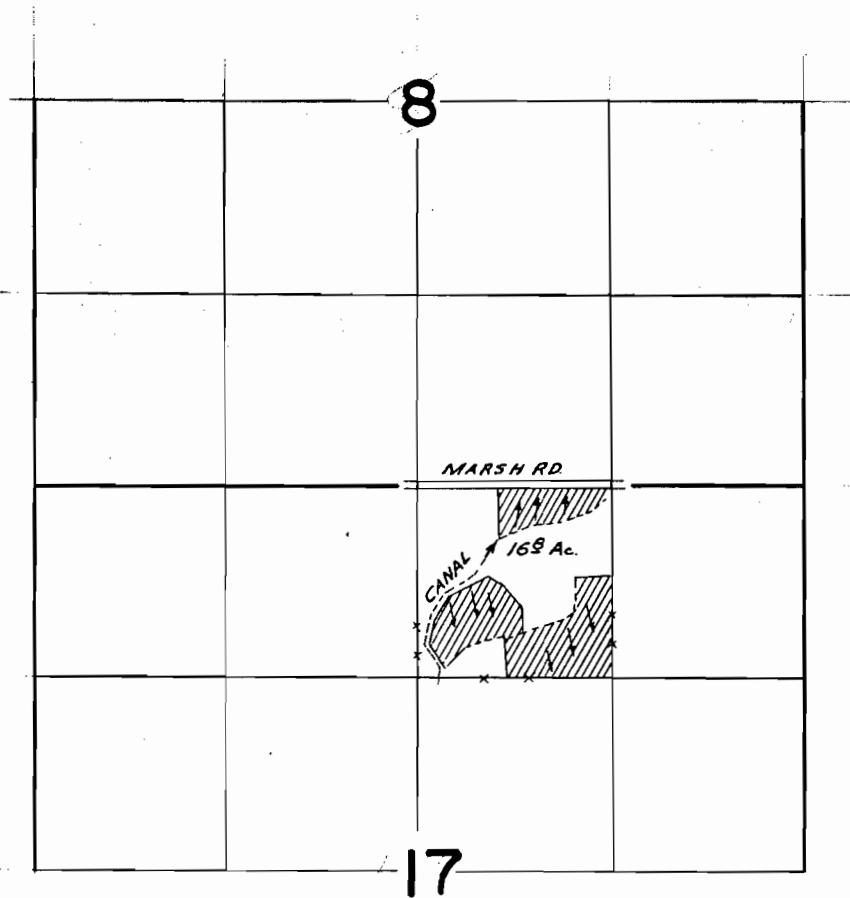

FINAL PROOF SURVEY
UNDER

Transfer T-56
Application No. Permit No.
IN NAME OF

.....
Surveyed *May 12, 1966*, by *W.J. Ruppert*.....