


T.12 S.R.4W.W.M.

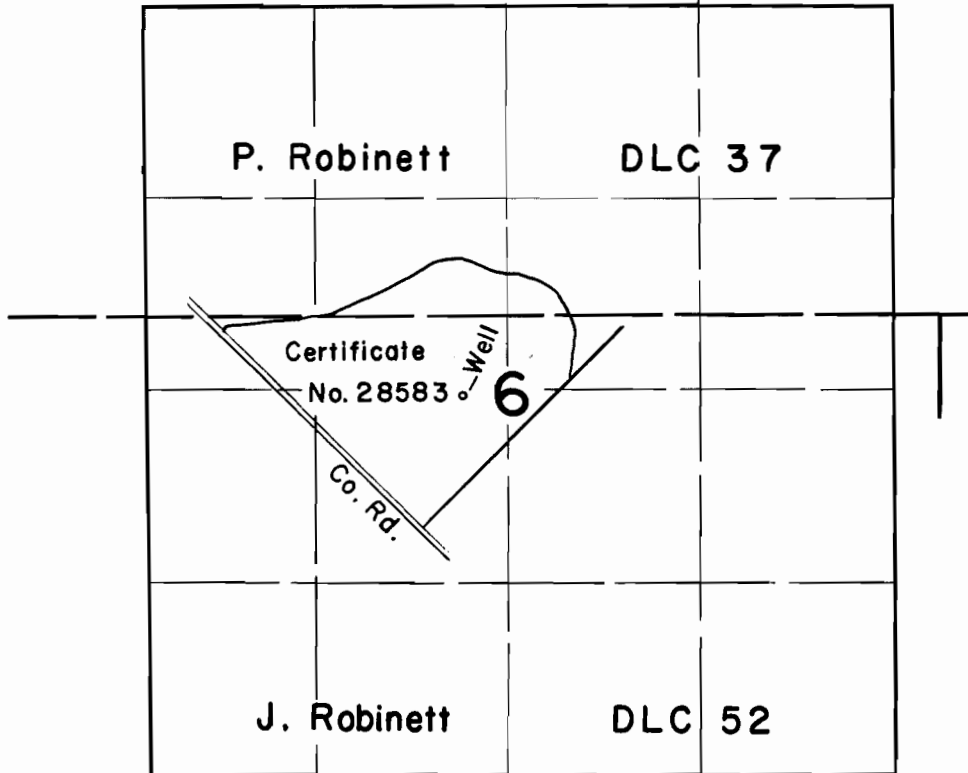

FINAL PROOF SURVEY
UNDER

Transfer No. T60

Application No. Permit No.

IN NAME OF

..... **Mrs. Zack Taylor**

Surveyed Oct. 26, 1964, by F. Siegmund.....