


T. 36 S. R. 1 E. W. M.

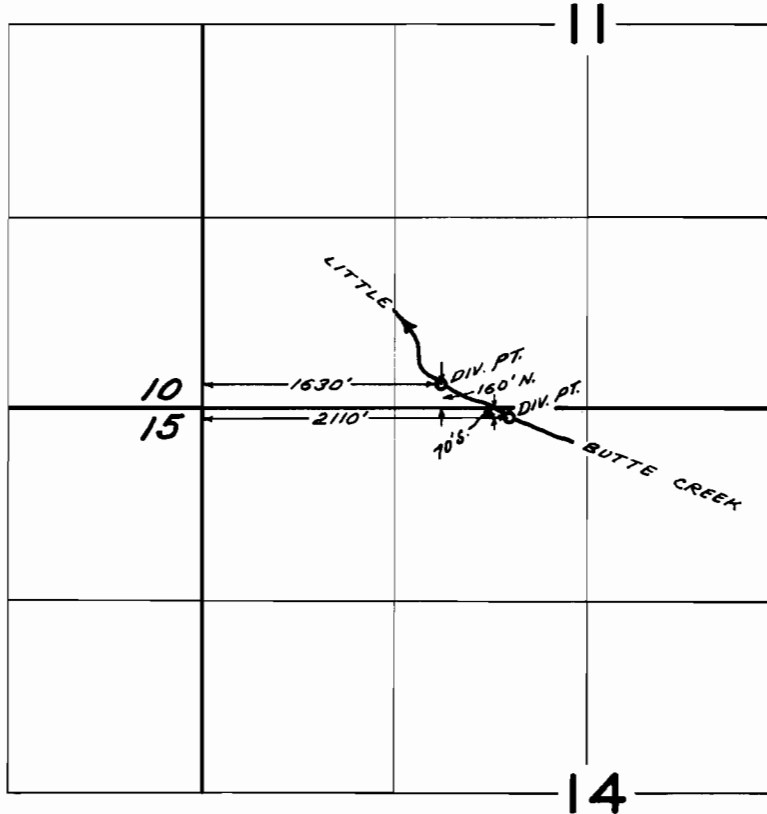

FINAL PROOF SURVEY
UNDER

TRANSFER No. T-70
Application No. _____ Permit No. _____
IN NAME OF

ED MAYFIELD

Surveyed *JUN. 13 1968*, by *V. GARNER*