


T.36S.R.24E.W.M.

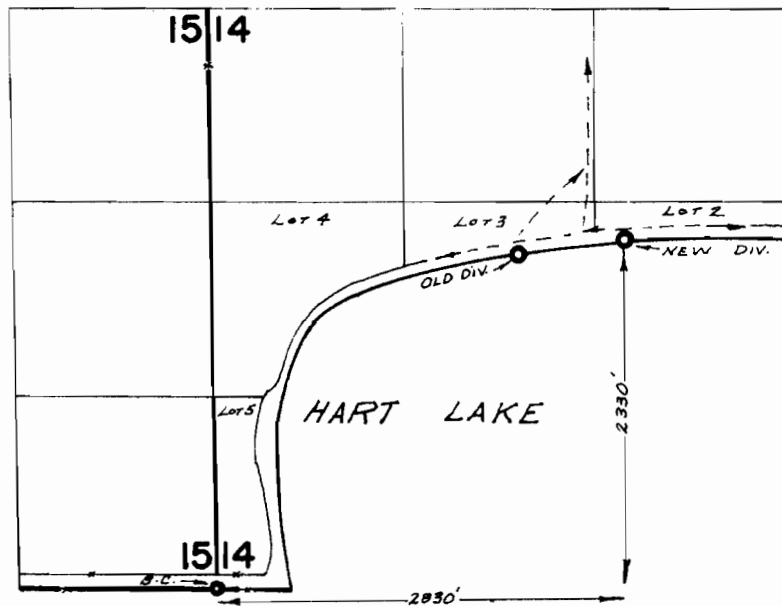

TRANSFER NO. T-73

TAYLOR RANCH, INC.

JULY 23, 1970 BY R. MUCKEN