


T.9S. R.45E. W.M.

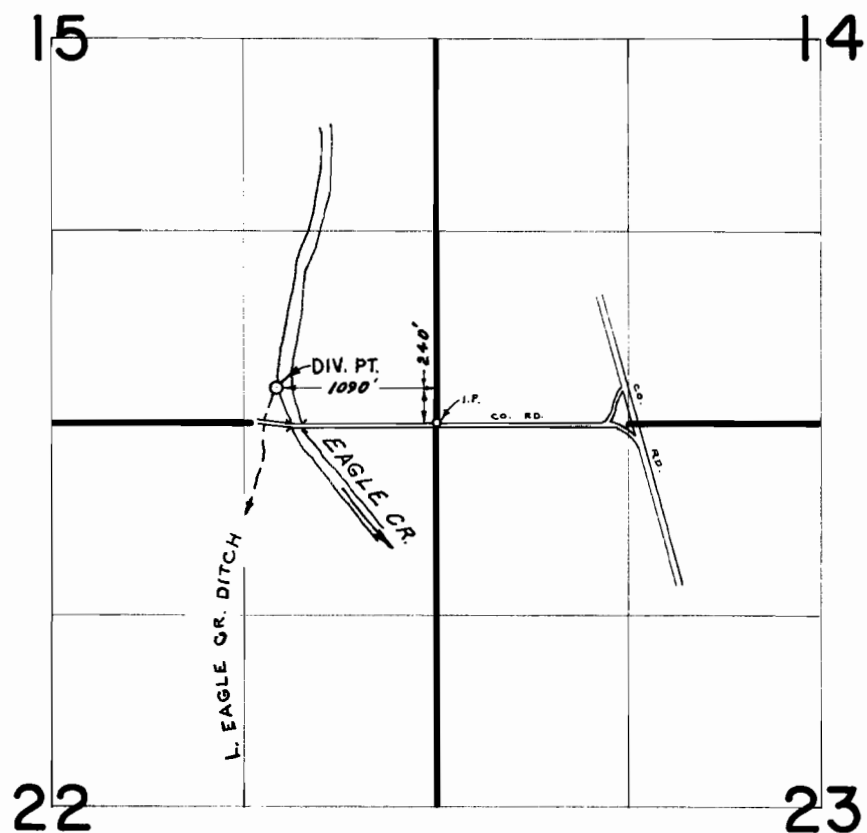

FINAL PROOF SURVEY
UNDER

Transfer No. T-74

Application No. _____ Permit No. _____

IN NAME OF

FRED THOMPSON

Surveyed AUG. 28, 1975, by R. MUCKEN