
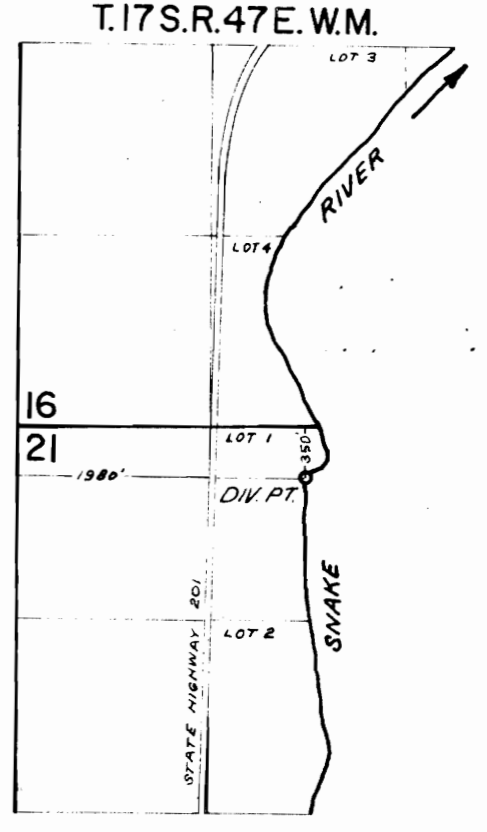


T.17&18S.R.46E.W.M.

- PRIMARY IRRIGATION - MALHEUR RIVER
PERMIT No. 30621
- PERMIT No. 33946
- PRIMARY IRRIGATION - SNAKE RIVER
PERMIT No. 31231
- PERMIT No. 33944
- SUPPLEMENTAL IRRIGATION - SNAKE RIVER
PERMIT No. 33945

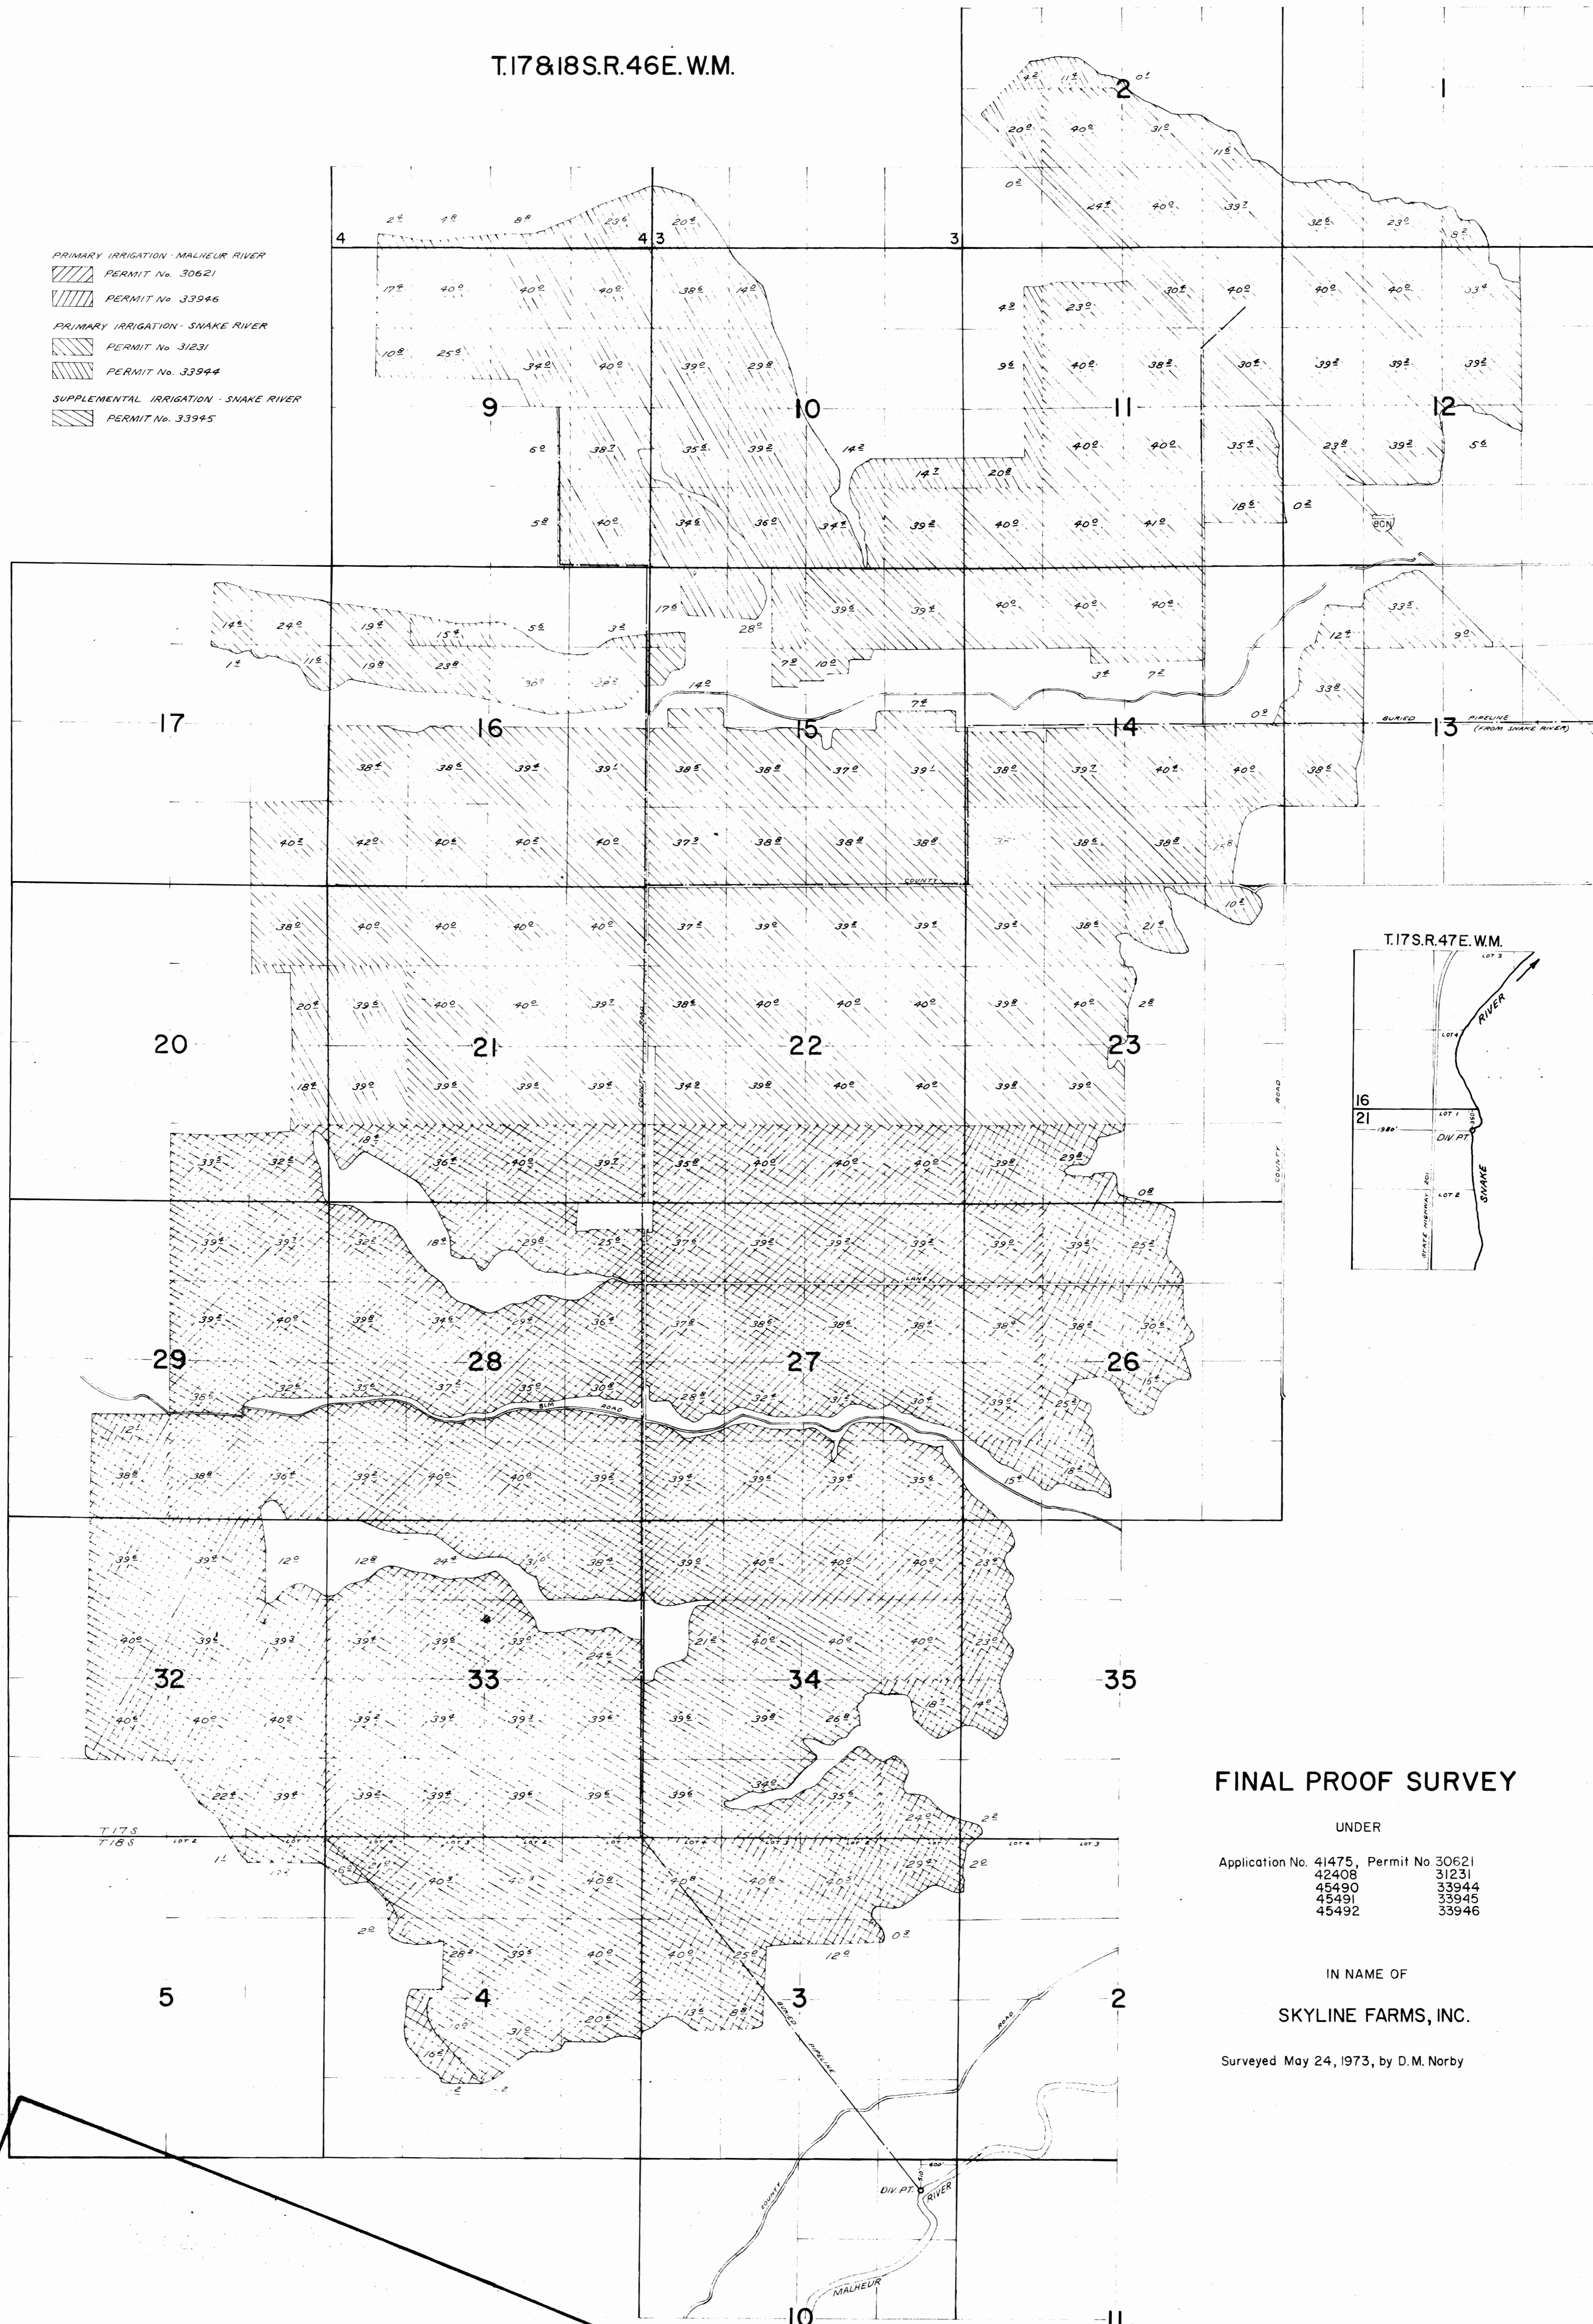

FINAL PROOF SURVEY

UNDER
 Application No. 41475, Permit No. 30621
 42408 31231
 45490 33944
 45491 33945
 45492 33946

IN NAME OF
SKYLINE FARMS, INC.
 Surveyed May 24, 1973, by D.M. Norby