


RECEIVED RECEIVED
 MAR 17 1970 MAR 4 1970
 STATE ENGINEER STATE ENGINEER
 SALEM, OREGON SALEM, OREGON

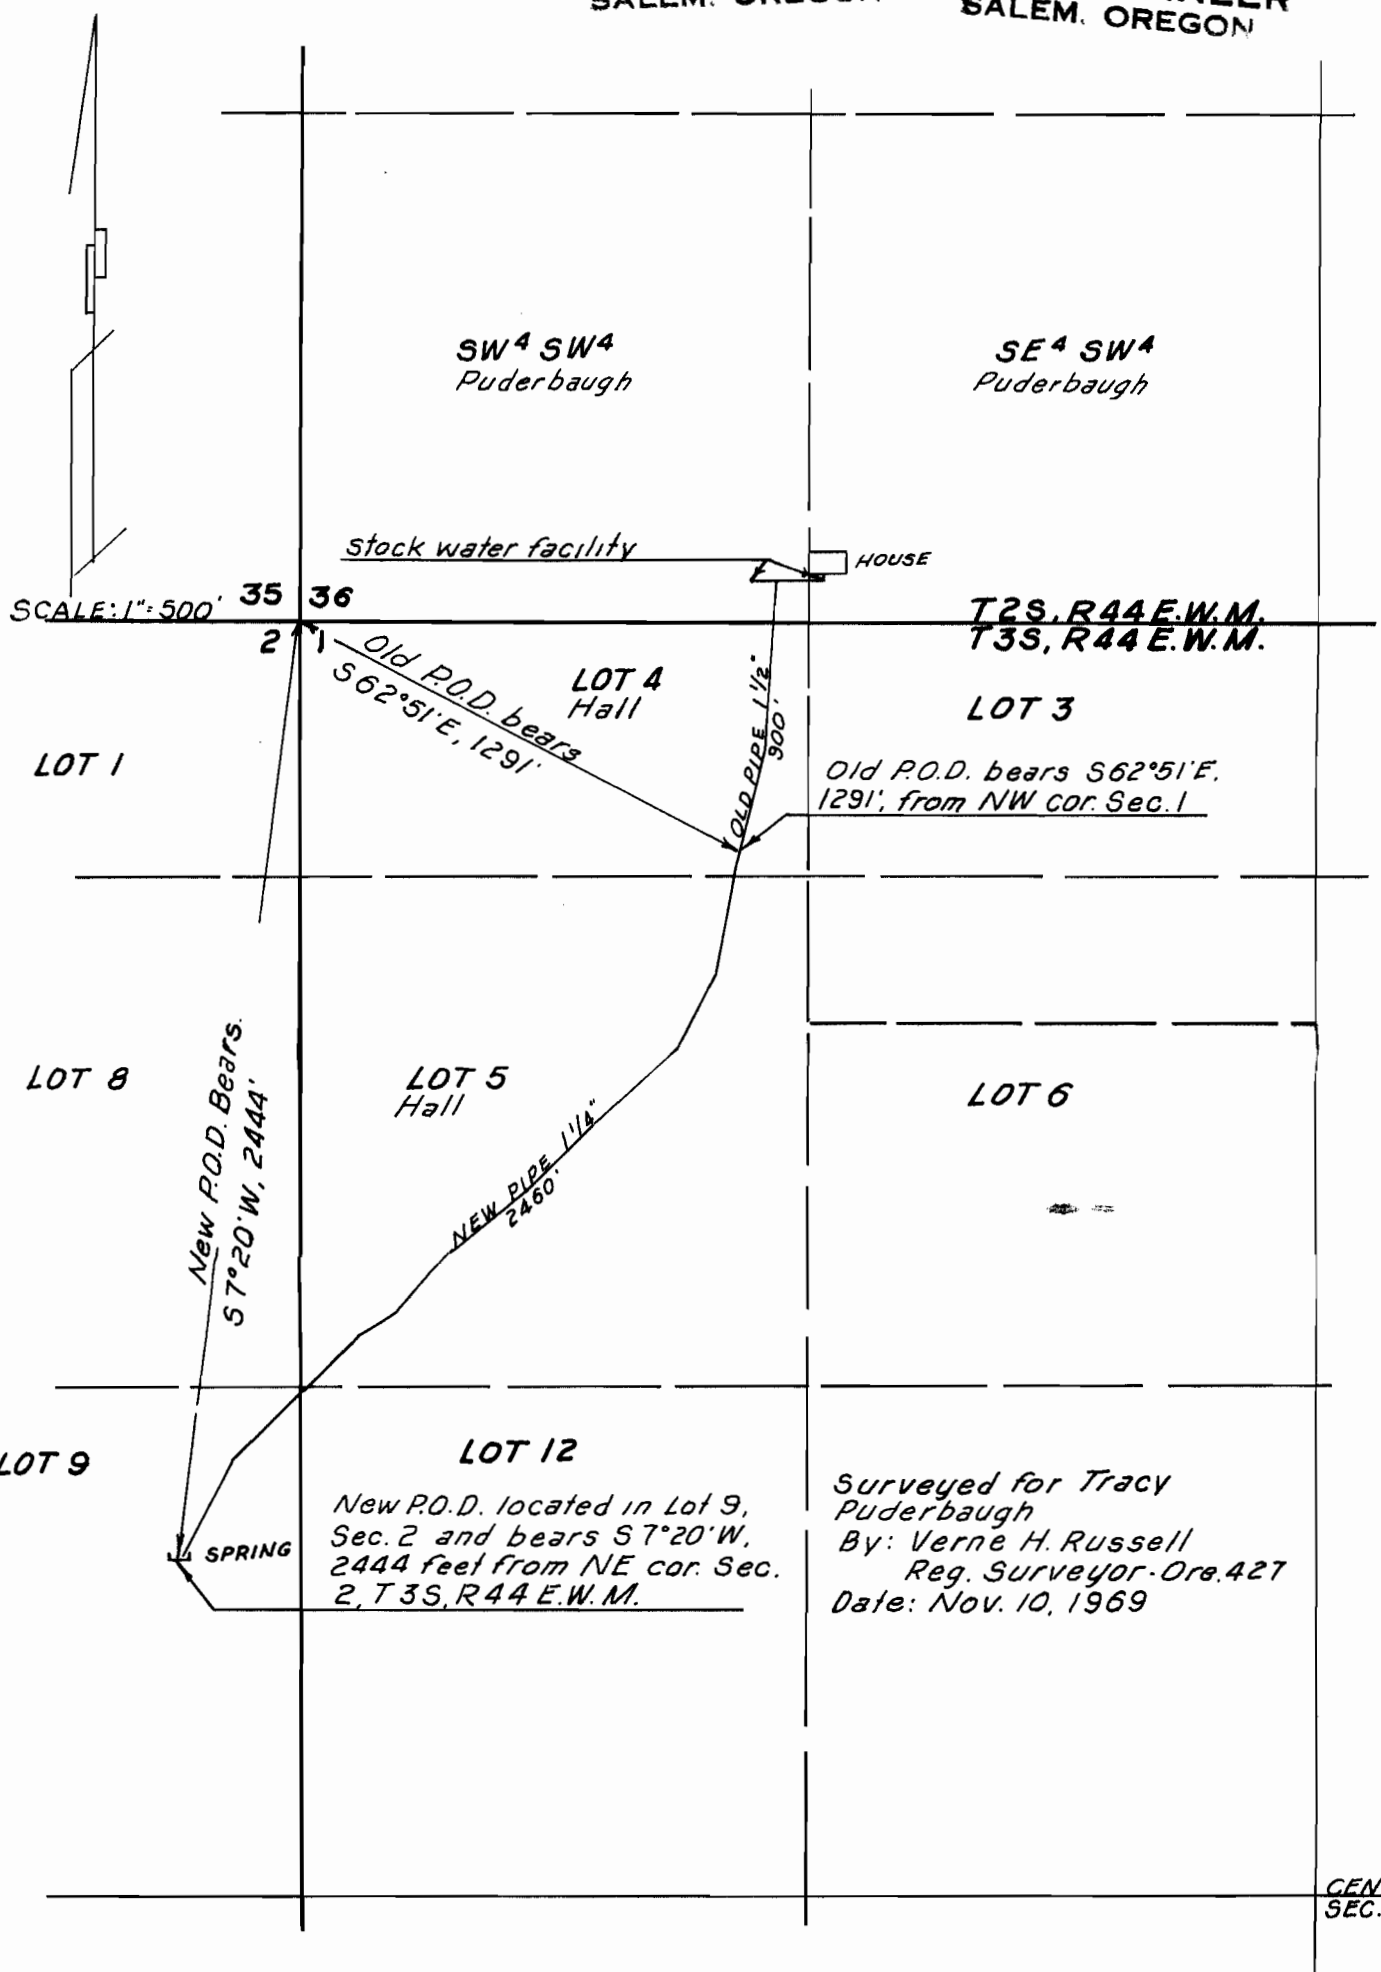

CENTER
SEC. 1