


T.3S., R.44E., W.M.

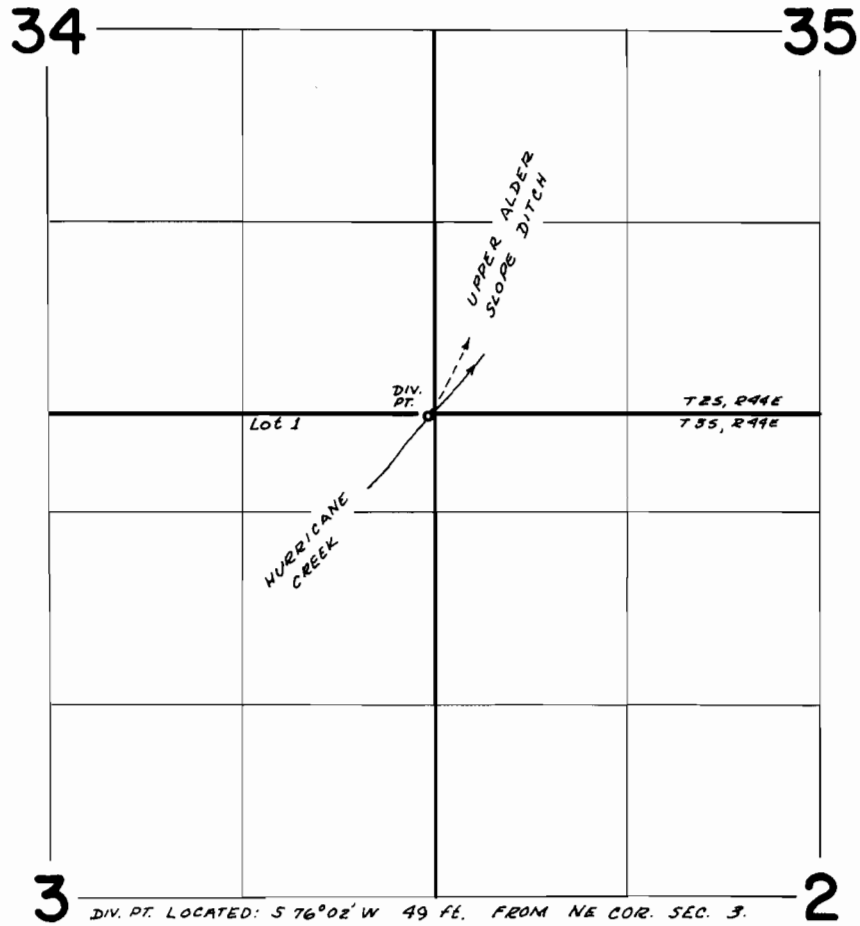

FINAL PROOF SURVEY
UNDER

Transfer No. 2351
Application No. Permit No.
IN NAME OF

LYLE K. BONER

Surveyed *June 27* 19*72*, by *L. E. Gould*