


T.13S.,R.29E.,W.M.

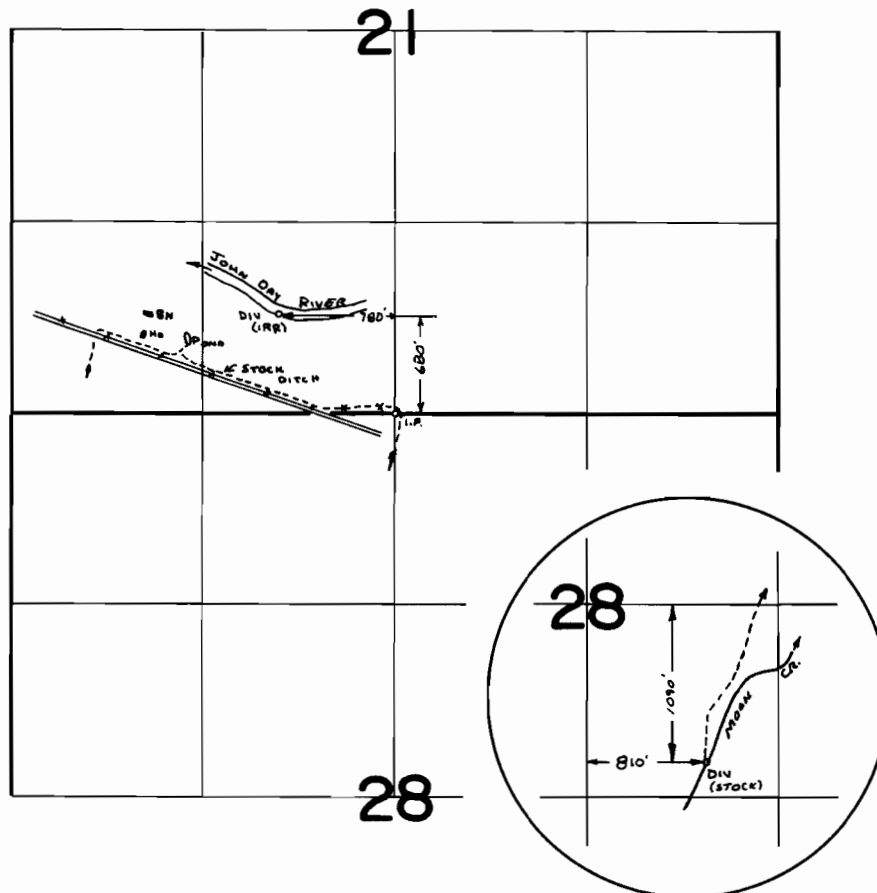

FINAL PROOF SURVEY
UNDER

Transfer No. 2353 ✓
Application No. ~~48856~~ Permit No. 36609
IN NAME OF

FLOYD HABBE

Surveyed Aug. 20, 1975, by L. Toll