


T.2N. R.27E. W.M.

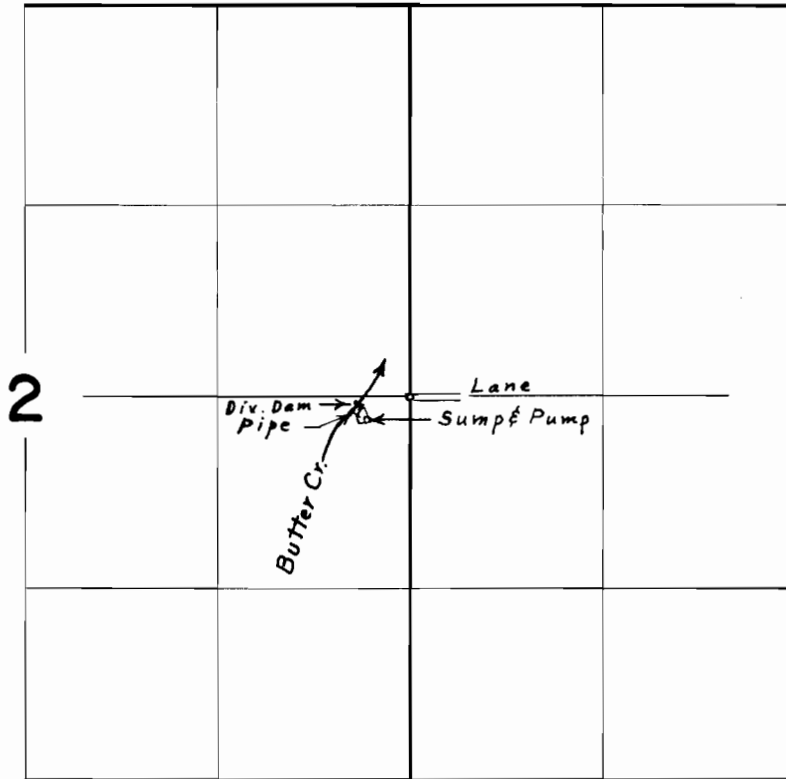

Div. Pt. located 50' S. & 350' W. from E. $\frac{1}{4}$ Cor. Sec. 2

FINAL PROOF SURVEY
UNDER

Application No. _____ Transfer No. 2354
Permit No. _____

IN NAME OF
AMMON BROS. INC.

Surveyed April 10, 1973, by L. E. Gould