


# T.37S.R.5W.W.M.

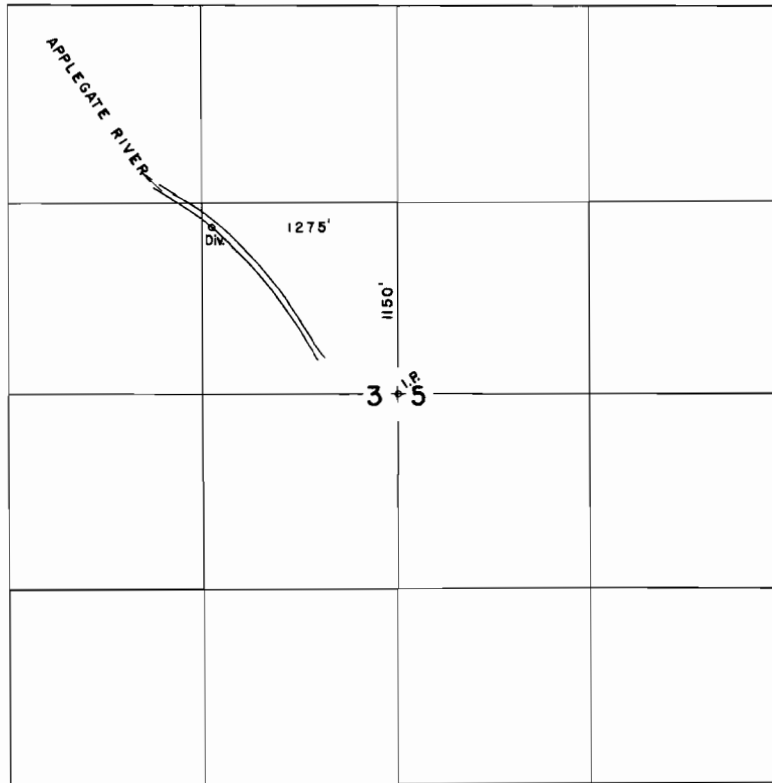

## FINAL PROOF SURVEY UNDER

Application No. \_\_\_\_\_ TRANS. Permit No. 2357  
IN NAME OF

..... JUNE E. SHARP .....

Surveyed NOV. 8 1972, by R.B. STEIMER.