T. 4N., R.27E., W.M.

HANSELL BROTHERS INC. FINAL PROOF

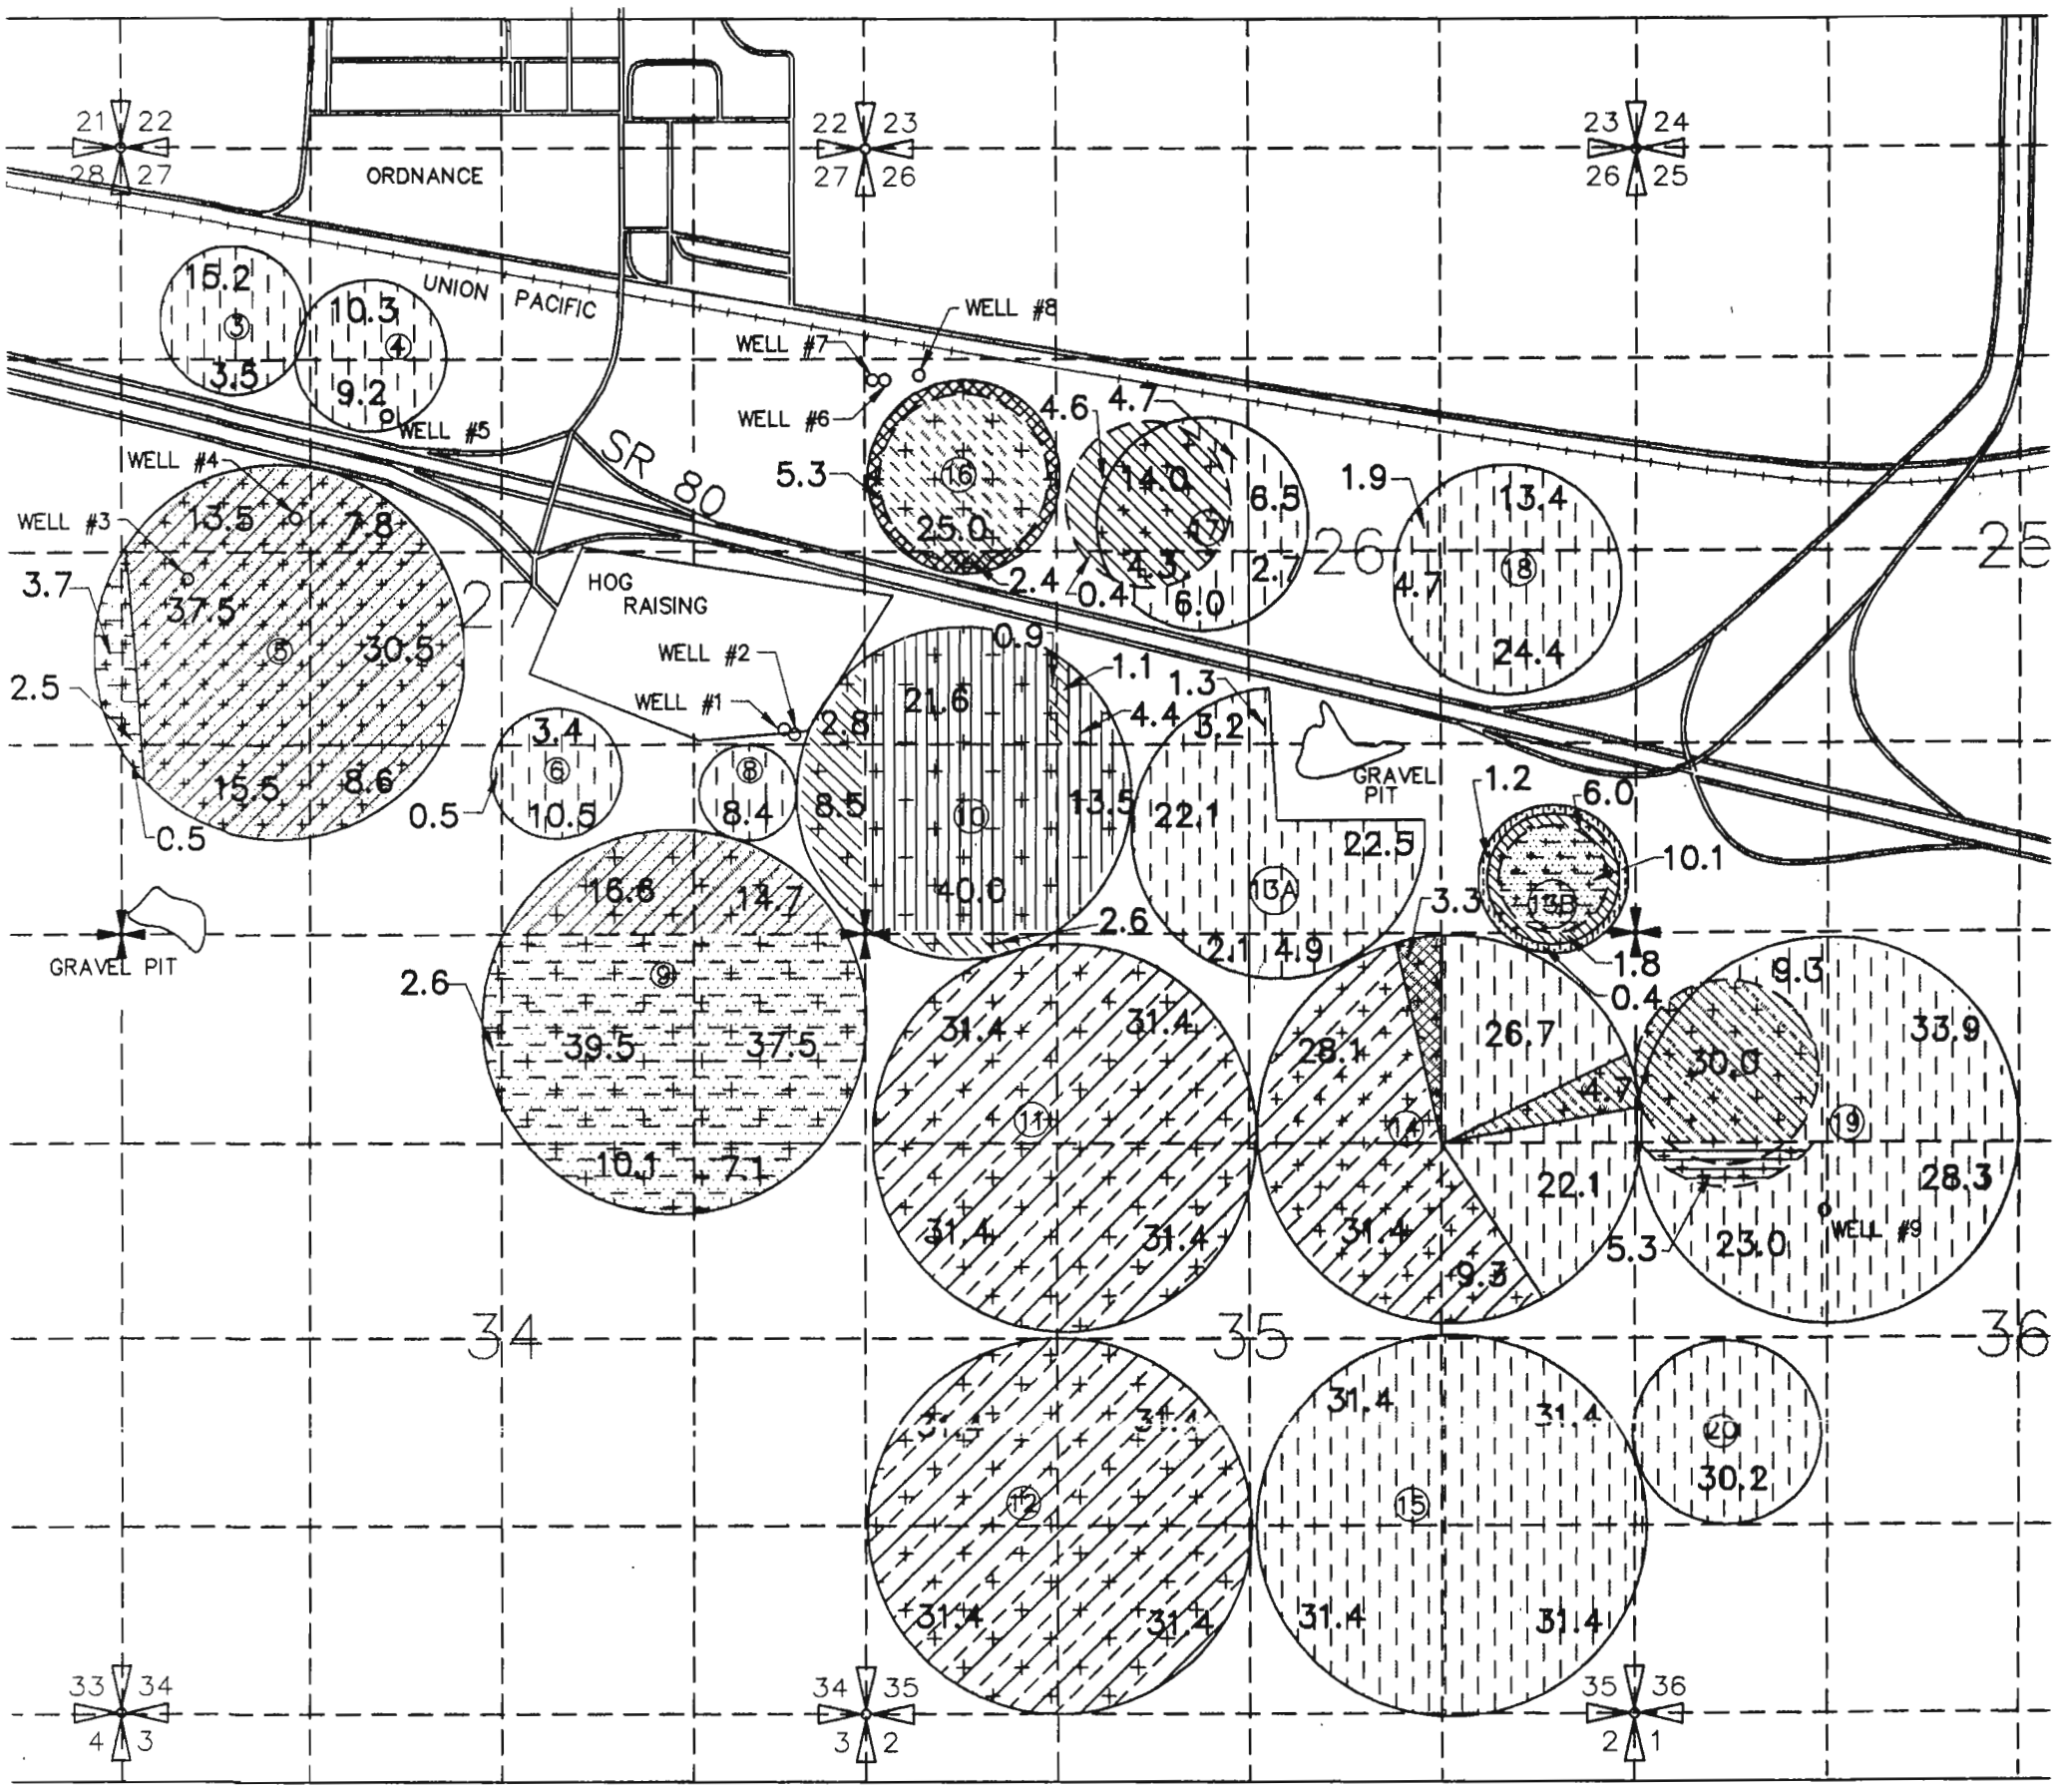

WELL 1 LOCATED 1420'N & 490'W FROM SE COR. SEC.27 BEING WITHIN $NE^1/_4SE^1/_4$
WELL 2 LOCATED 1390'N & 430'W FROM SE COR. SEC.27 BEING WITHIN $NE^1/_4SE^1/_4$
WELL 3 LOCATED 2450'N & 460'E FROM SW COR. SEC.27 BEING WITHIN $NW^1/_4SW^1/_4$
WELL 4 LOCATED 230'N & 1210'E FROM $W^1/_4$ COR. SEC.27 BEING WITHIN $SW^1/_4NW^1/_4$
WELL 5 LOCATED 960'N & 1850'E FROM $W^1/_4$ COR SEC.27 BEING WITHIN $SE^1/_4NW^1/_4$
WELL 6,7 LOCATED 1130'N & 60'E FROM $W^1/_4$ COR. SEC.26 BEING WITHIN $SW^1/_4NW^1/_4$
WELL 8 LOCATED 1160'N & 370'E FROM $W^1/_4$ COR. SEC.26 BEING WITHIN $SW^1/_4NW^1/_4$
WELL 9 LOCATED 1884'S & 1315'E FROM NW COR. SEC.36 BEING WITHIN $SW^1/_4NW^1/_4$

T-4152
PERMIT NO. U-649
PERMIT NO. G-3822 SUPPLEMENTAL
G-3822 PRIMARY
PERMIT NO. G-2672
PERMIT NO. G-10505 SUPPLEMENTAL
PERMIT NO. G-10505 PRIMARY
PERMIT NO. G-2694
Appl. G-8515
T-4928
PERMIT NO. G-2335
T-4926
PERMIT NO. G-1671
T-4927

(1) CIRCLE NUMBER
31.4 IRRIGATED ACREAGE

RECEIVED
MAY 30 1995
WATER RESOURCES DEPT
SALEM, OREGON

Certified Water Right Examiner
#333 WRE
Dale G. VanSchoiack
May 18, 1982
5/23/95
STATE OF OREGON

0' 1320' 2640'

NOTE: THE PURPOSE OF THIS MAP IS TO IDENTIFY THE APPROXIMATE LOCATION OF THE WATER RIGHT. IT IS NOT INTENDED TO PROVIDE INFORMATION RELATIVE TO THE LOCATION OF PROPERTY OWNERSHIP BOUNDARY LINES.

3522.016
HANSELL4.DWG
MARCH 20, 1995