


T. 3 S., R. 44 E., W.M.

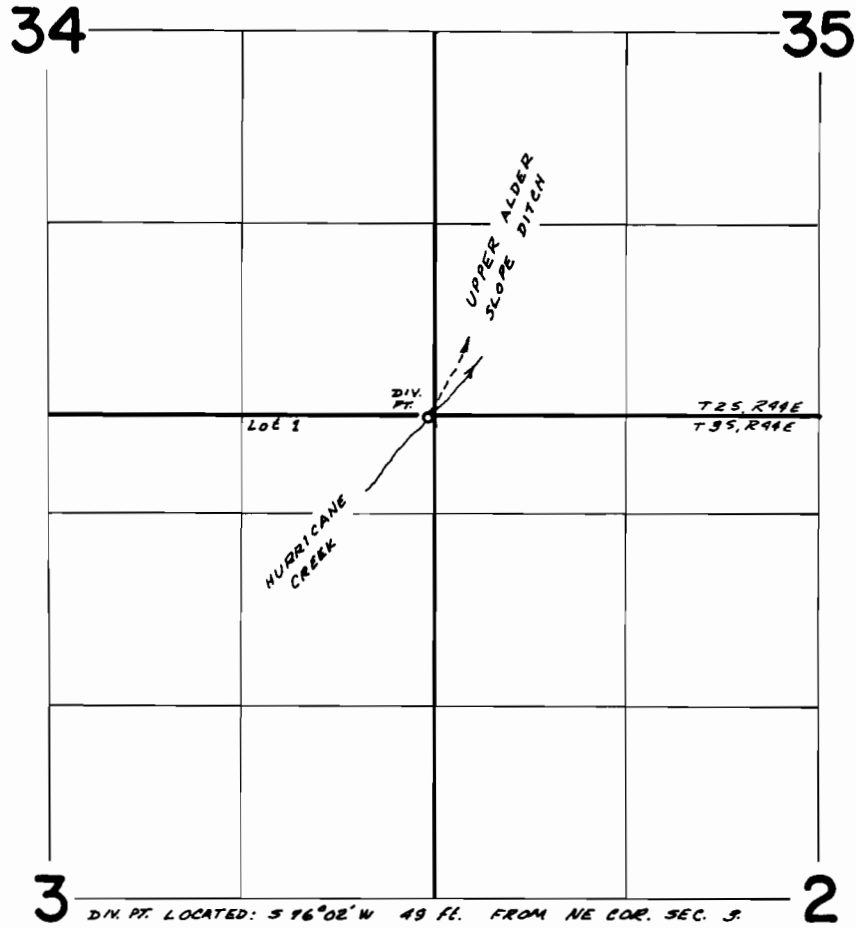

**FINAL PROOF SURVEY**  
UNDER

Transfer No. 2366  
Application No. .... Permit No. ....  
IN NAME OF

..... W. T. PUDERBAUGH .....

Surveyed June 27 1972, by L. E. Gould .....