


T.13S., R.27E., W.M.

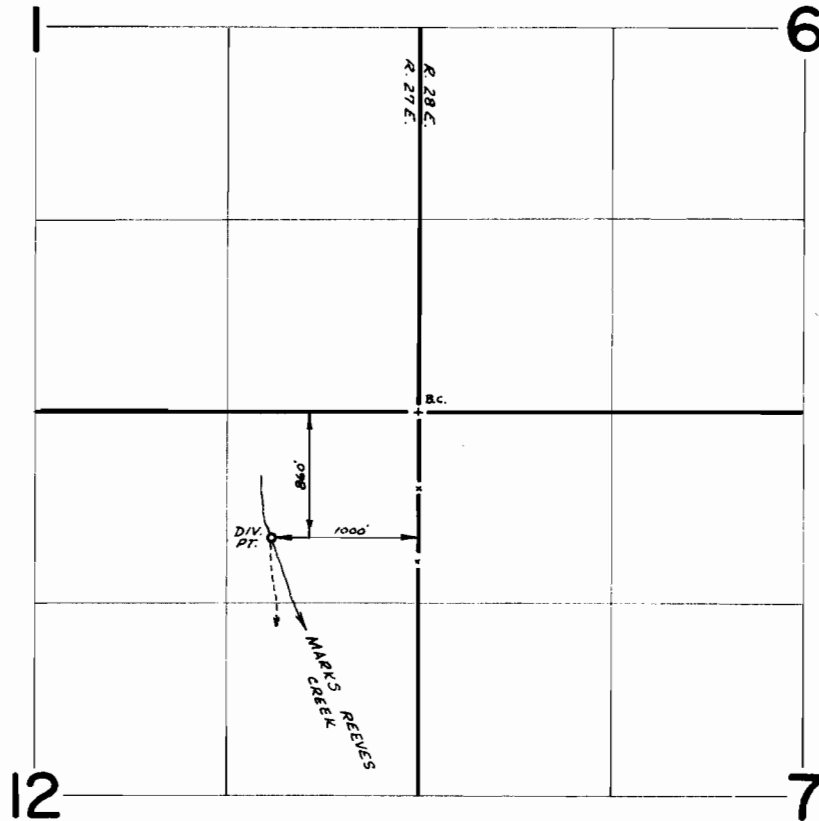

FINAL PROOF SURVEY
UNDER

Transfer No. 2370
Application No. Permit No.
IN NAME OF

EDWARD B. UFFELMAN

Surveyed June 19 1975, by D. Norby