


T.37S.R.5W.W.M.

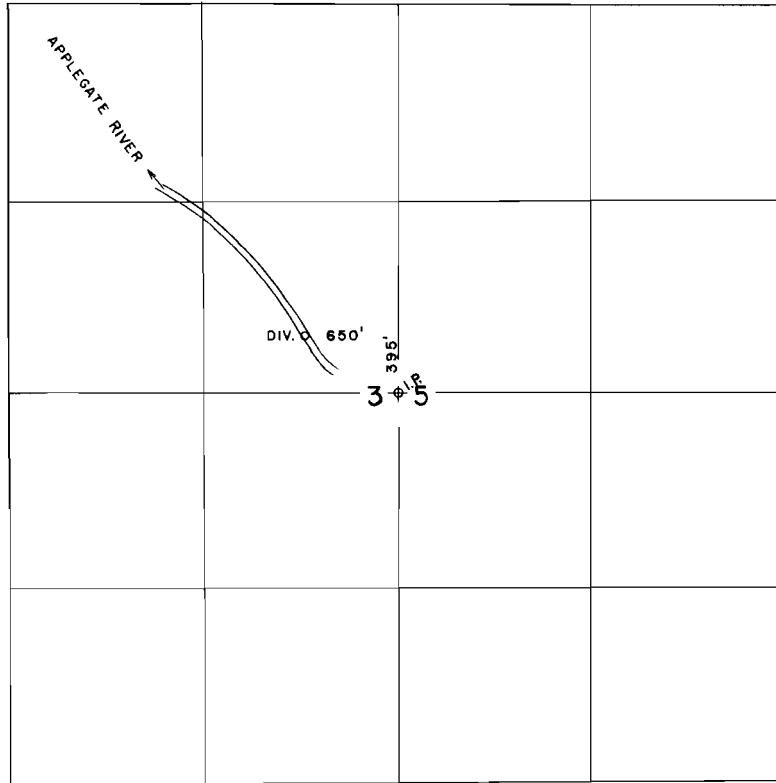

FINAL PROOF SURVEY UNDER

Application No. _____ TRANS. Permit No. 2386

IN NAME OF

CLARENCE W. RUCH

Surveyed NOV. 8 1972, by R. B. STEIMER.