


T5 & 6S. RIE. WM.

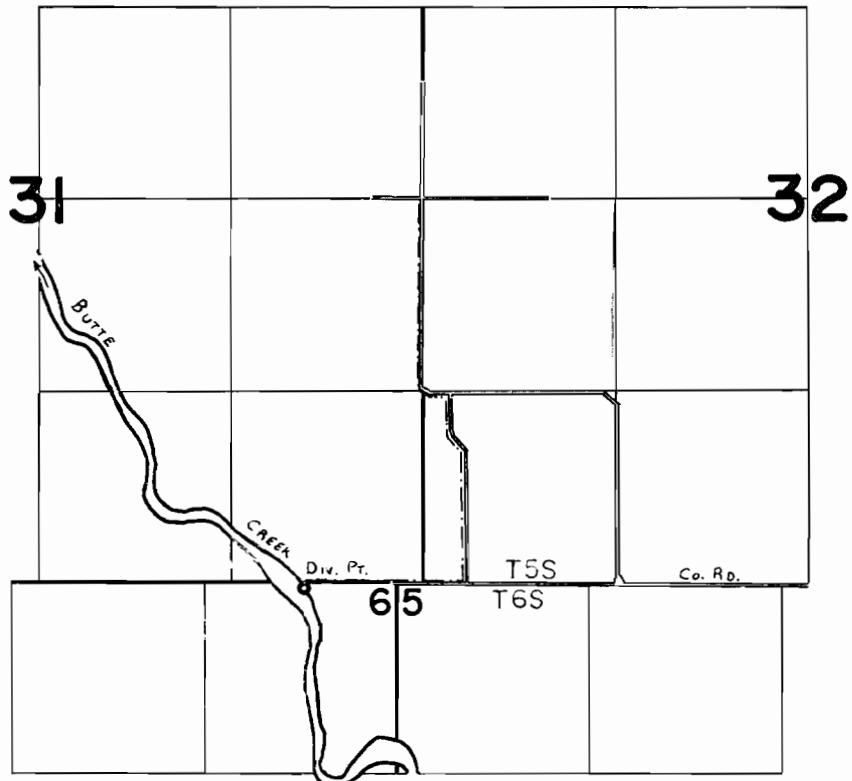

DIV. PT. LOC: 50' S. & 630' W. fr. N.E. COR. SEC. 6.

FINAL PROOF SURVEY UNDER

TRANSFER No. ^T2371 + ^F2392
Application No. _____ Permit No. _____
IN NAME OF

ROBERT A. ANDERSON

Surveyed AUG. 1, 1978, by C. L. HUGHES