T. 22S., R. 5 W. W.M.

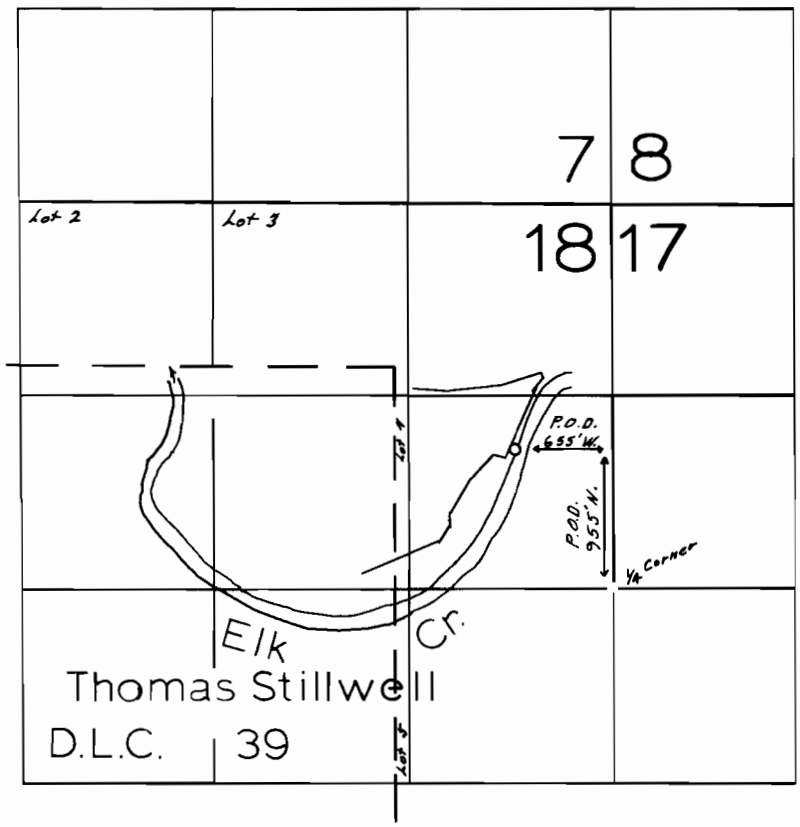

FINAL PROOF SURVEY
UNDER

T. 2395

Application No. 25093 Permit No. 19749

IN NAME OF

George Churchill

Surveyed 6-28 1971, by M.J. Youngquist

1971 drawing by E.P.C.