


T. 3 S., R. 44 E., W.M.

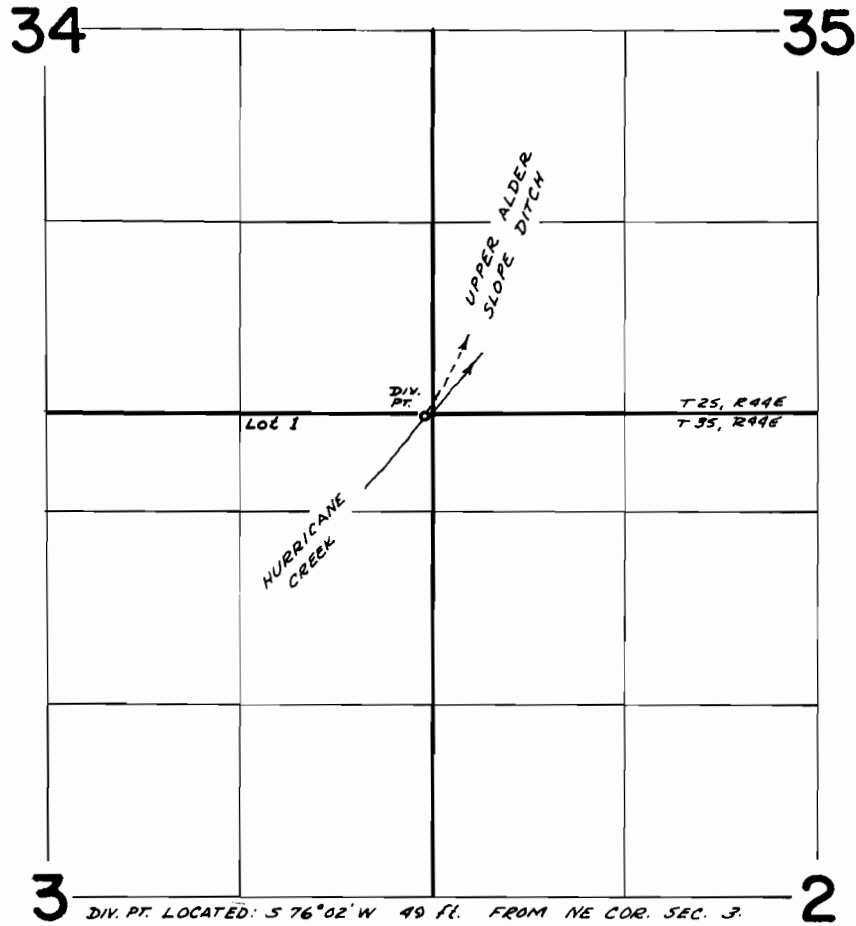

FINAL PROOF SURVEY
UNDER

Transfer Nos. 2350, 2380, 2381, 2399

Application No. Permit No.

IN NAME OF

PINE TREE PIPELINE ASSOC.

Surveyed June 27, 1972, by L. E. Gould